


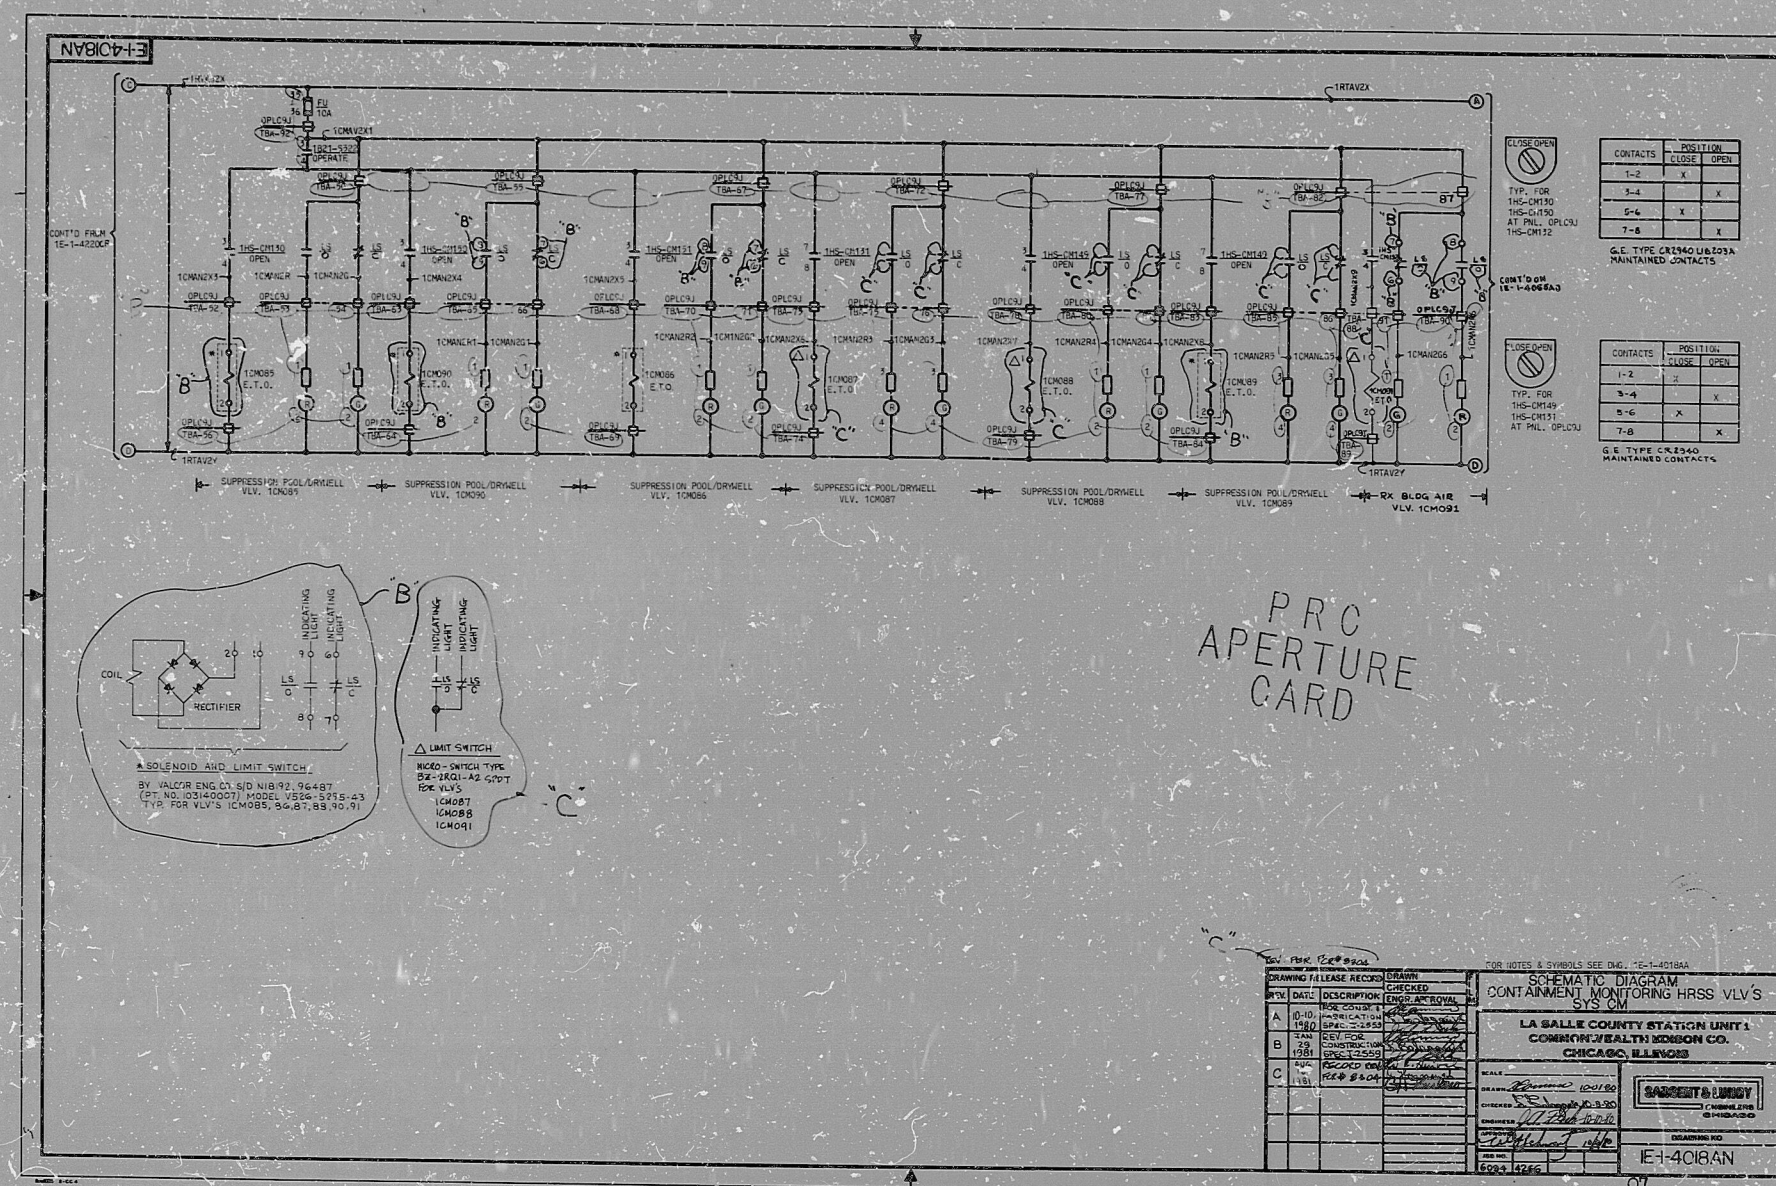

PRC
APERTURE
CARD

RIDS

8306230627

