


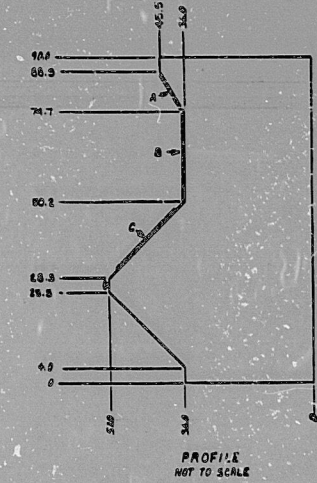

NOTES :

1. SYMBOL  INDICATES CHANGES WHICH REQUIRE FIELD MODIFICATION.

2. SYMBOL  INDICATES CHANGES WHICH REQUIRE FIELD MODIFICATION.

TERA
APERTURE
CARD

DELETED

[illegible]

R10S-PDR

DDAINT

NRCA ANP6F HA ϕ 45

" " IB ϕ 45

" " IB ϕ 22

8103050625

