
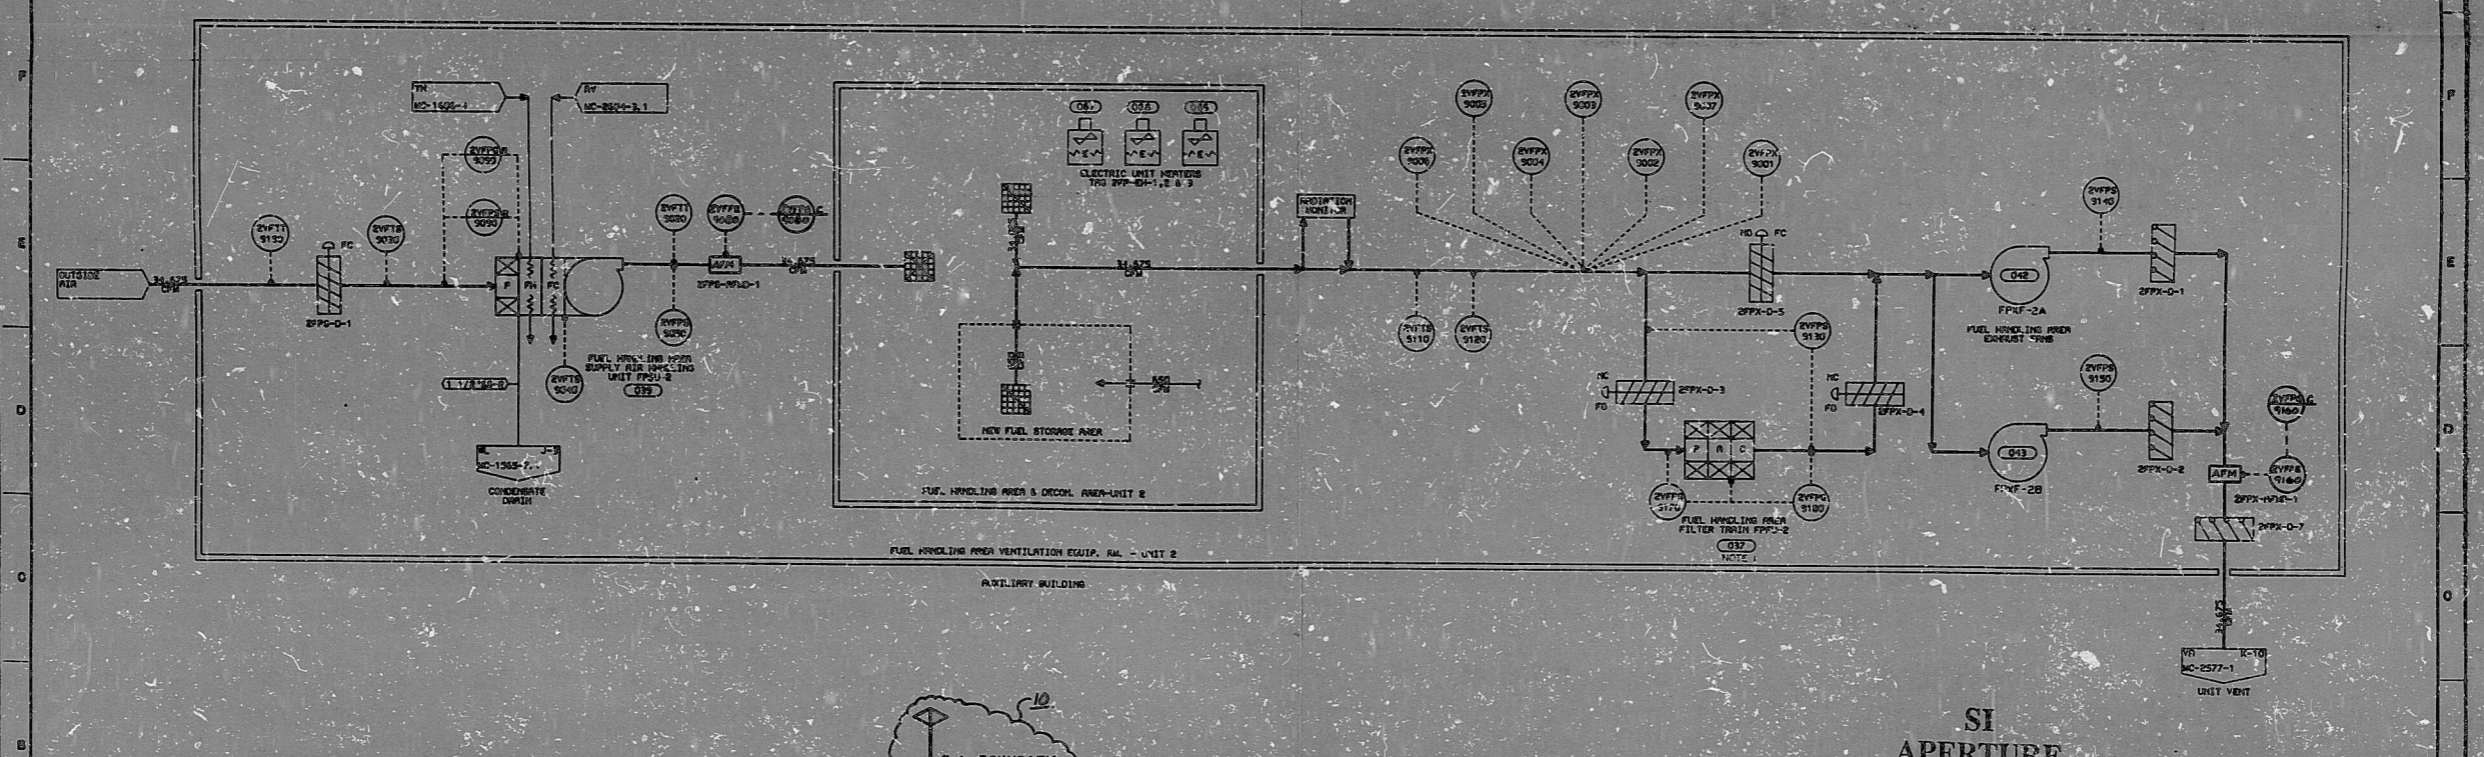


1 2 3 4 5 6 7 8 9 10 11 12 13 14

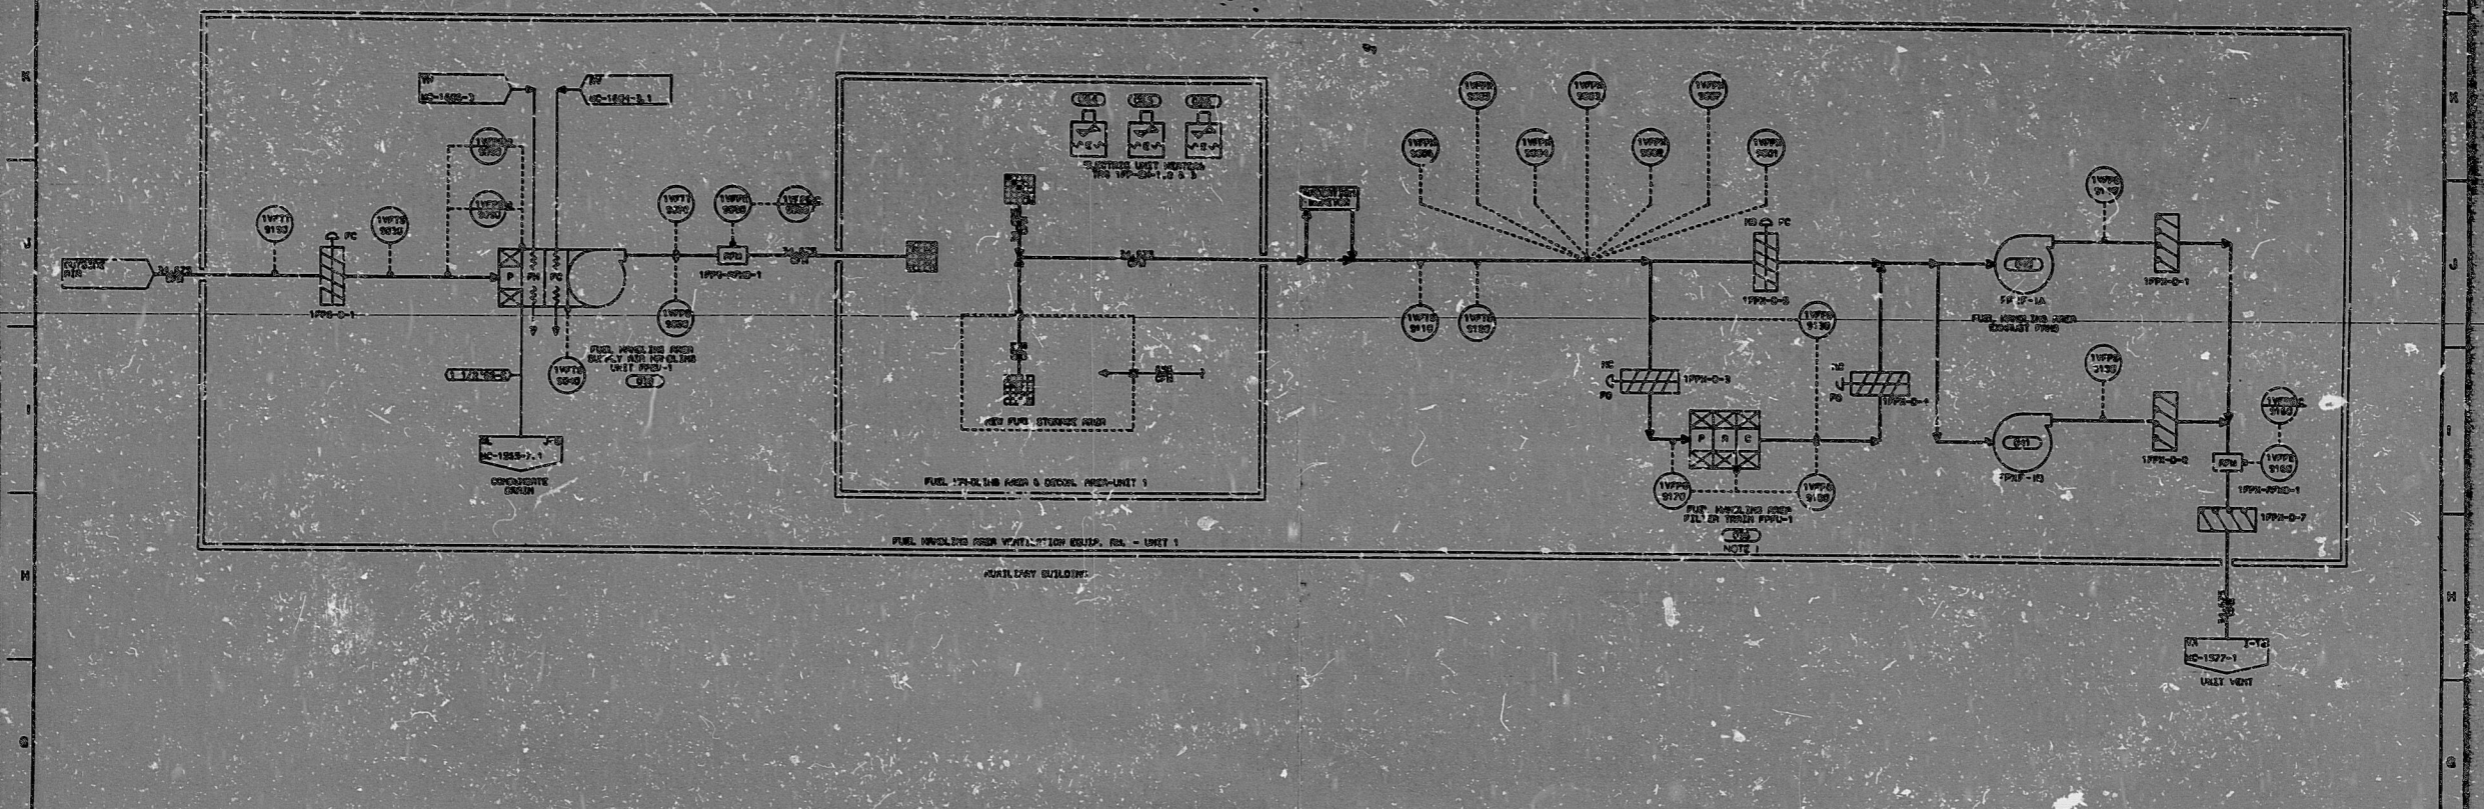

NOTES:
 1. FOR GRAPHS SEE DWG. MC-1557-4.2.
 2. IF A S.A. BOUNDARY IS NOT SHOWN, COMPONENT IS NON-S.A.

SI
 APERTURE
 CARD

ORDERED FOR PRESSURE BOUNDARY TEST-REV. 4-1557-3-1-77

NO.	REV.	PER	DATE	DESCRIPTION
9	REV. PER INFO. UPDATE			

DURE POWER COMPANY
 INCLUDES INCLUDE SYSTEM UNITS 1-12
 P.L.C. SYSTEM OF
 FUEL HANDLING BUILDINGS
 VENTILATION SYSTEM 5173

NO.	REV.	PER	DATE	DESCRIPTION
10	REV. PER S.A. BOUND.			

1 2 3 4 5 6 7 8 9 10 11 12 13 14

9008030020

PDR RIDS

