


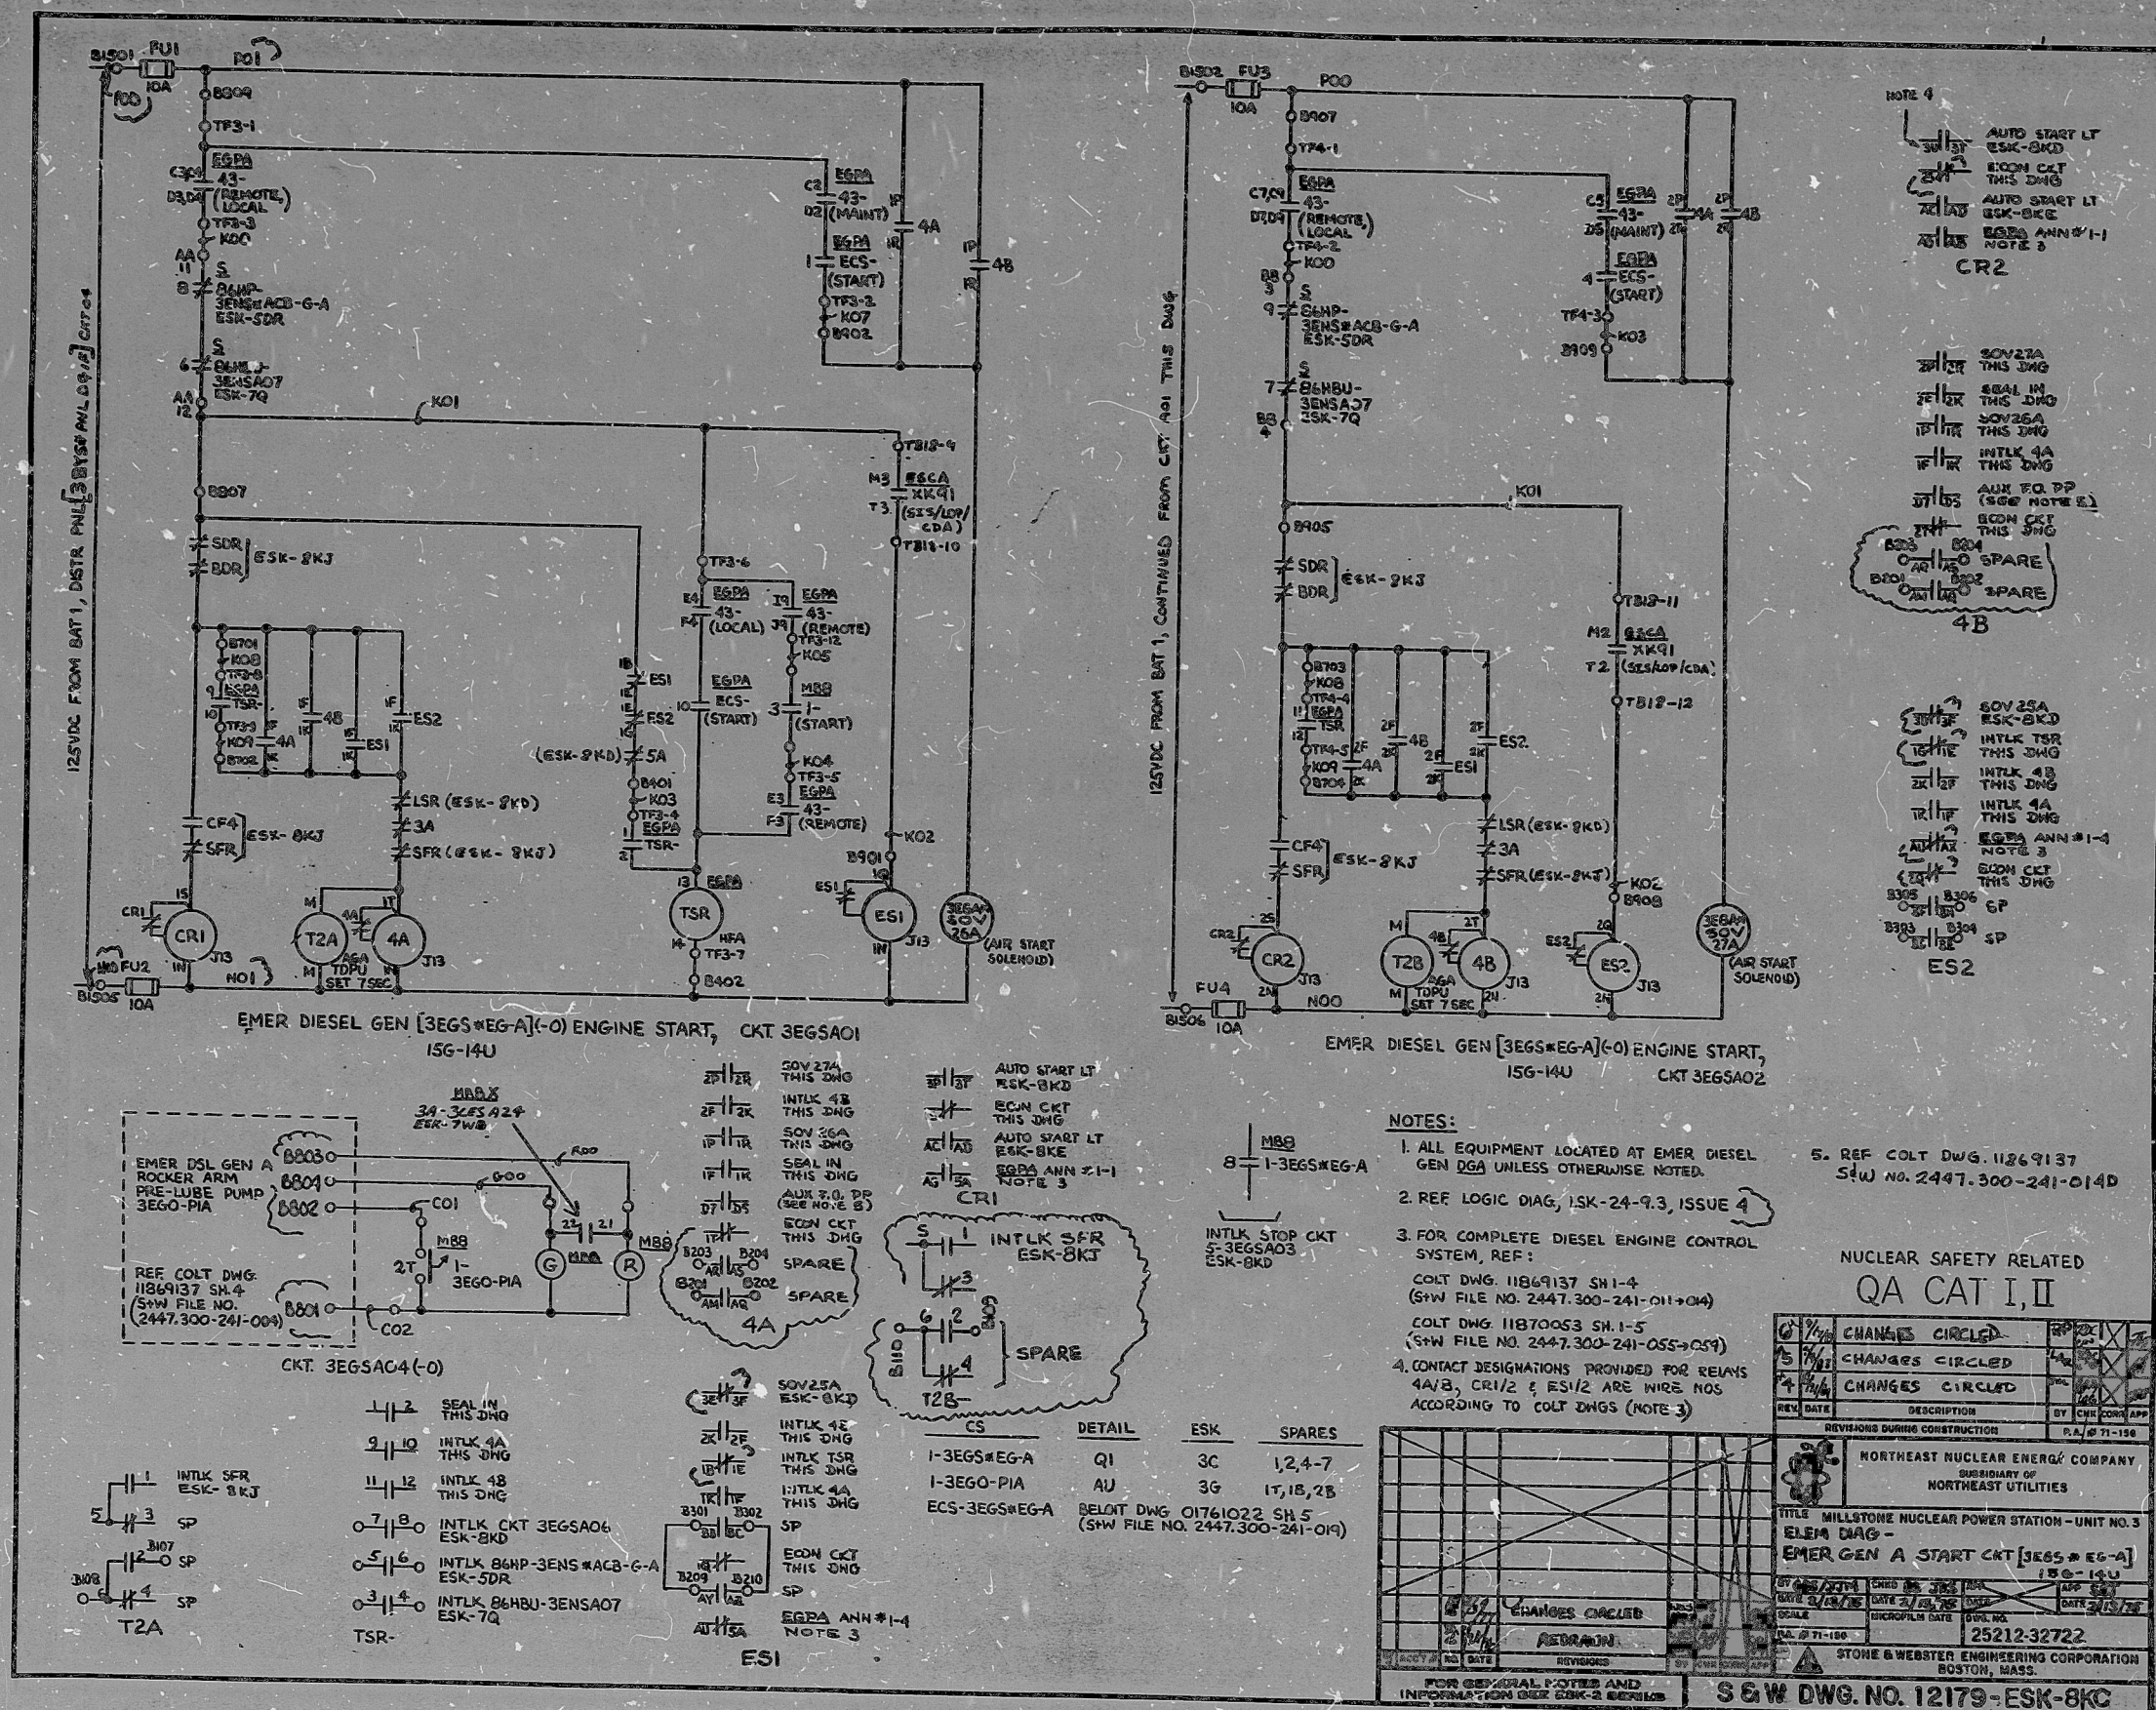

PDR RIDS

8504120263

