



1111-S0N
 100 1411 0 1A1
 66-50-21 311G
 10000 01 111

IVR13A COCS CUBICLE B COOLING COIL K-2902
 IVR10A COCS CUBICLE A COOLING COIL K-2902
 IVR12S COCS CUBICLE B COIL CABINET K-2902
 IVR05S COCS CUBICLE A COIL CABINET K-2902
 IVR11C COCS CUBICLE B SUPPLY FAN K-2904
 IVR08C COCS CUBICLE A SUPPLY FAN K-2904

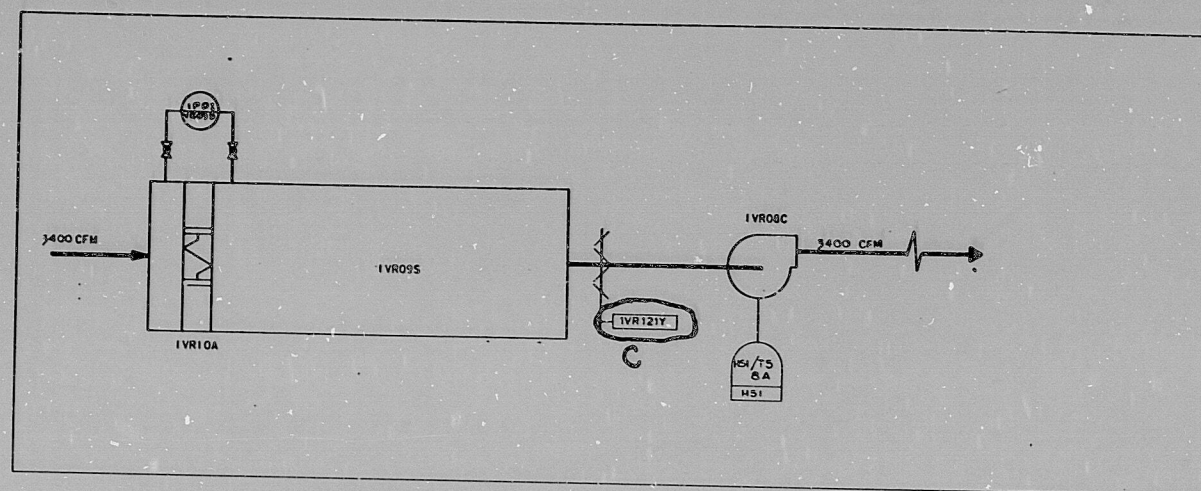

COMBUSTIBLE GAS CONTROL SYSTEM CUBICLE A EL. 803'-3"

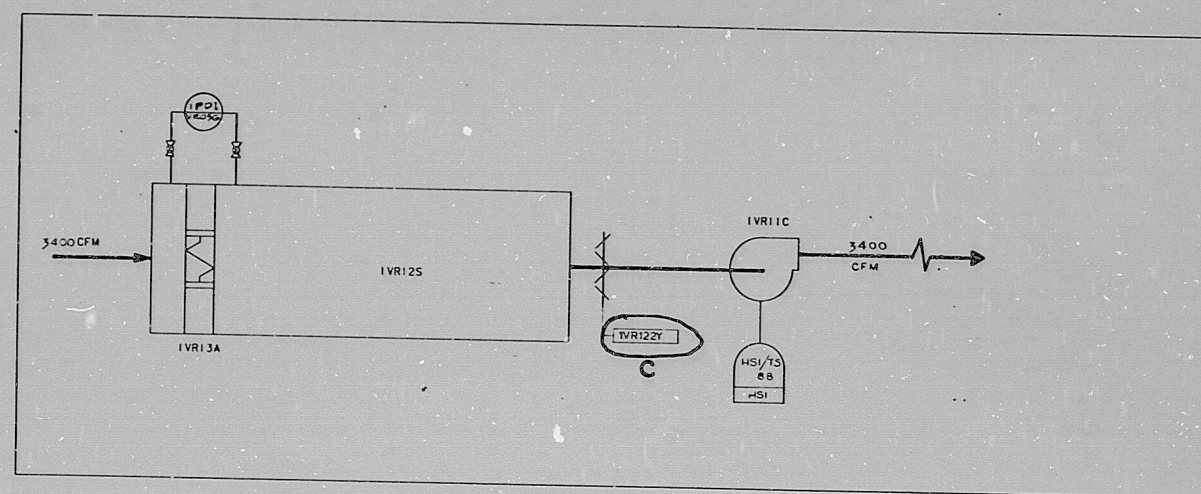


COMBUSTIBLE GAS CONTROL SYSTEM CUBICLE B EL. 778'-0"

PRC
 APERTURE
 CARD

NUCLEAR SAFETY RELATED
 ITEMS ARE SHOWN ON THIS DRAWING
 FOR SAFETY CLASSIFICATION SEE PIPING,
 EQUIPMENT, VALVE OR INSTRUMENT LISTS.

REV	DATE	FIELD	PREPARED	REVIEWED	APPROVED	PURPOSE	PLM	REV	DATE	FIELD	PREPARED	REVIEWED	APPROVED	PURPOSE	PLM
A	1-18-74					FOR FABRICATION AND CONSTRUCTION SPEC NO K-2902									
B	11-21-80					REVISED CFM AND CIL SYMBOLS, SEE 113 E-13-110									
C	12-10-81					CHANGED DAMPER NOS AS NOTED SPEC NO K-2902									

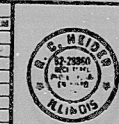

SCALE
 NONE
 PROJECT
 NUMBER
 4536
 P&ID COCS EQUIPMENT
 ROOM COOLING (VR)
 CLINTON POWER STATION
 UNIT 1
 ILLINOIS POWER COMPANY
 CLINTON, ILLINOIS

SARGENT & LUNDY
 CHICAGO
 DRAWING NO
 M05-1111
 SHEET 4 OF 4

RIDS

8204200171

