



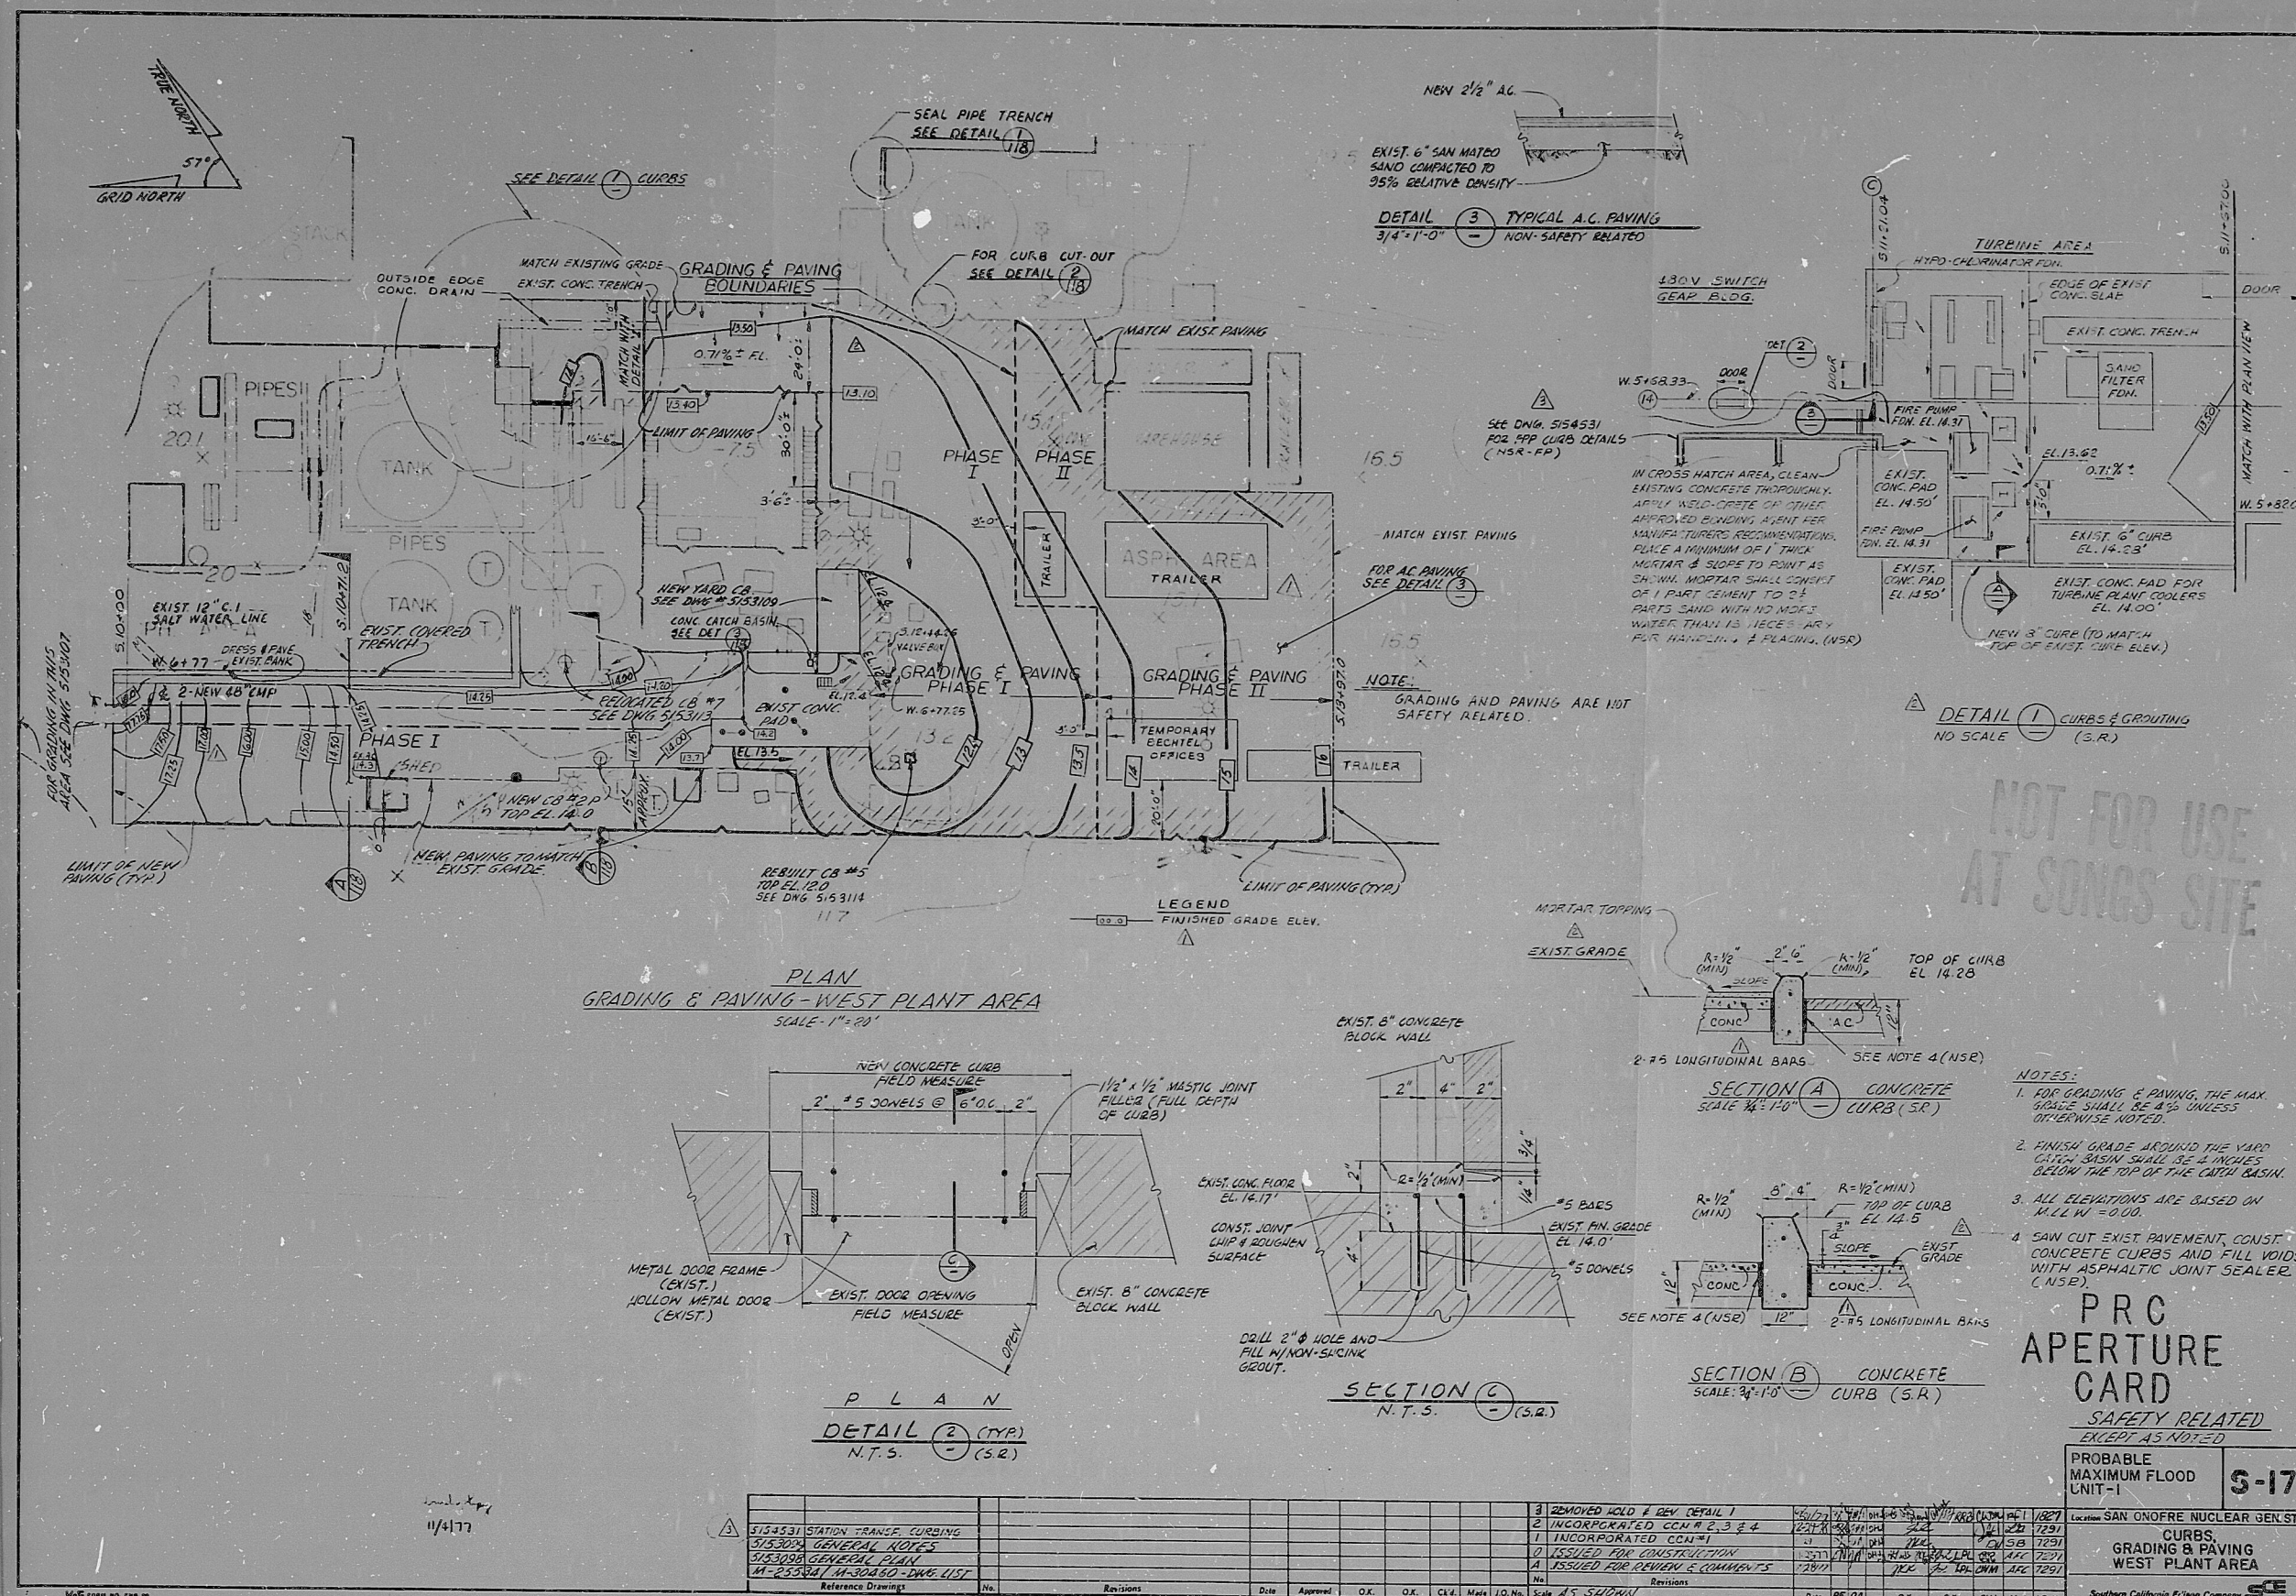

5153116-3

8204200217

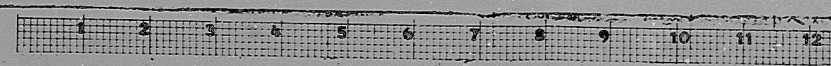

26X

MICROFILMED FROM
BEST AVAILABLE COPY

RIDS

8204200217

