


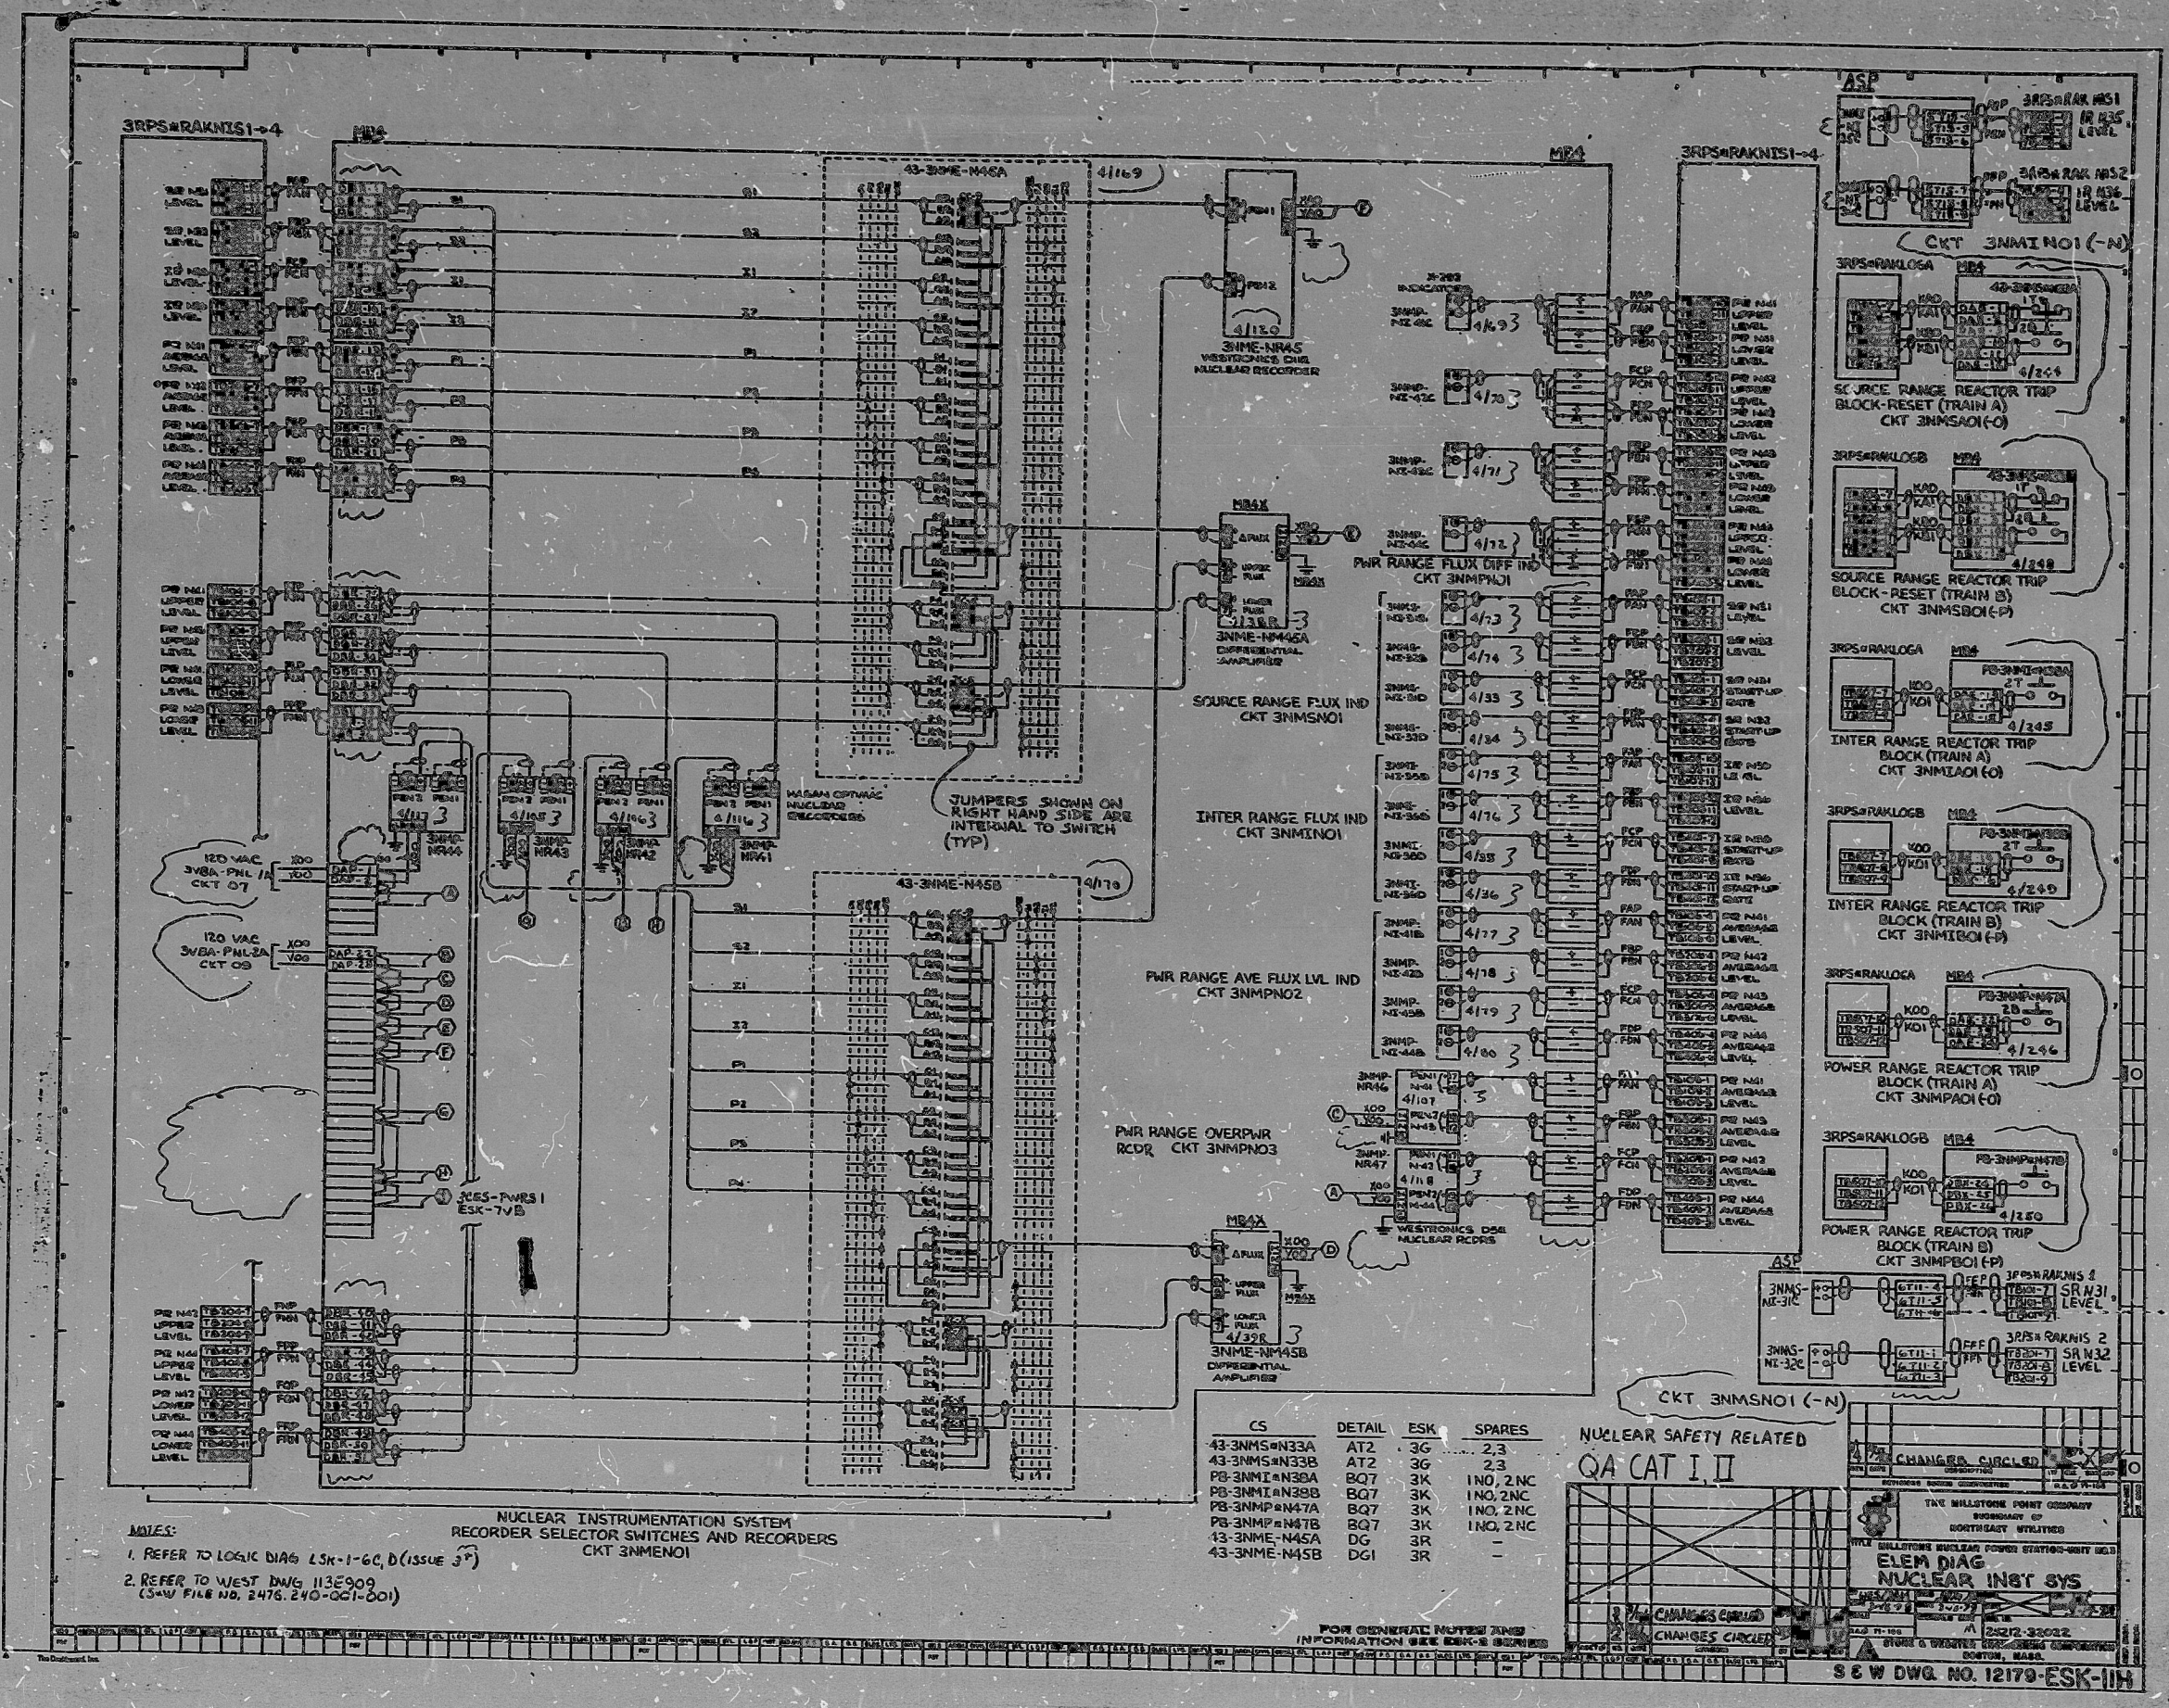

NOTES:
1. REFER TO LOGIC DIAG LSN-1-60, D (ISSUE 3)
2. REFER TO WEST DWG 113E909
(S-W FILE NO. 2476.240-001-001)

NUCLEAR INSTRUMENTATION SYSTEM
RECORDER SELECTOR SWITCHES AND RECORDERS
CKT 3NME01

CS	DETAIL	ESK	SPARES
43-3NMS-N33A	AT2	3G	2,3
43-3NMS-N33B	AT2	3G	2,3
PS-3NMI-N30A	BQ7	3K	1NO, 2NC
PS-3NMI-N30B	BQ7	3K	1NO, 2NC
PS-3NMP-N47A	BQ7	3K	1NO, 2NC
PS-3NMP-N47B	BQ7	3K	1NO, 2NC
43-3NME-N45A	DG	3R	-
43-3NME-N45B	DG1	3R	-

NUCLEAR SAFETY RELATED
QA CAT I, II

CHANGES CIRCLED

DATE: 12/12/60
BY: [Signature]
FOR: [Signature]

CHANGES CIRCLED

DATE: 12/12/60
BY: [Signature]
FOR: [Signature]

SEW DWG. NO. 12179-ESK-11H

TI
APERTURE
CARD

PDR RIDS

8504120309

