


MPL NO 1H13-2715J

NOTES:
1. CHANGES WHICH REQUIRE FIELD MODIFICATION ARE INDICATED BY Δ

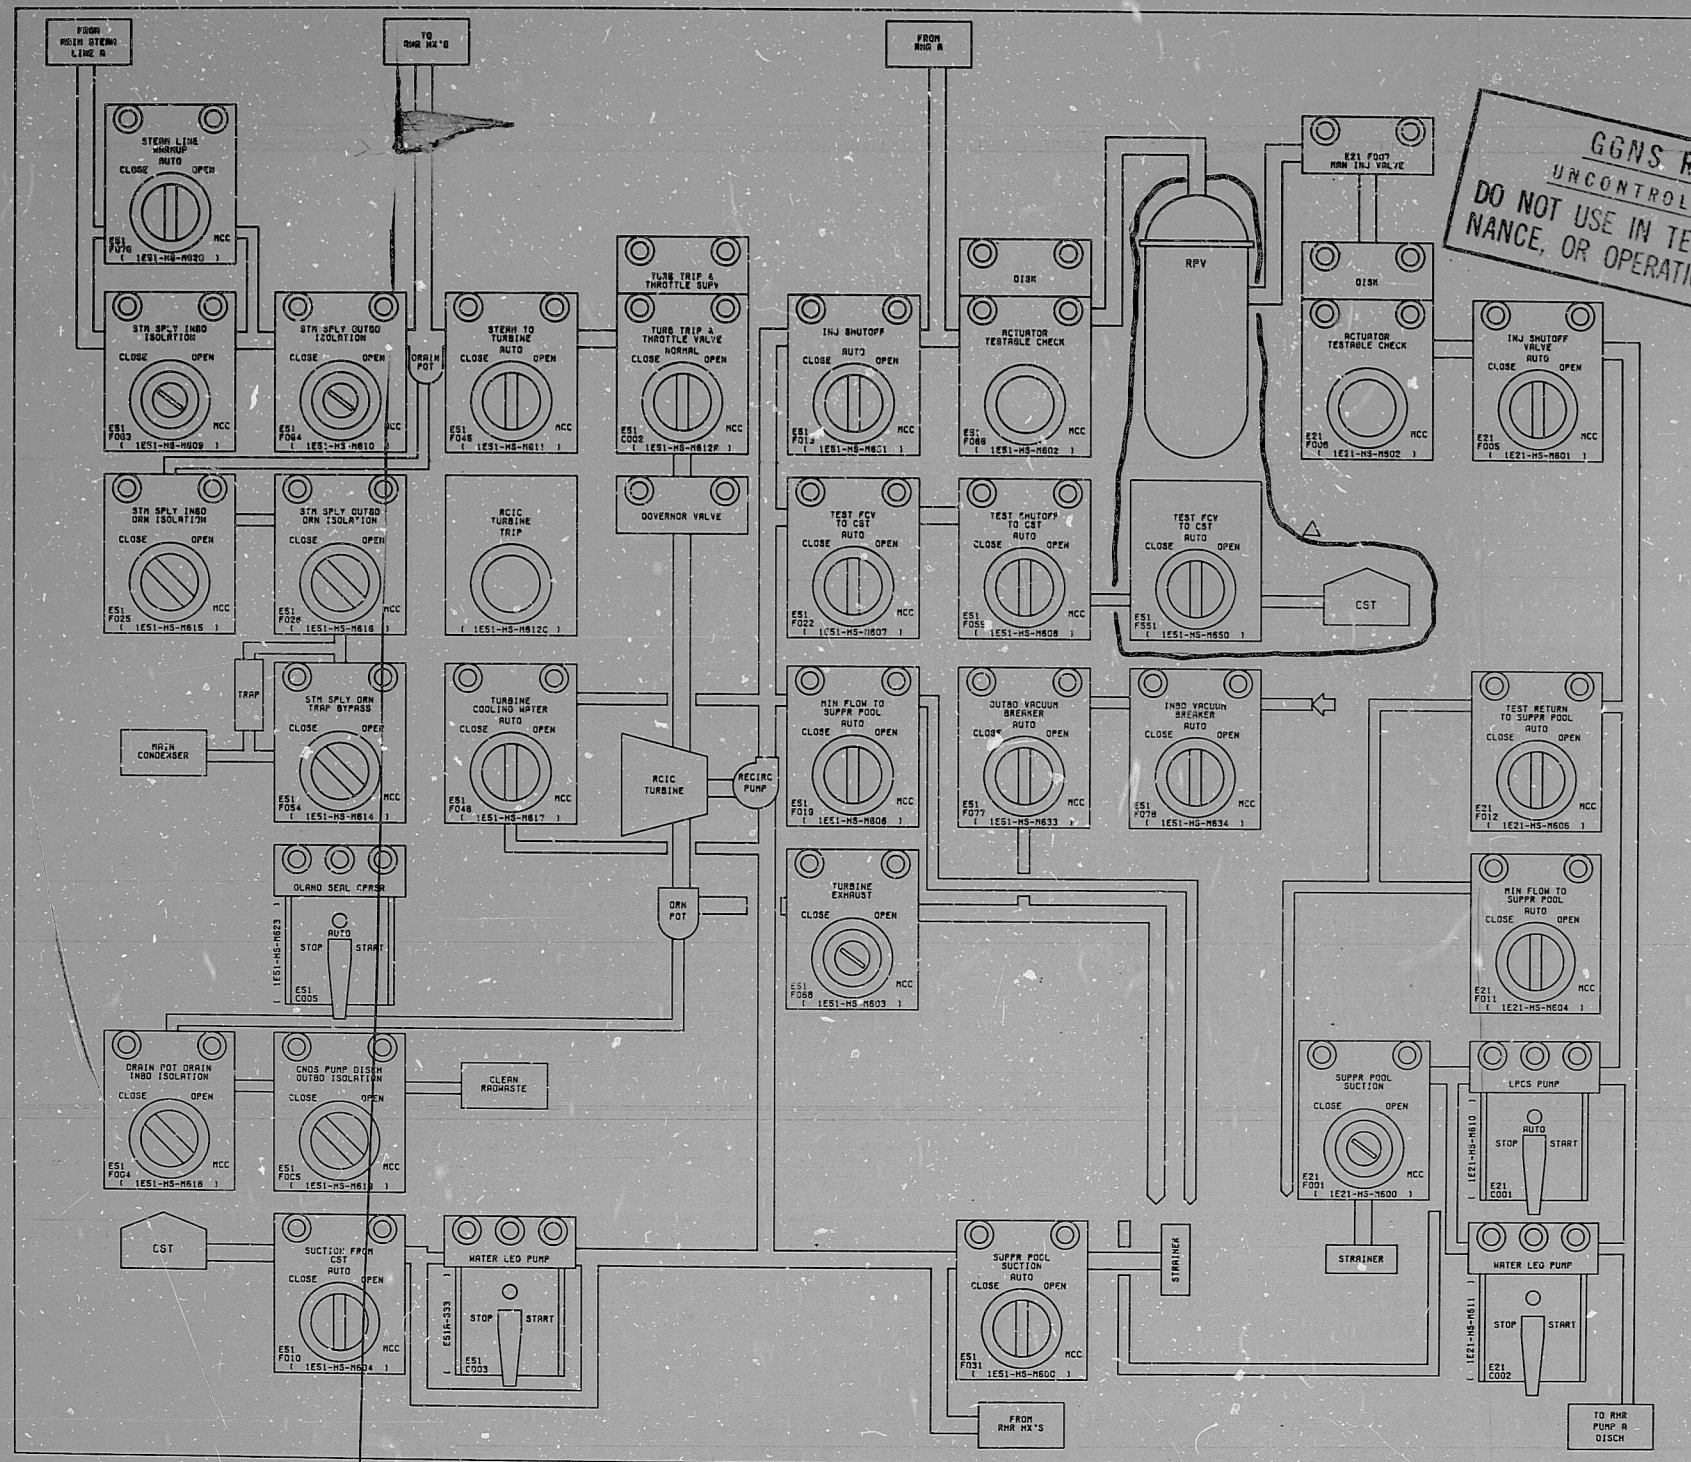

GGNS RECORDS
UNCONTROLLED COPY
DO NOT USE IN TESTING, MAINTENANCE, OR OPERATIONAL ACTIVITY.

TERA
APERTURE
CARD

REVISIONS			
NO	DATE	BY	CHK
1	08/21/80	DR	DR
SCALE: FULL			
BECHTEL			
GRITHE, SAURO, MARYLPO			
MISSISSIPPI POWER & LIGHT COMPANY			
GRAND GULF NUCLEAR STATION			
UNITS 1 & 2			
PANEL ARRANGEMENT			
REACTOR CORE COOLING BENCHBOARD			
1H13-P601-21C			
JOB NO	DRAWING NO	REV	
9645-	J-1471J	0	

MPL NO 1H13-2715J

I certify that the data contained on this form was made in the normal and proper course of business, on the date stated below and that it is an accurate reproduction of the document(s) submitted to me for reproduction.

30X

8.5"

11"

17"

RIDS-PDR

8103060241

DDAINT

NRCIA ANP6F IB $\phi 45$

" " IB $\phi 22$

" " CB $\phi 45$

