


SI
APERTURE
CARD

 

*9010220049

PDR RIDS

9010310236

