

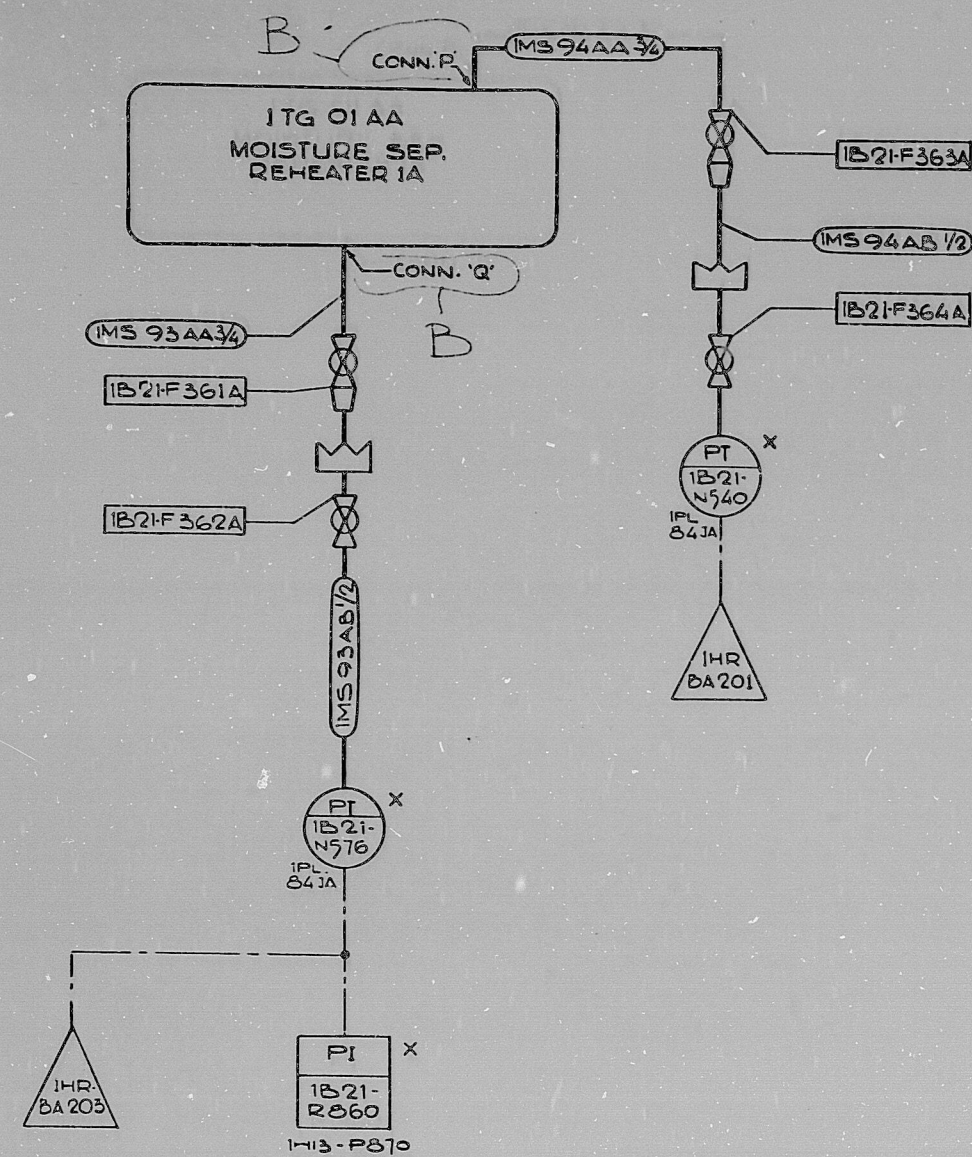


DIAGRAM 18 A
MOISTURE SEP. REHEATER
1 TG 01 AA

REF. DWGS. MO5-1002 SHT.3
& G.E. DWG. 792E 488 SHT.1
FOR PROCESS CONNECTIONS.


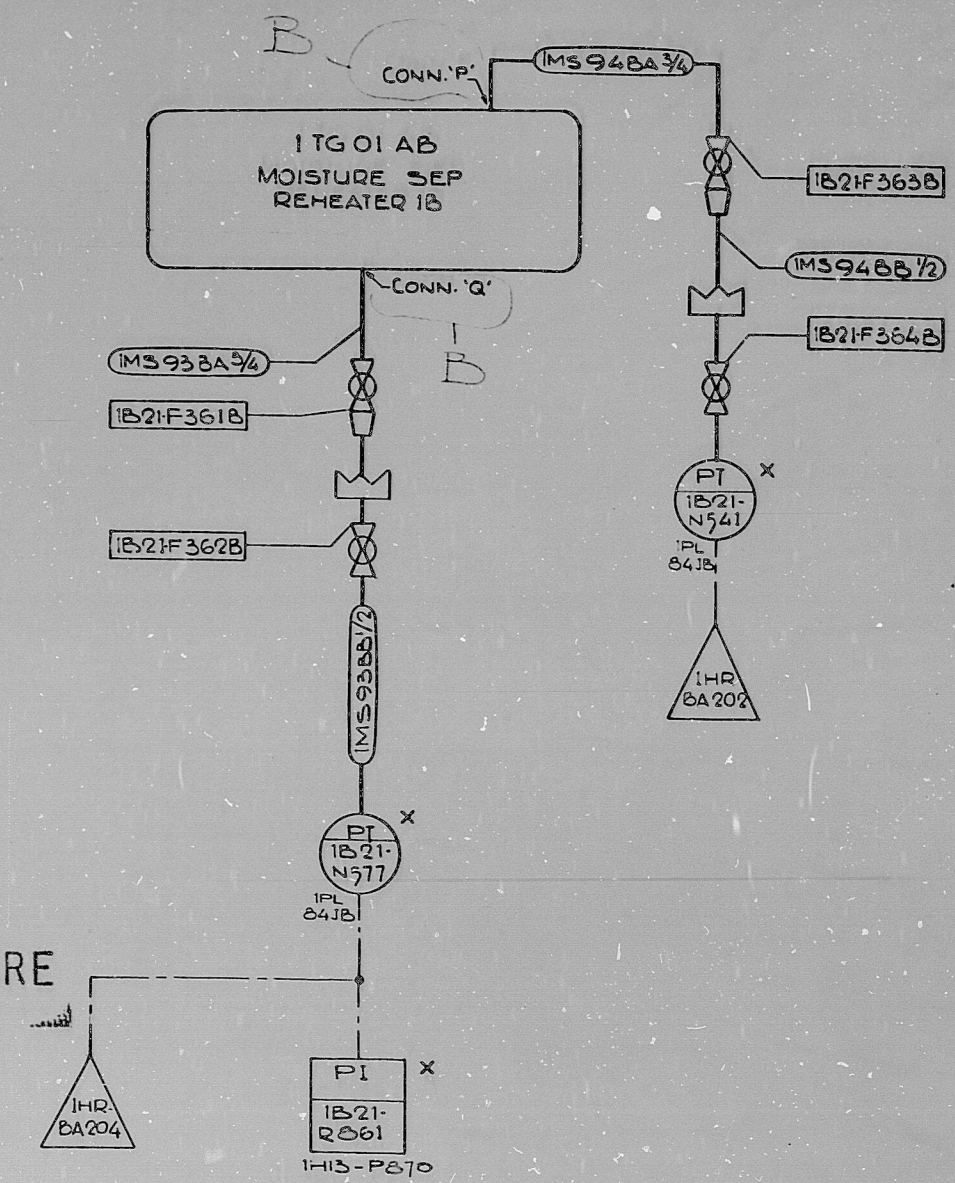


DIAGRAM 18 B
MOISTURE SEP. REHEATER
1 TG 01 AB

PRC
APERTURE
CARD

DRAWING RELEASE RECORD					
REV.	SPEC. NO.	DATE	PREPARED	REVIEWED	PURPOSE
A		2-23-79	J. J. Doherty	R. C. Heider	FOR CONSTRUCTION, SPEC. K-2915
A		11-12-79	J. J. Doherty	R. C. Heider	FOR CONSTRUCTION, SPEC. K-2882
B		03-09-81	J. J. Doherty	R. C. Heider	REVISED FOR CONSTRUCTION, SPEC. K-2832

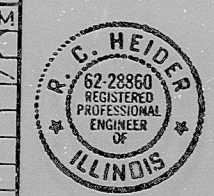

SCALE NONE	P&ID/C&I DIAGRAM MAIN STEAM SYSTEM (MS) CLINTON POWER STATION UNIT 1 ILLINOIS POWER COMPANY CLINTON, ILLINOIS	 DRAWING NO. M10-1002 SHEET 18 OF 24
PROJECT NUMBER 4536		
REV. B		

DO NOT USE I, O, Q, OR X FOR REVISION

SEAL

RIDS

820422044

