


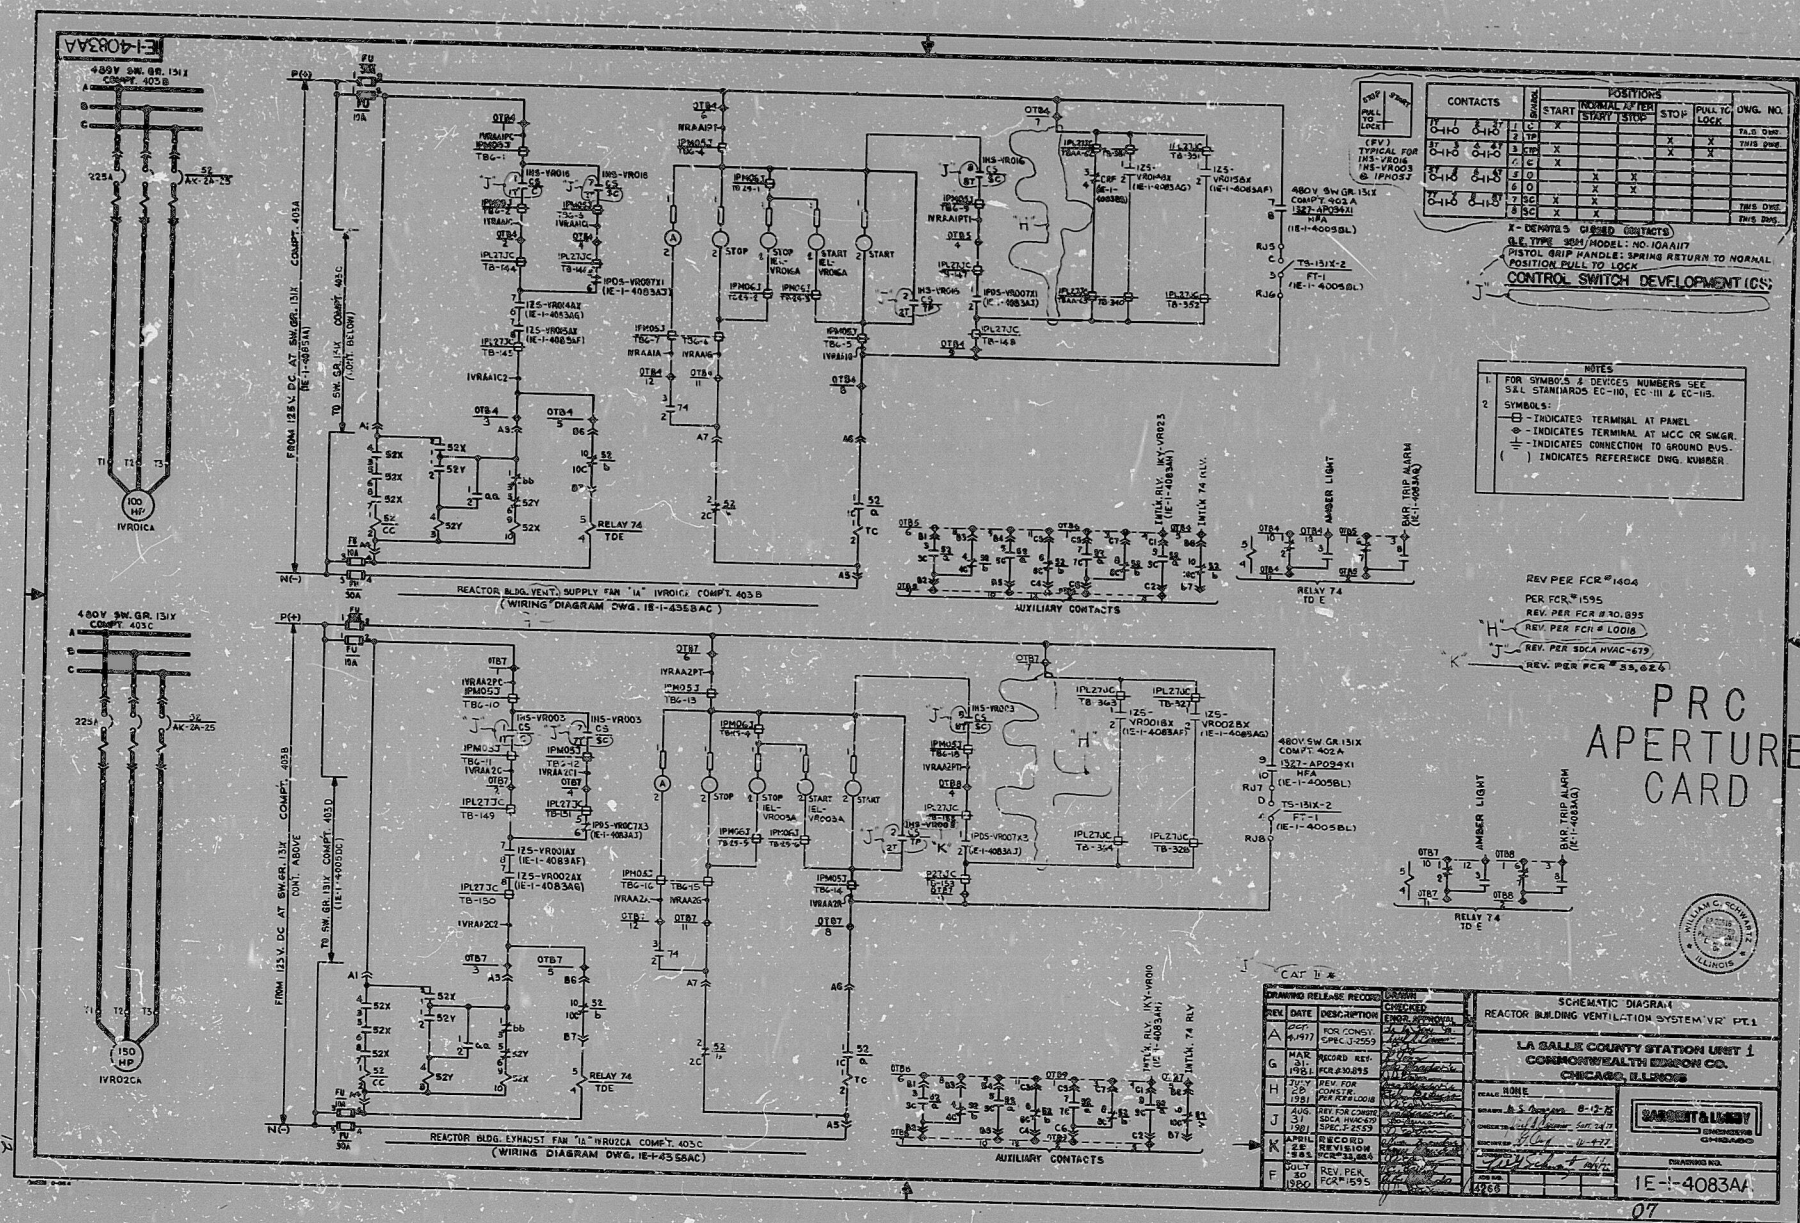

PRC
APERTURE
CARD



1E-4083A

07

RIDS

8308230843

