
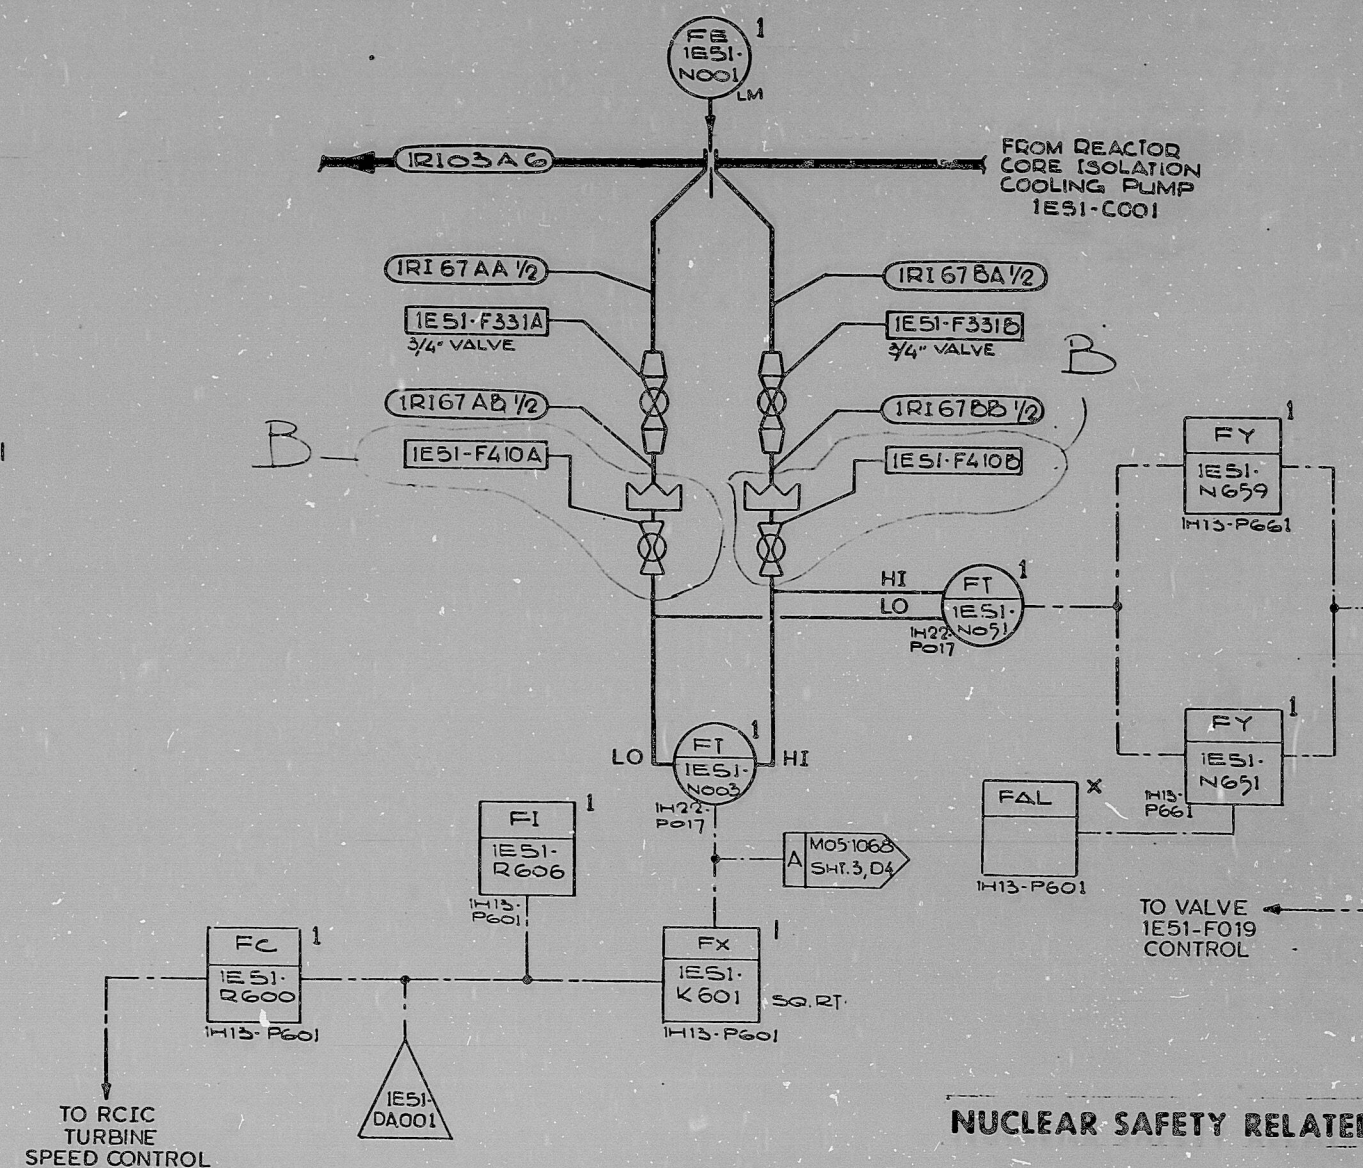
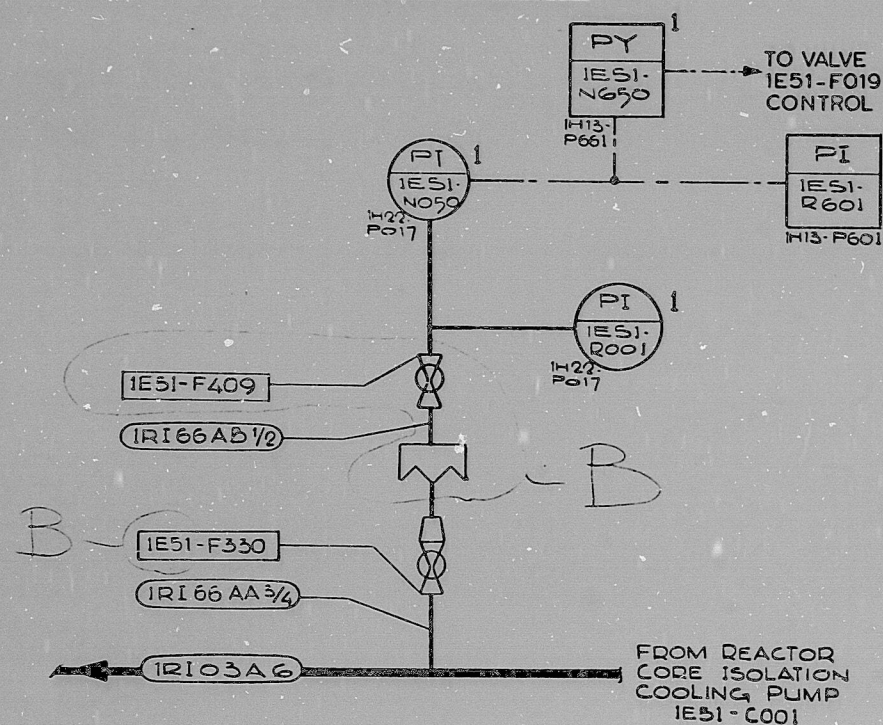


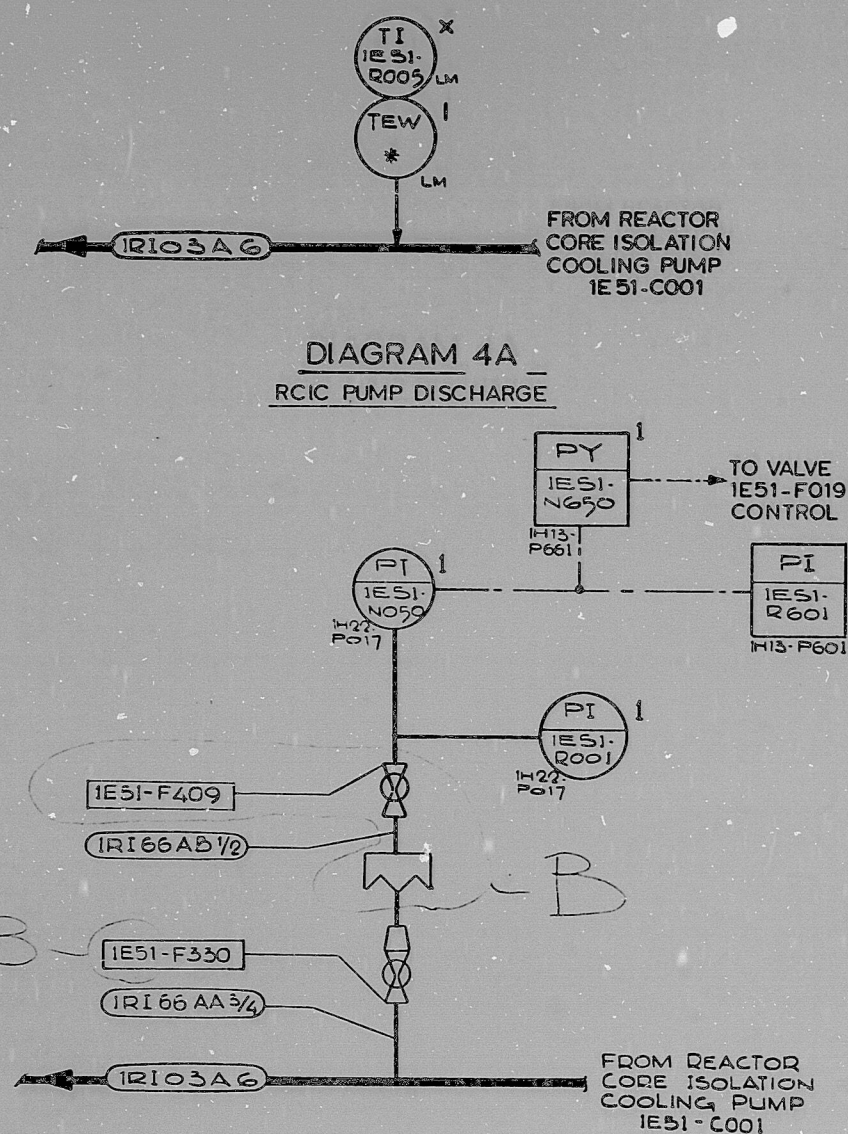

PRC
APERTURE
CARD

NUCLEAR SAFETY RELATED

(LAST ALPHA. NUMERIC. REV. WAS B1, DAT. 02-02-81)

(REF. DWG. MO5-1079-2)

(LAST ALPHA NUMERIC REV. WAS 81, DAT. 02-02-81)

DRAWING RELEASE RECORD						SCALE NONE PROJECT NUMBER 4536	P&ID/C&I DIAGRAM REACTOR CORE ISOLATION COOLING SYS. (R1) CLINTON POWER STATION UNIT 1 ILLINOIS POWER COMPANY CLINTON, ILLINOIS
REV.	DATE REL'D	PREPARED	REVIEWED	APPROVED	PURPOSE		
A	10-11-79	<i>W.D. Miller</i>	<i>R.D. Miller</i>	<i>R.C. Heiler</i>	FOR CONSTRUCTION, SPEC. K-2882	☒	
B	08-31-81	<i>W.D. Miller</i>	<i>R.D. Miller</i>	<i>R.C. Heiler</i>	REVISED FOR CONSTRUCTION, SPEC. K-2882	☒	



SARGENT & LUNDY
ENGINEERS
CHICAGO

FORM 008 2-81 (4)

DRAWING NO. RE
M10-1079 B
SHEET 4 OF 8

RIPS

8204210089

