


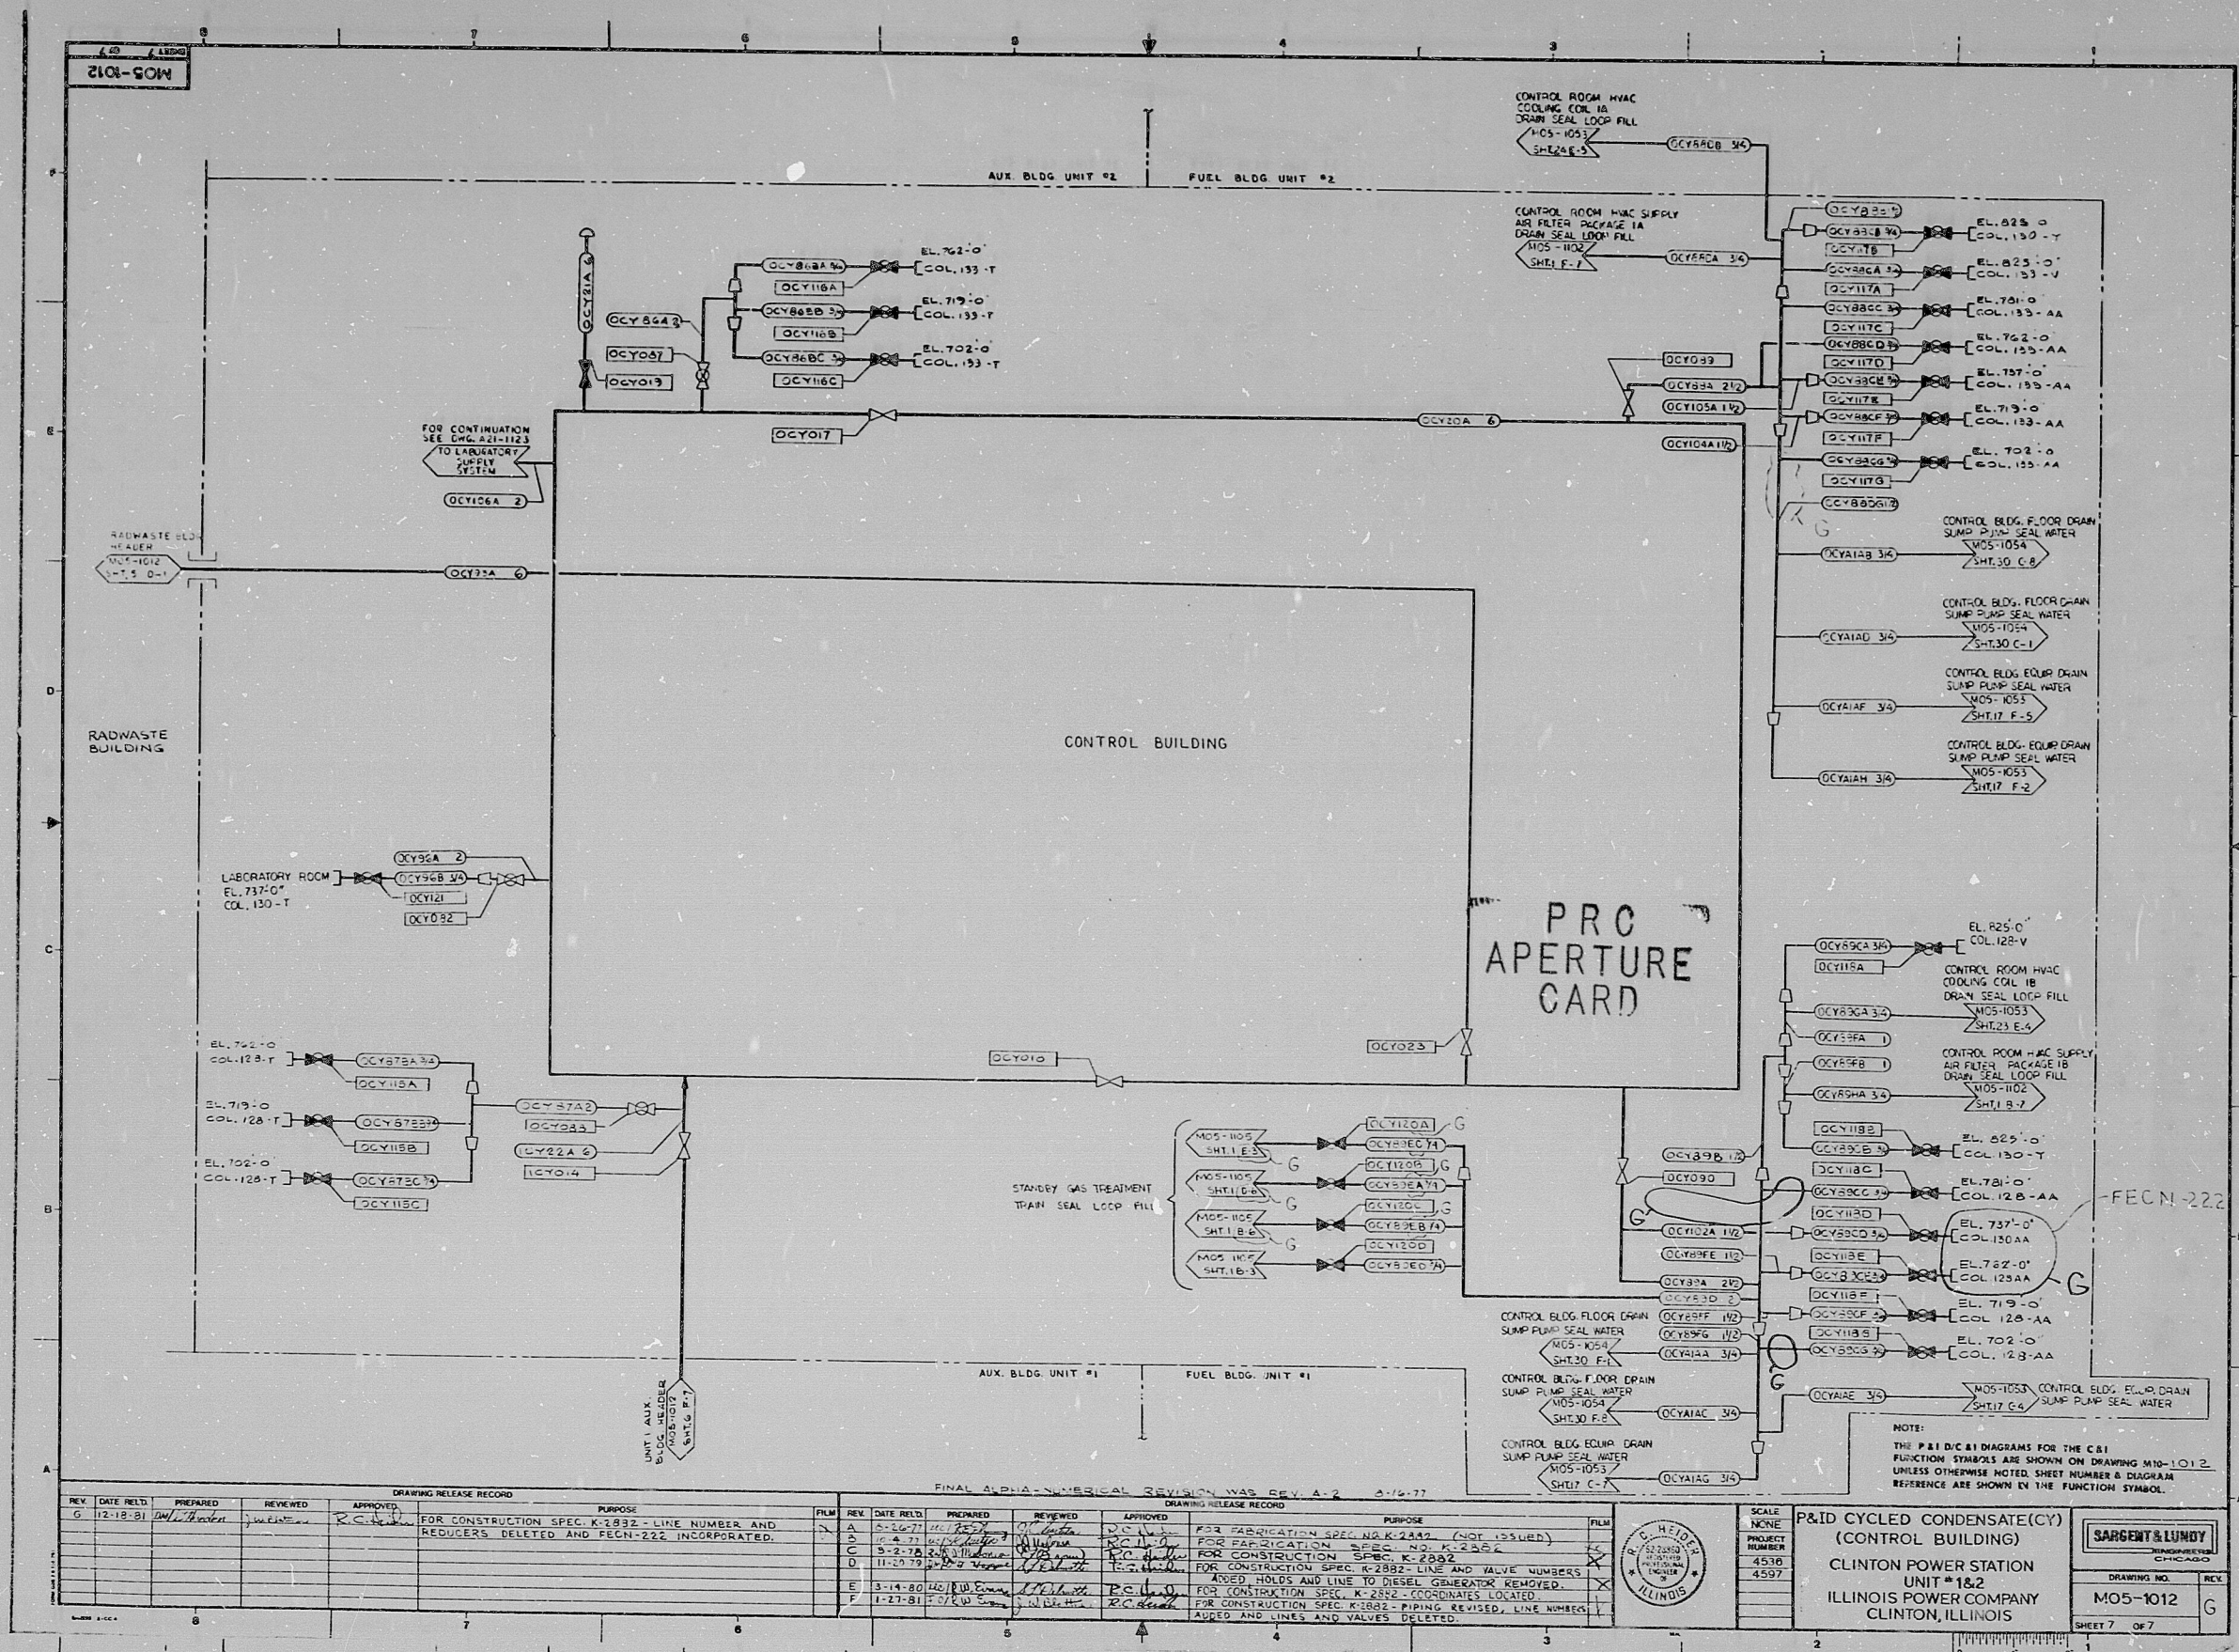

RIPS

8204210135

