


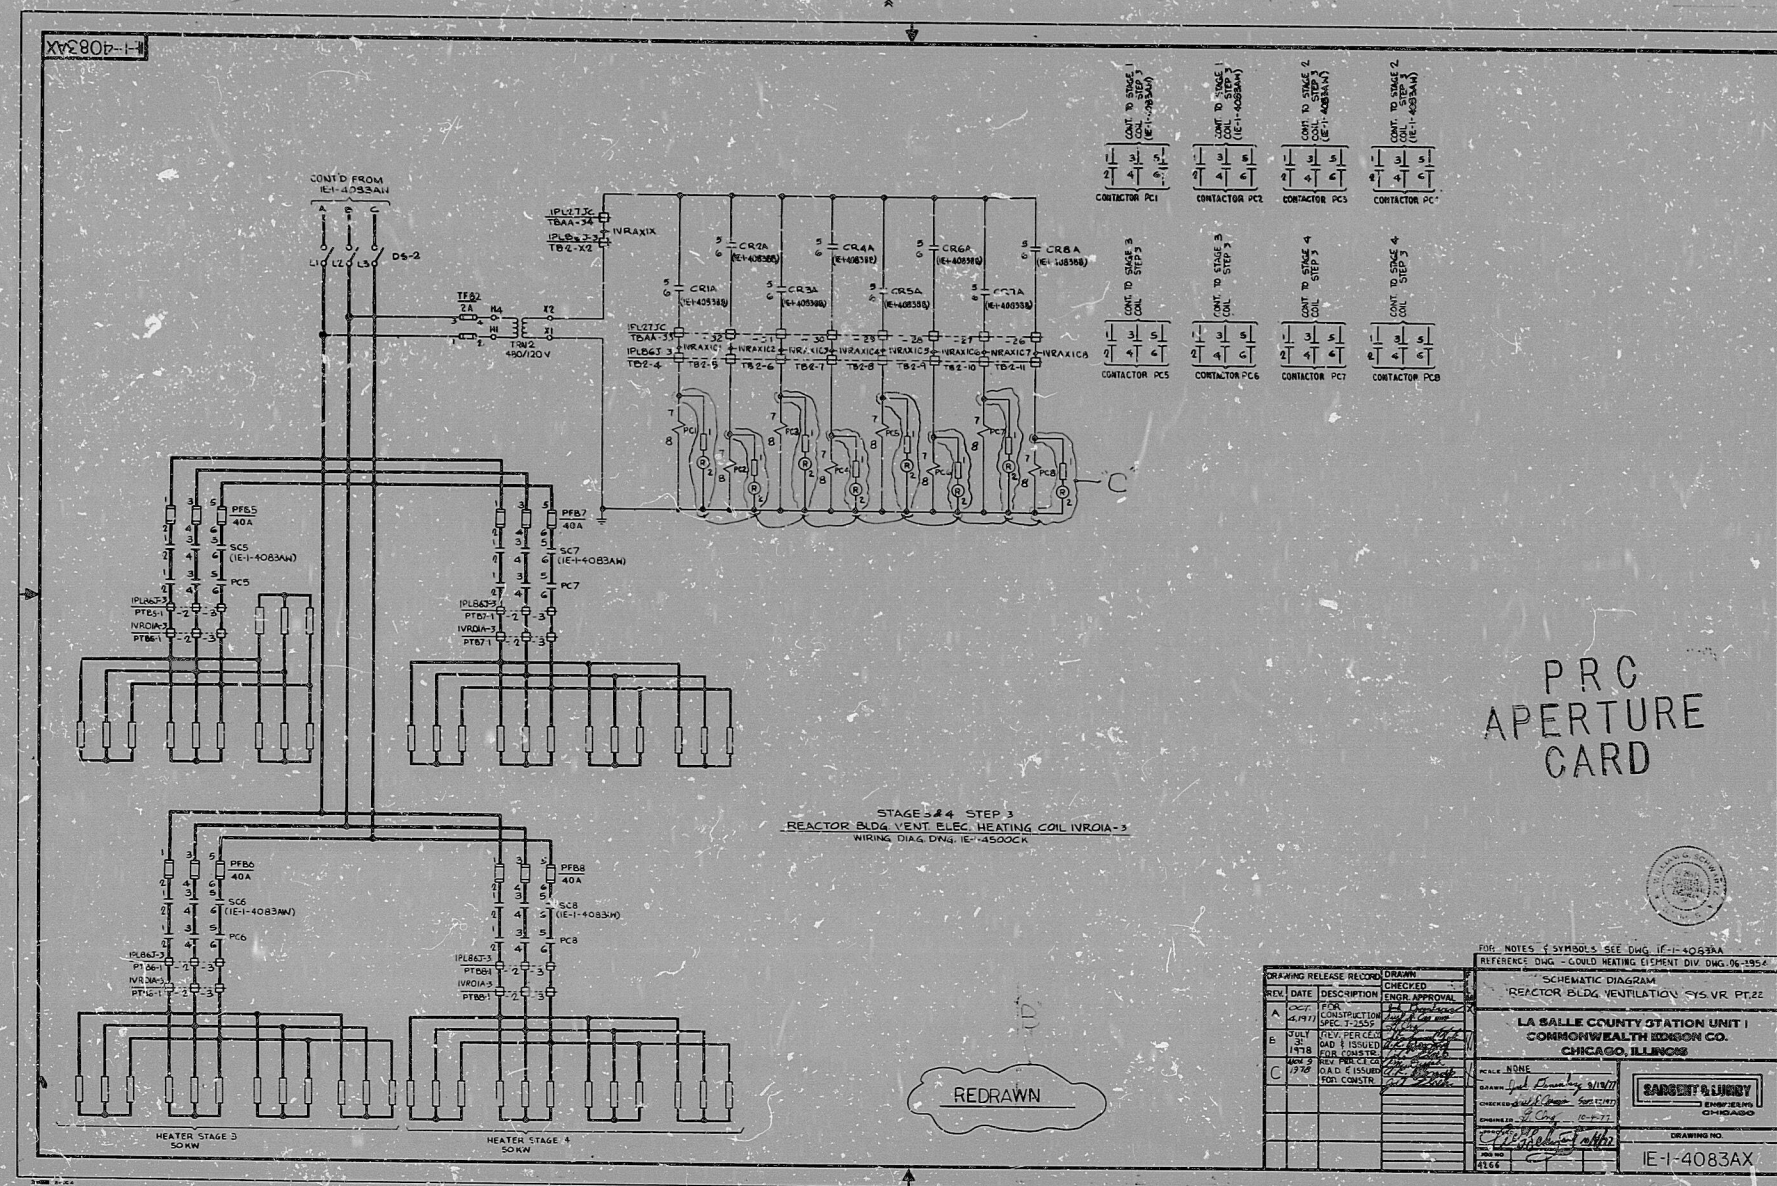

8308240088

