


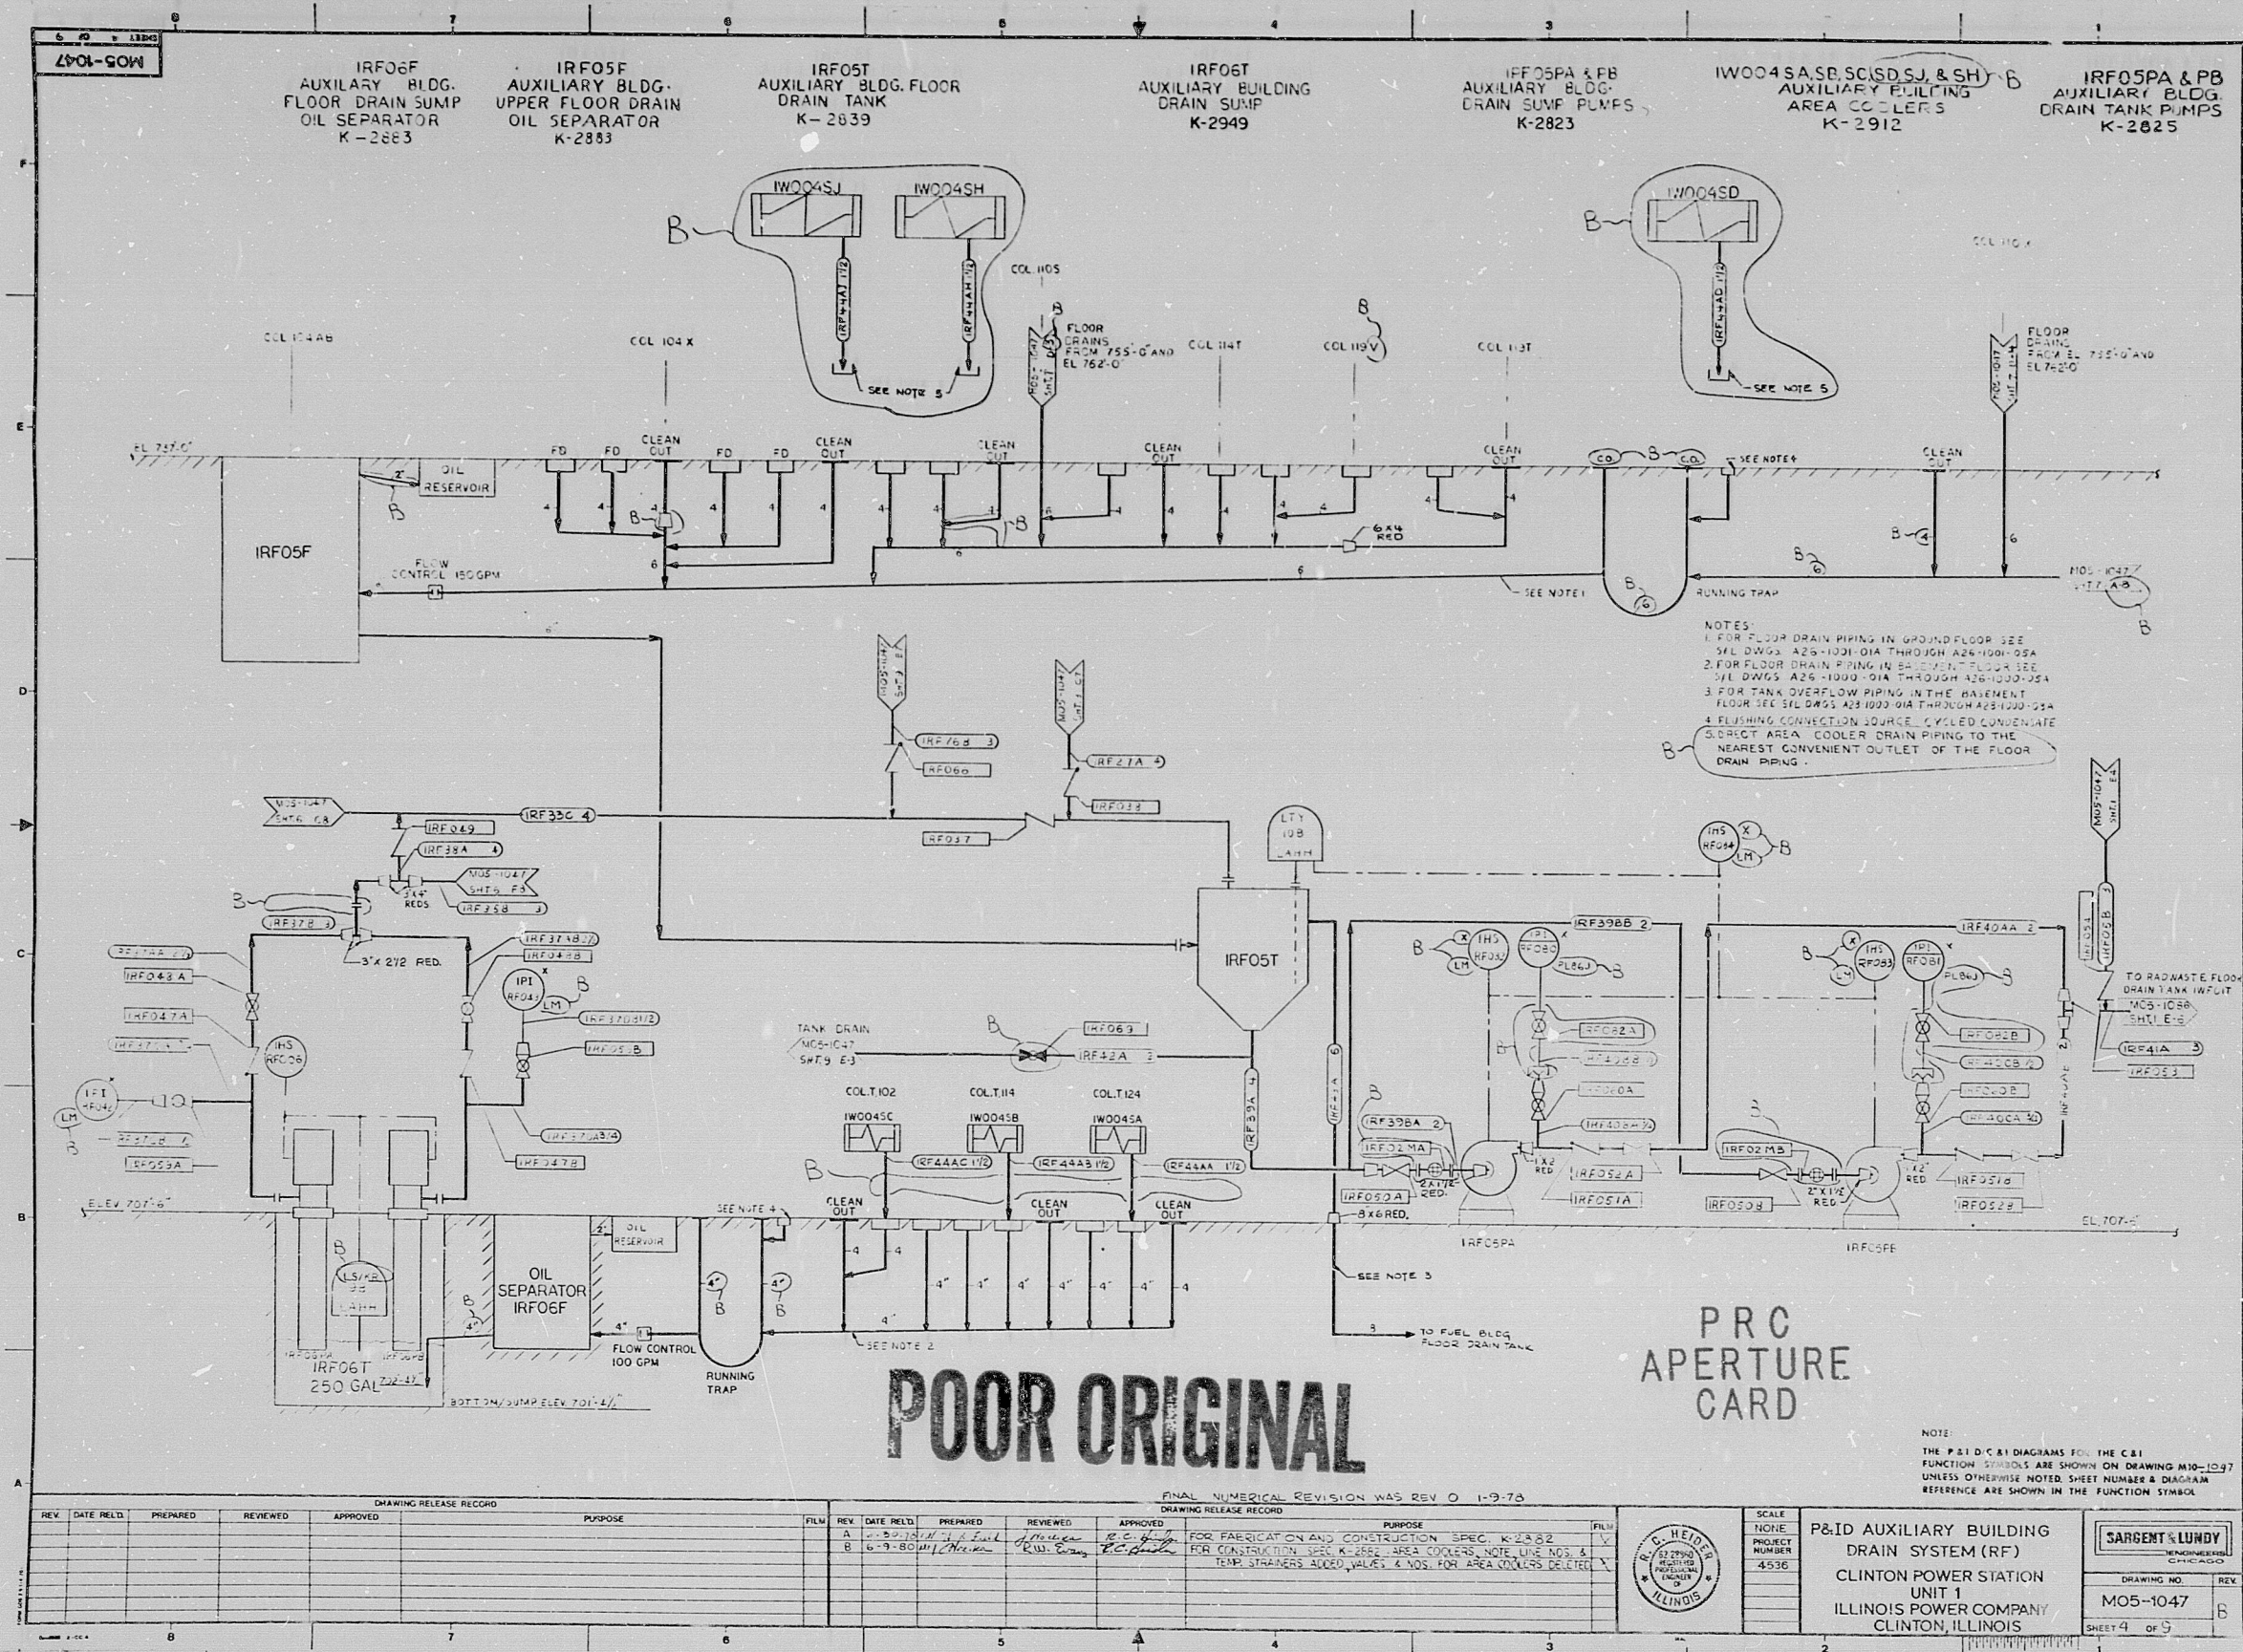

RIDS

8294210281

