


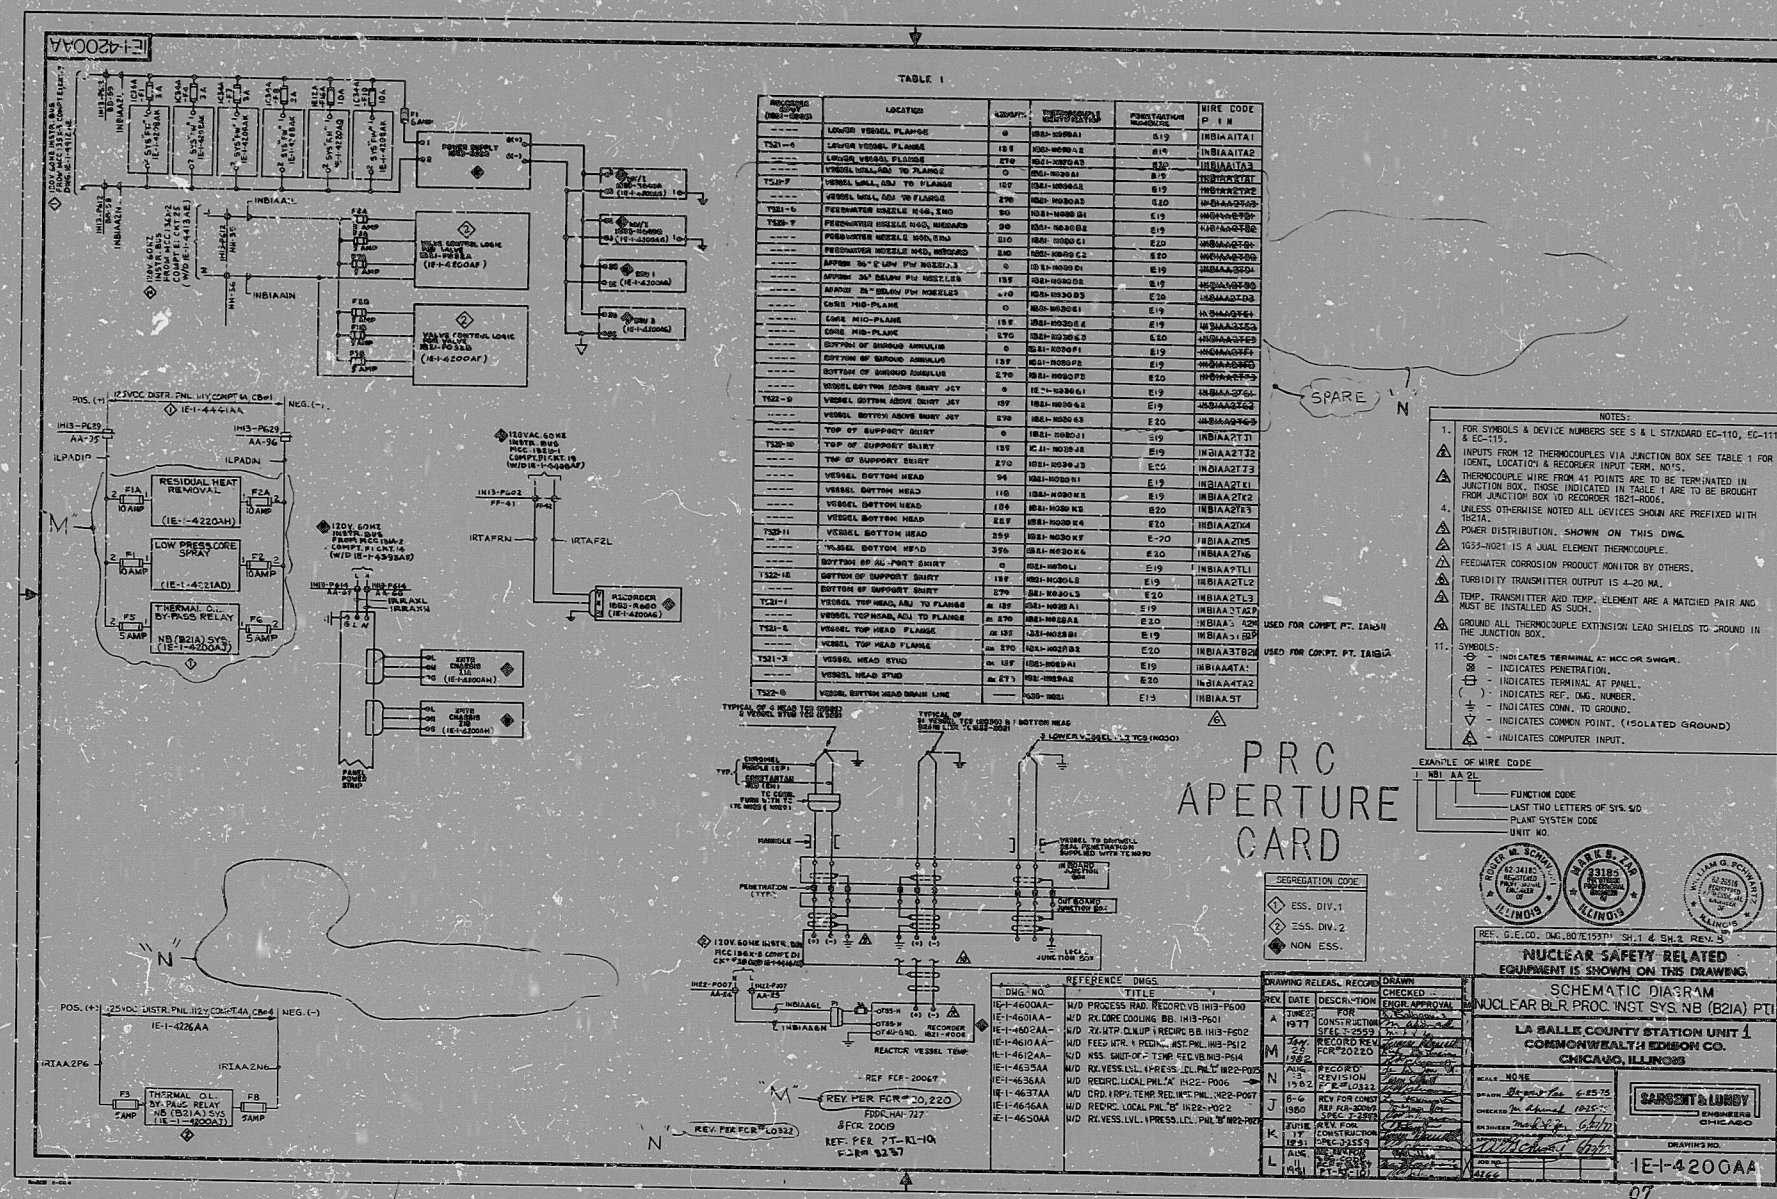

RIDS

8308240184

