

34"

22"

17"

11"

8.5"


0.5"

11"

17"

22"

34"

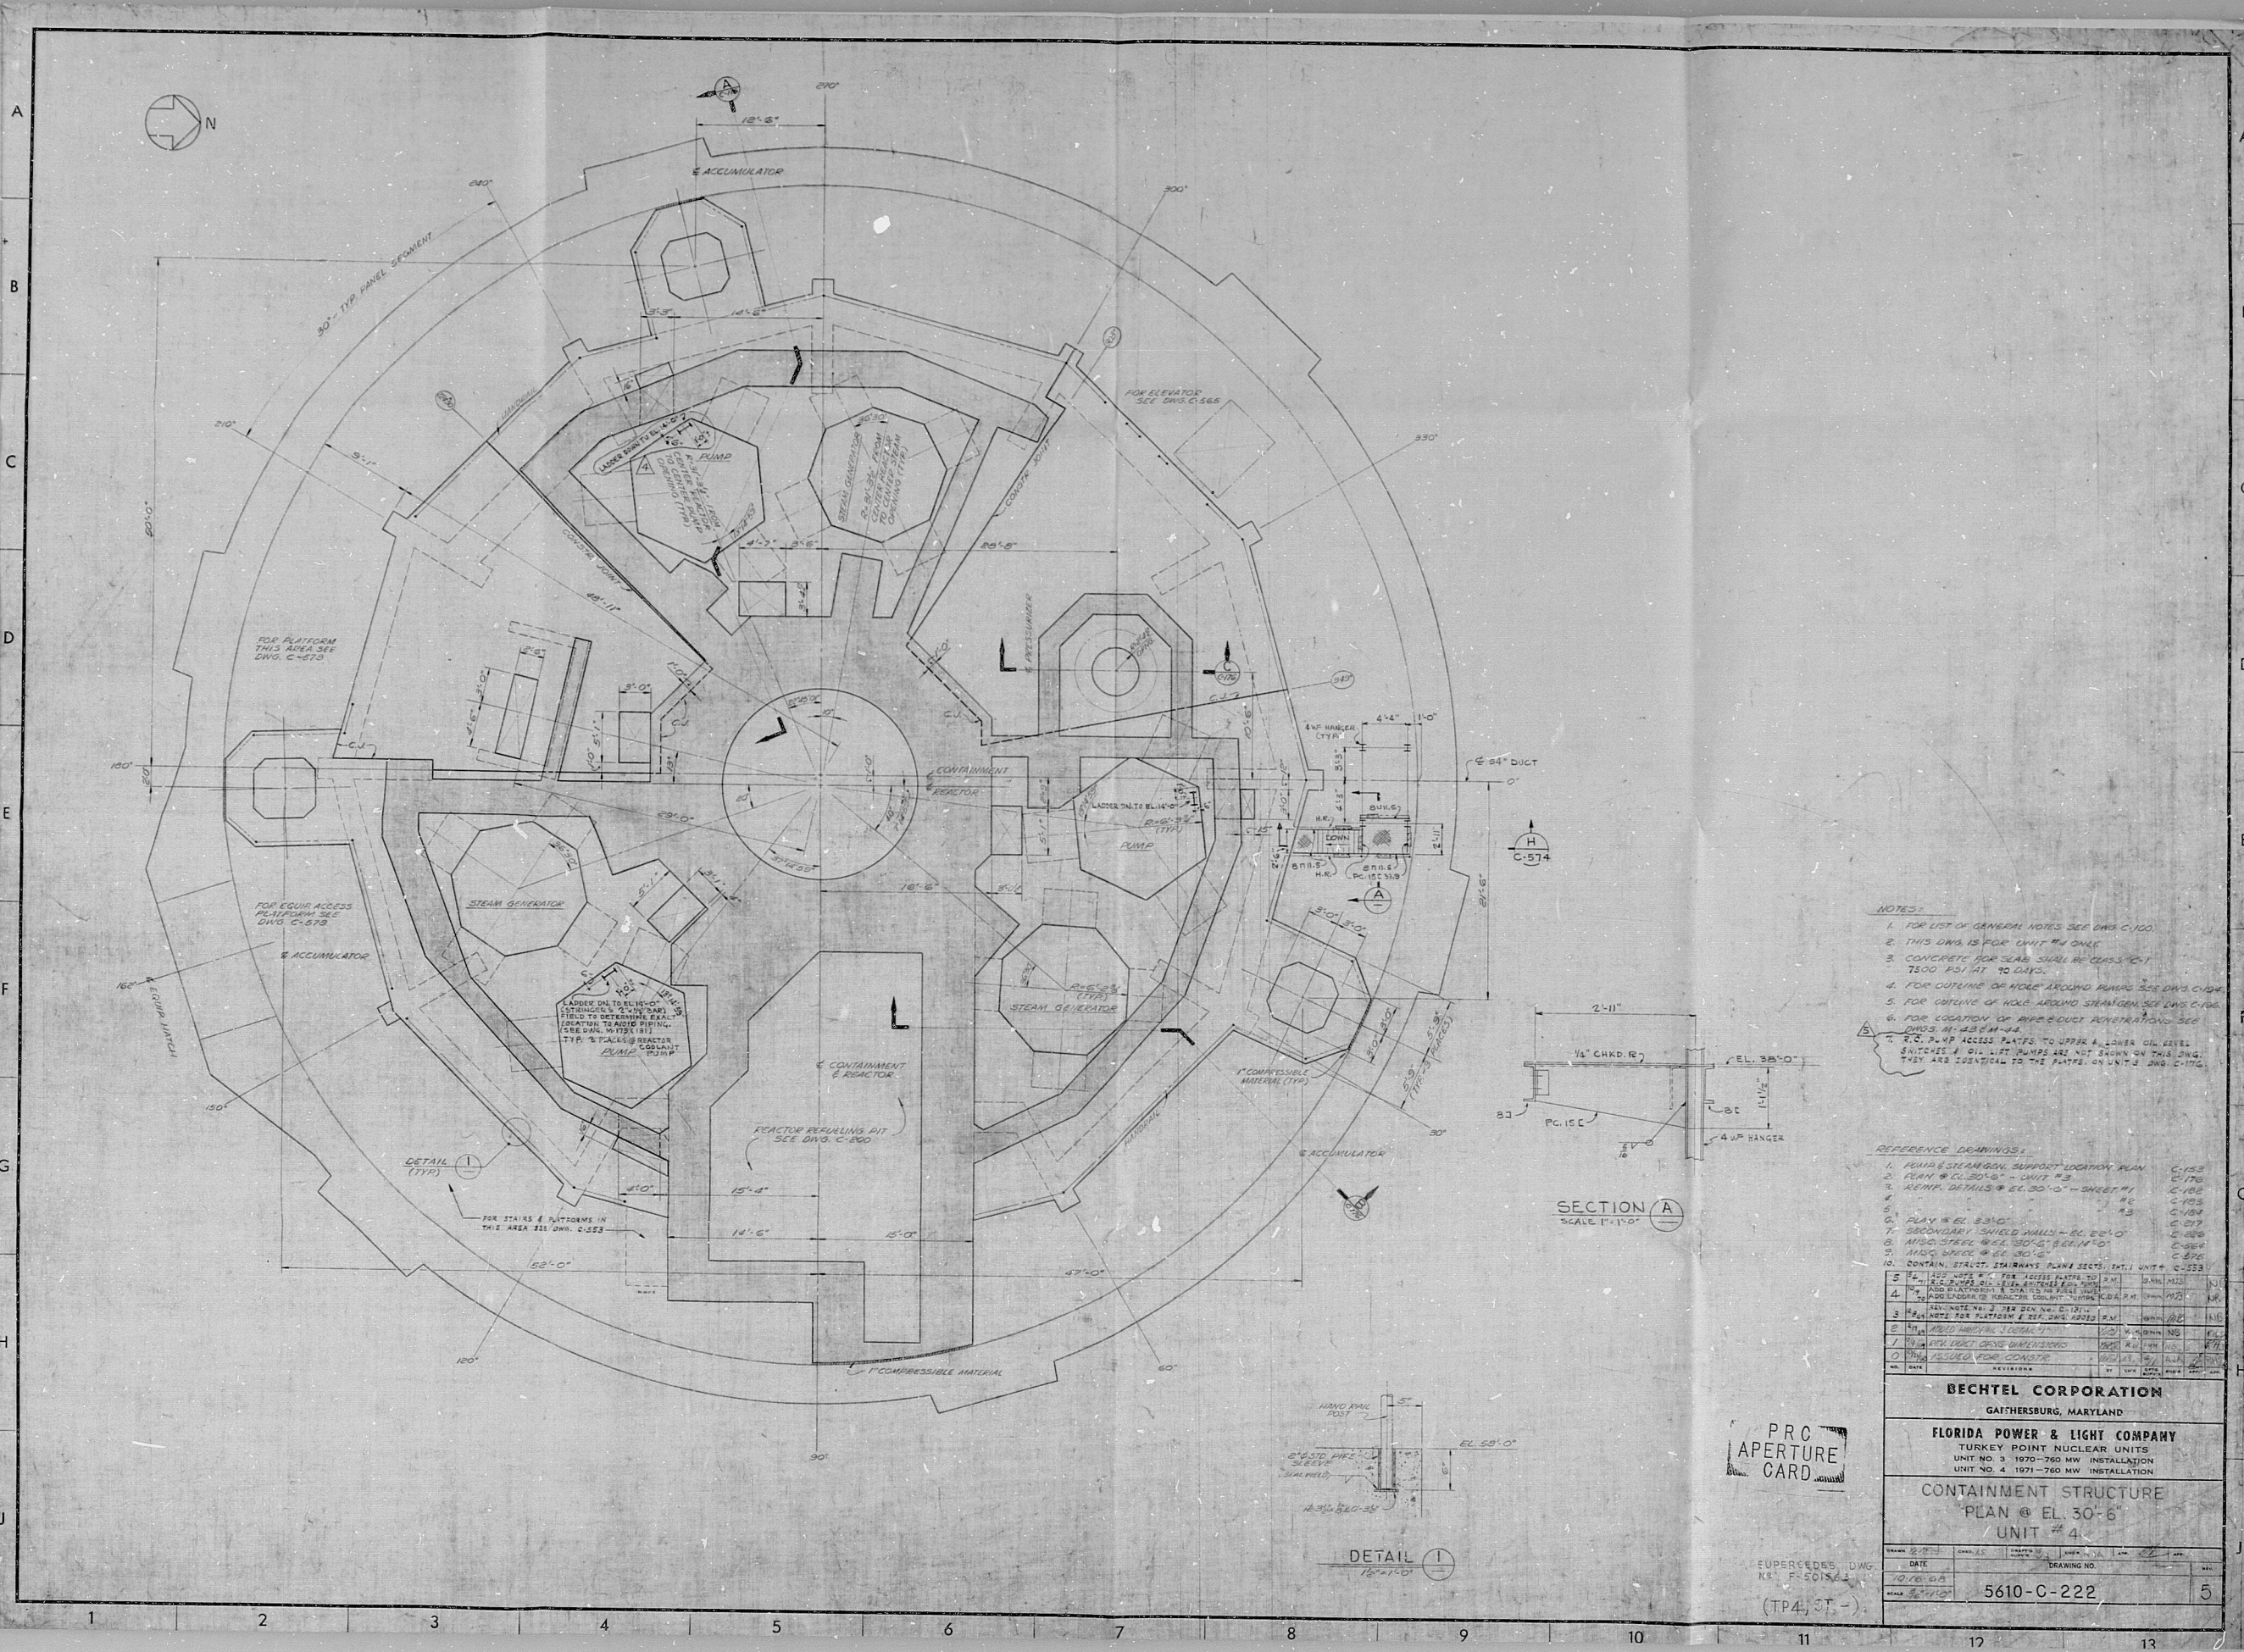

- NOTES:
1. FOR LIST OF GENERAL NOTES SEE DWG. C-100.

REFERENCE DRAWINGS:


BECHTEL CORPORATION	
GAITHERSBURG, MARYLAND	
FLORIDA POWER & LIGHT COMPANY	
TURKEY POINT NUCLEAR UNITS	
UNIT NO. 3 1070-760 MW INSTALLATION	
UNIT NO. 4 1071-760 MW INSTALLATION	
CONTAINMENT STRUCTURE	
PLAN @ EL. 30'-6"	
UNIT #4	
DATE	DRAWING NO.
10/16/68	5610-C-222
BY	5

PRO
APERTURE
CARD

REPLACES DWG.
NO. F-50156
(TP4; ST. -)

22"

17"

11"

8.5"

0.5"

11"

17"

22"

34"

RIDS

6204270544

