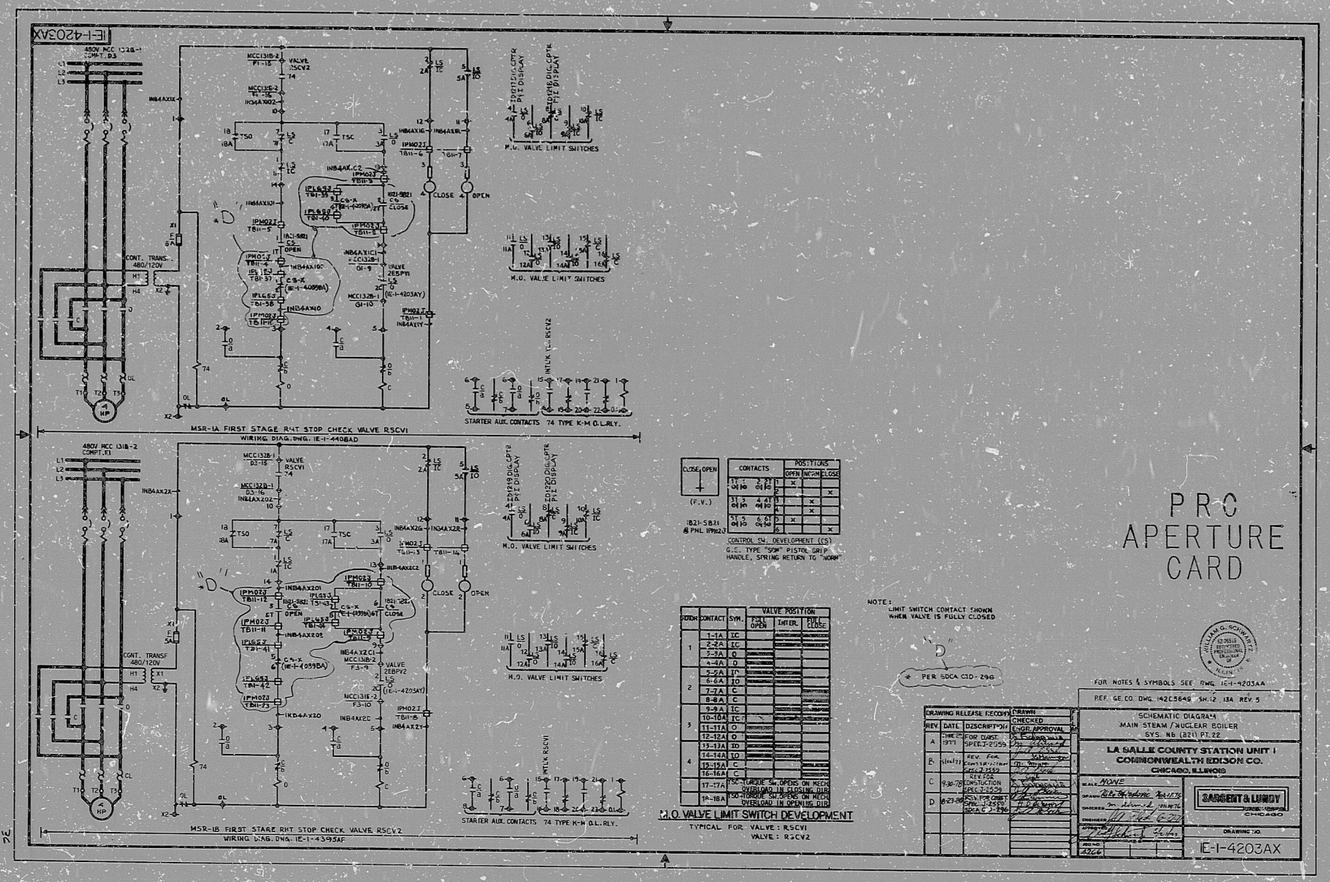

PRC
APERTURE
CARD

RIDS

8308240289

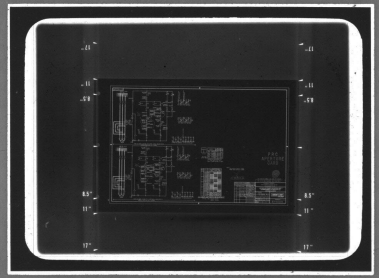

MMM 5324 — FILMSORT® Brand Aperture & Camera Cards and DUPLICARD® Brand Copy Cards — Product of 3M Company, St. Paul, Minn.