

34"

22"

17"

11"

8.5"

8.5"

11"

17"

22"

34"

34"

22"

17"

11"

8.5"


8.5"

11"

17"

22"

34"

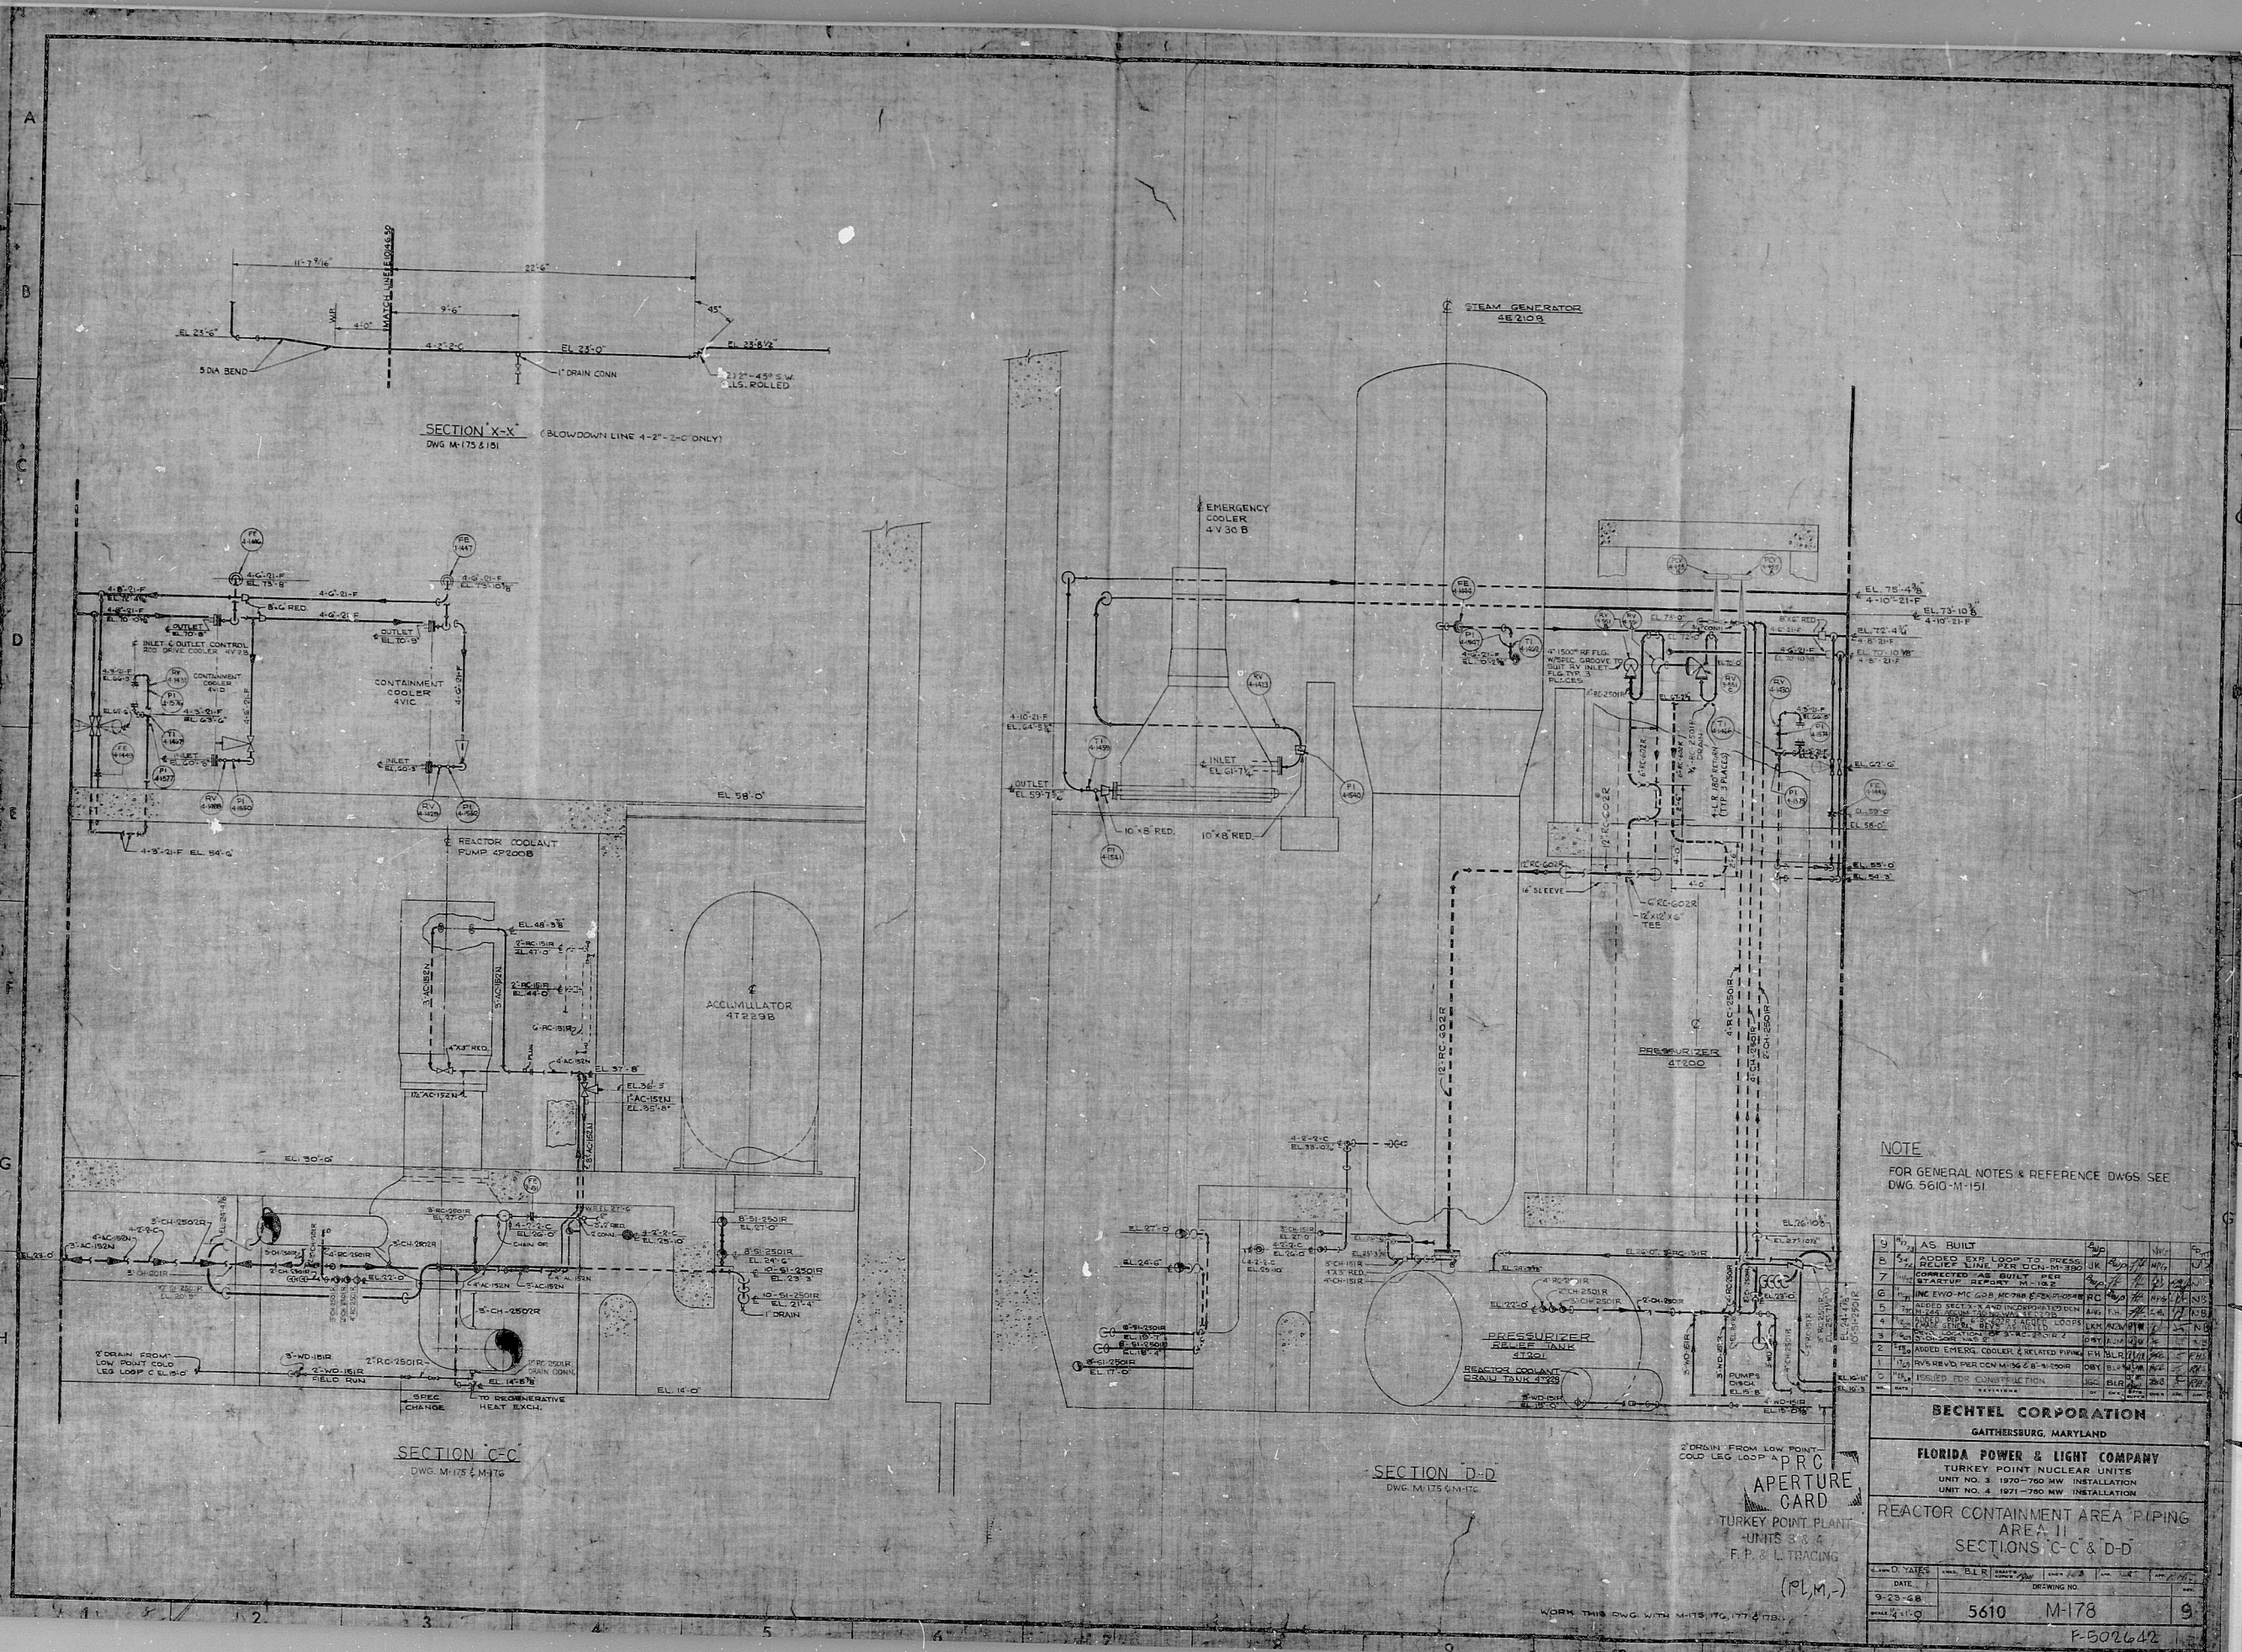



R:DS

8204280213

