

CERTIFICATE OF AUTHENTICITY

I CERTIFY THAT THE IMAGE CONTAINED ON THIS FRAME WAS MADE IN THE NORMAL AND REGULAR COURSE OF BUSINESS, ON THE DATE STATED BELOW AND THAT IT IS AN ACCURATE REPRODUCTION OF THE DOCUMENT SUBMITTED TO MICROGRAPHIC.

DATE 4-8-77

CAMERA OPERATOR

SECTION SUPERVISOR

16X

DOCUMENTS ASSOCIATED WITH CHANGE					REMARKS	
DOC.	REV.	ISS.	TITLE	VEN.	NO.	NO.

ABN # 89-12-001-137
Page 5 of 5

ABN # 9

Page 5077.001 31.10.1

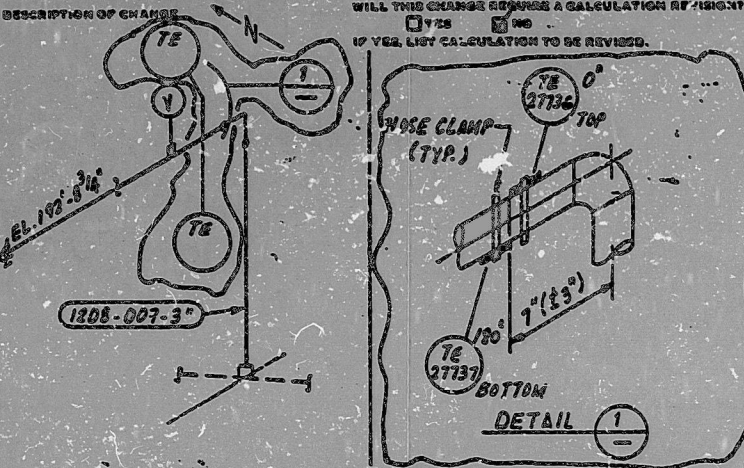
89-V2-001-137
VECTE ELECTRIC GENERATING PLANT
INTERIM DRAWING CHANGE NOTICE (IDCN)
JOB NO. 8910

ORIGINAL

DATE 10-12-88 BY S. SANTOS

CHANGE REQUESTED BY:
☐ GCE CONVEY ☐ PROJ FIELD ENGINEER
☐ GCE DWG OPS ☐ HOME OFFICE ENGINEER
☐ GCE ☐ SUPPLIER/CONTRACTOR

REASON FOR CHANGE: TO IMPLEMENT WESTINGHOUSE PROPOSED SOLUTION FOR THERMAL STRATIFICATION PROBLEM (MSEA-88-03)

DESCRIPTION OF CHANGE: 

WILL THIS CHANGE REQUIRE A CALCULATION REVISION?
☐ YES ☐ NO
IF YES, LIST CALCULATION TO BE REVISED.

STARTUP TESTING AFFECTED: 20002

INTERDISCIPLINE REVIEW:
☐ ARCH ☐ CIVIL ☐ ELECTRICAL ☐ MECH ☐ NUCLEAR ☐ PLANT DESIGN ☐ PIPE SUPP ☐ HAZARDOUS ☐ EQUIP QUAL ☐ OTHER

MATERIAL REVISION REQUIRED:
☐ GCE CONVEY ☐ PROJ FIELD ENGINEER ☐ GCE DWG OPS ☐ HOME OFFICE ENGINEER ☐ SUPPLIER/CONTRACTOR

APPROVAL SIGNATURES:
DESIGN ENGINEERING: 
PROJECT ADMINISTRATION: 

ALL XPERTS AGAINST IDCN HAVE BEEN IDENTIFIED AND NOTED ON THE IDCN.

DATE 10-12-88

ALTERNATE CHARGING
UNIT 2

SI
APERTURE
CARD

PDR RIDS

9103150220 E

