


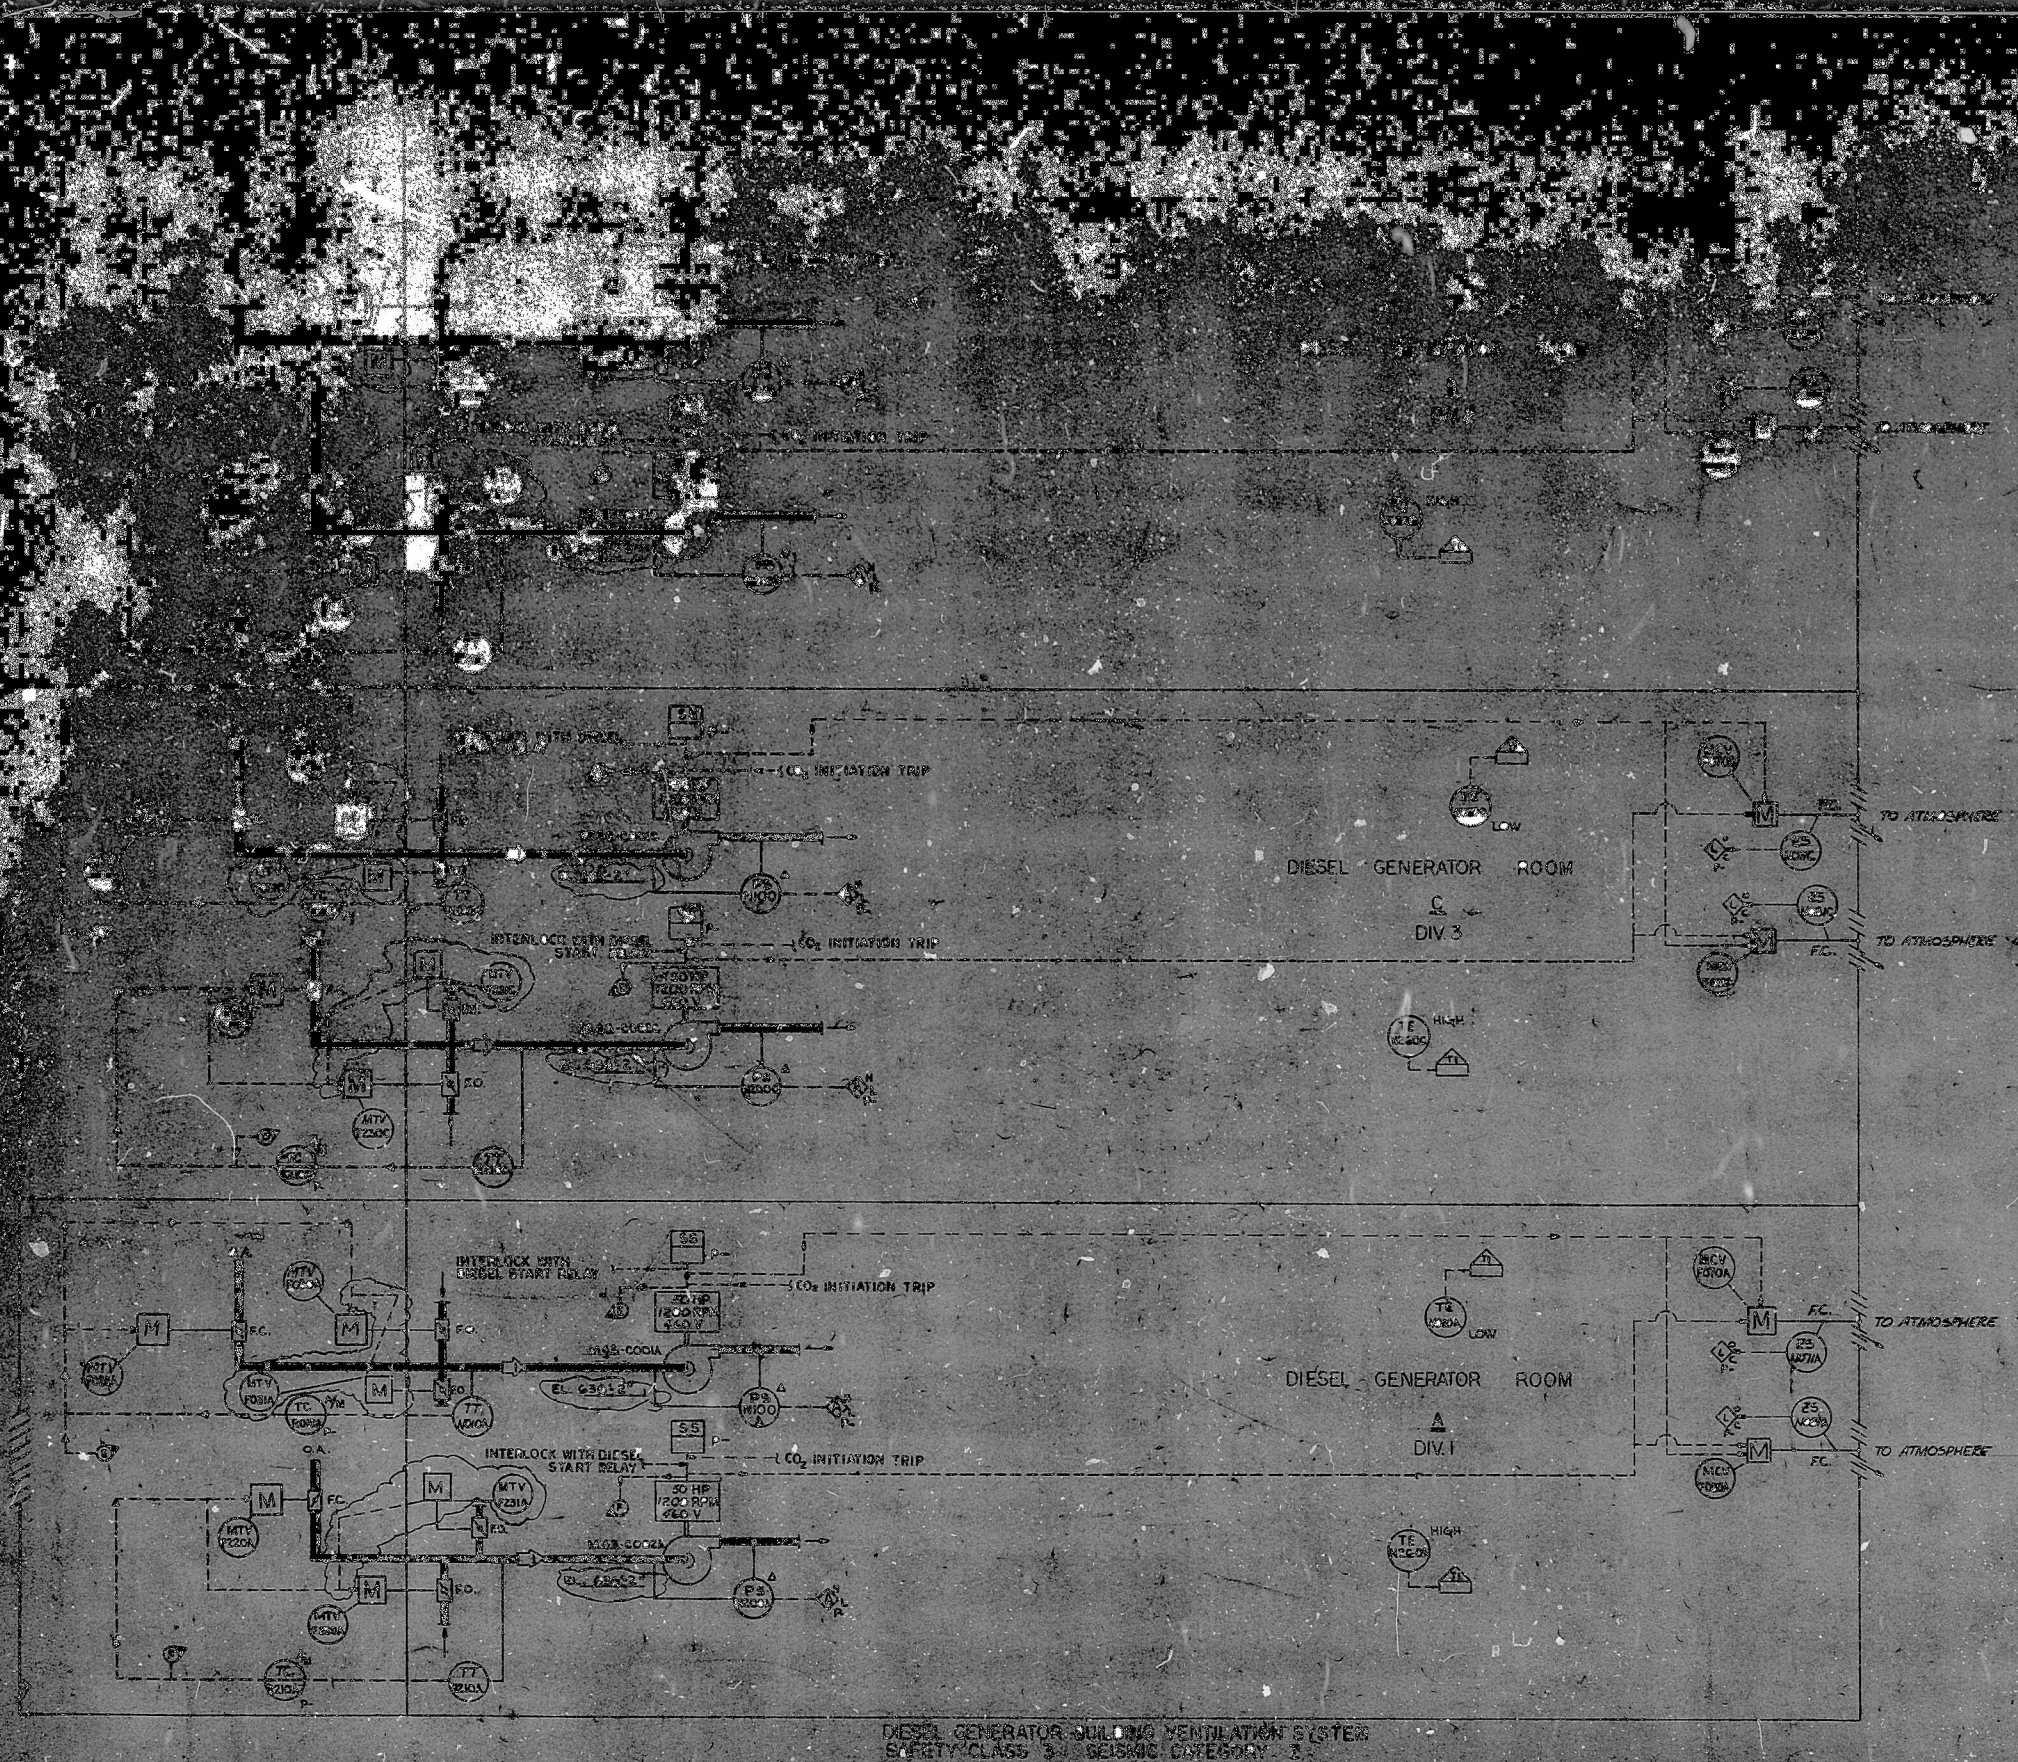

NOTE:

1. ALL DISCREPANCIES BETWEEN THIS DRAWING AND THE DESIGN SHALL BE REPORTED TO THE DESIGNER.

NUCLEAR SAFETY RELATED

YES

DESIGNER	DATE
CHECKED	DATE
APPROVED	DATE

1	2	3	4	5	6	7	8	9	10
11	12	13	14	15	16	17	18	19	20

RIDS-PDR

8103130723

