


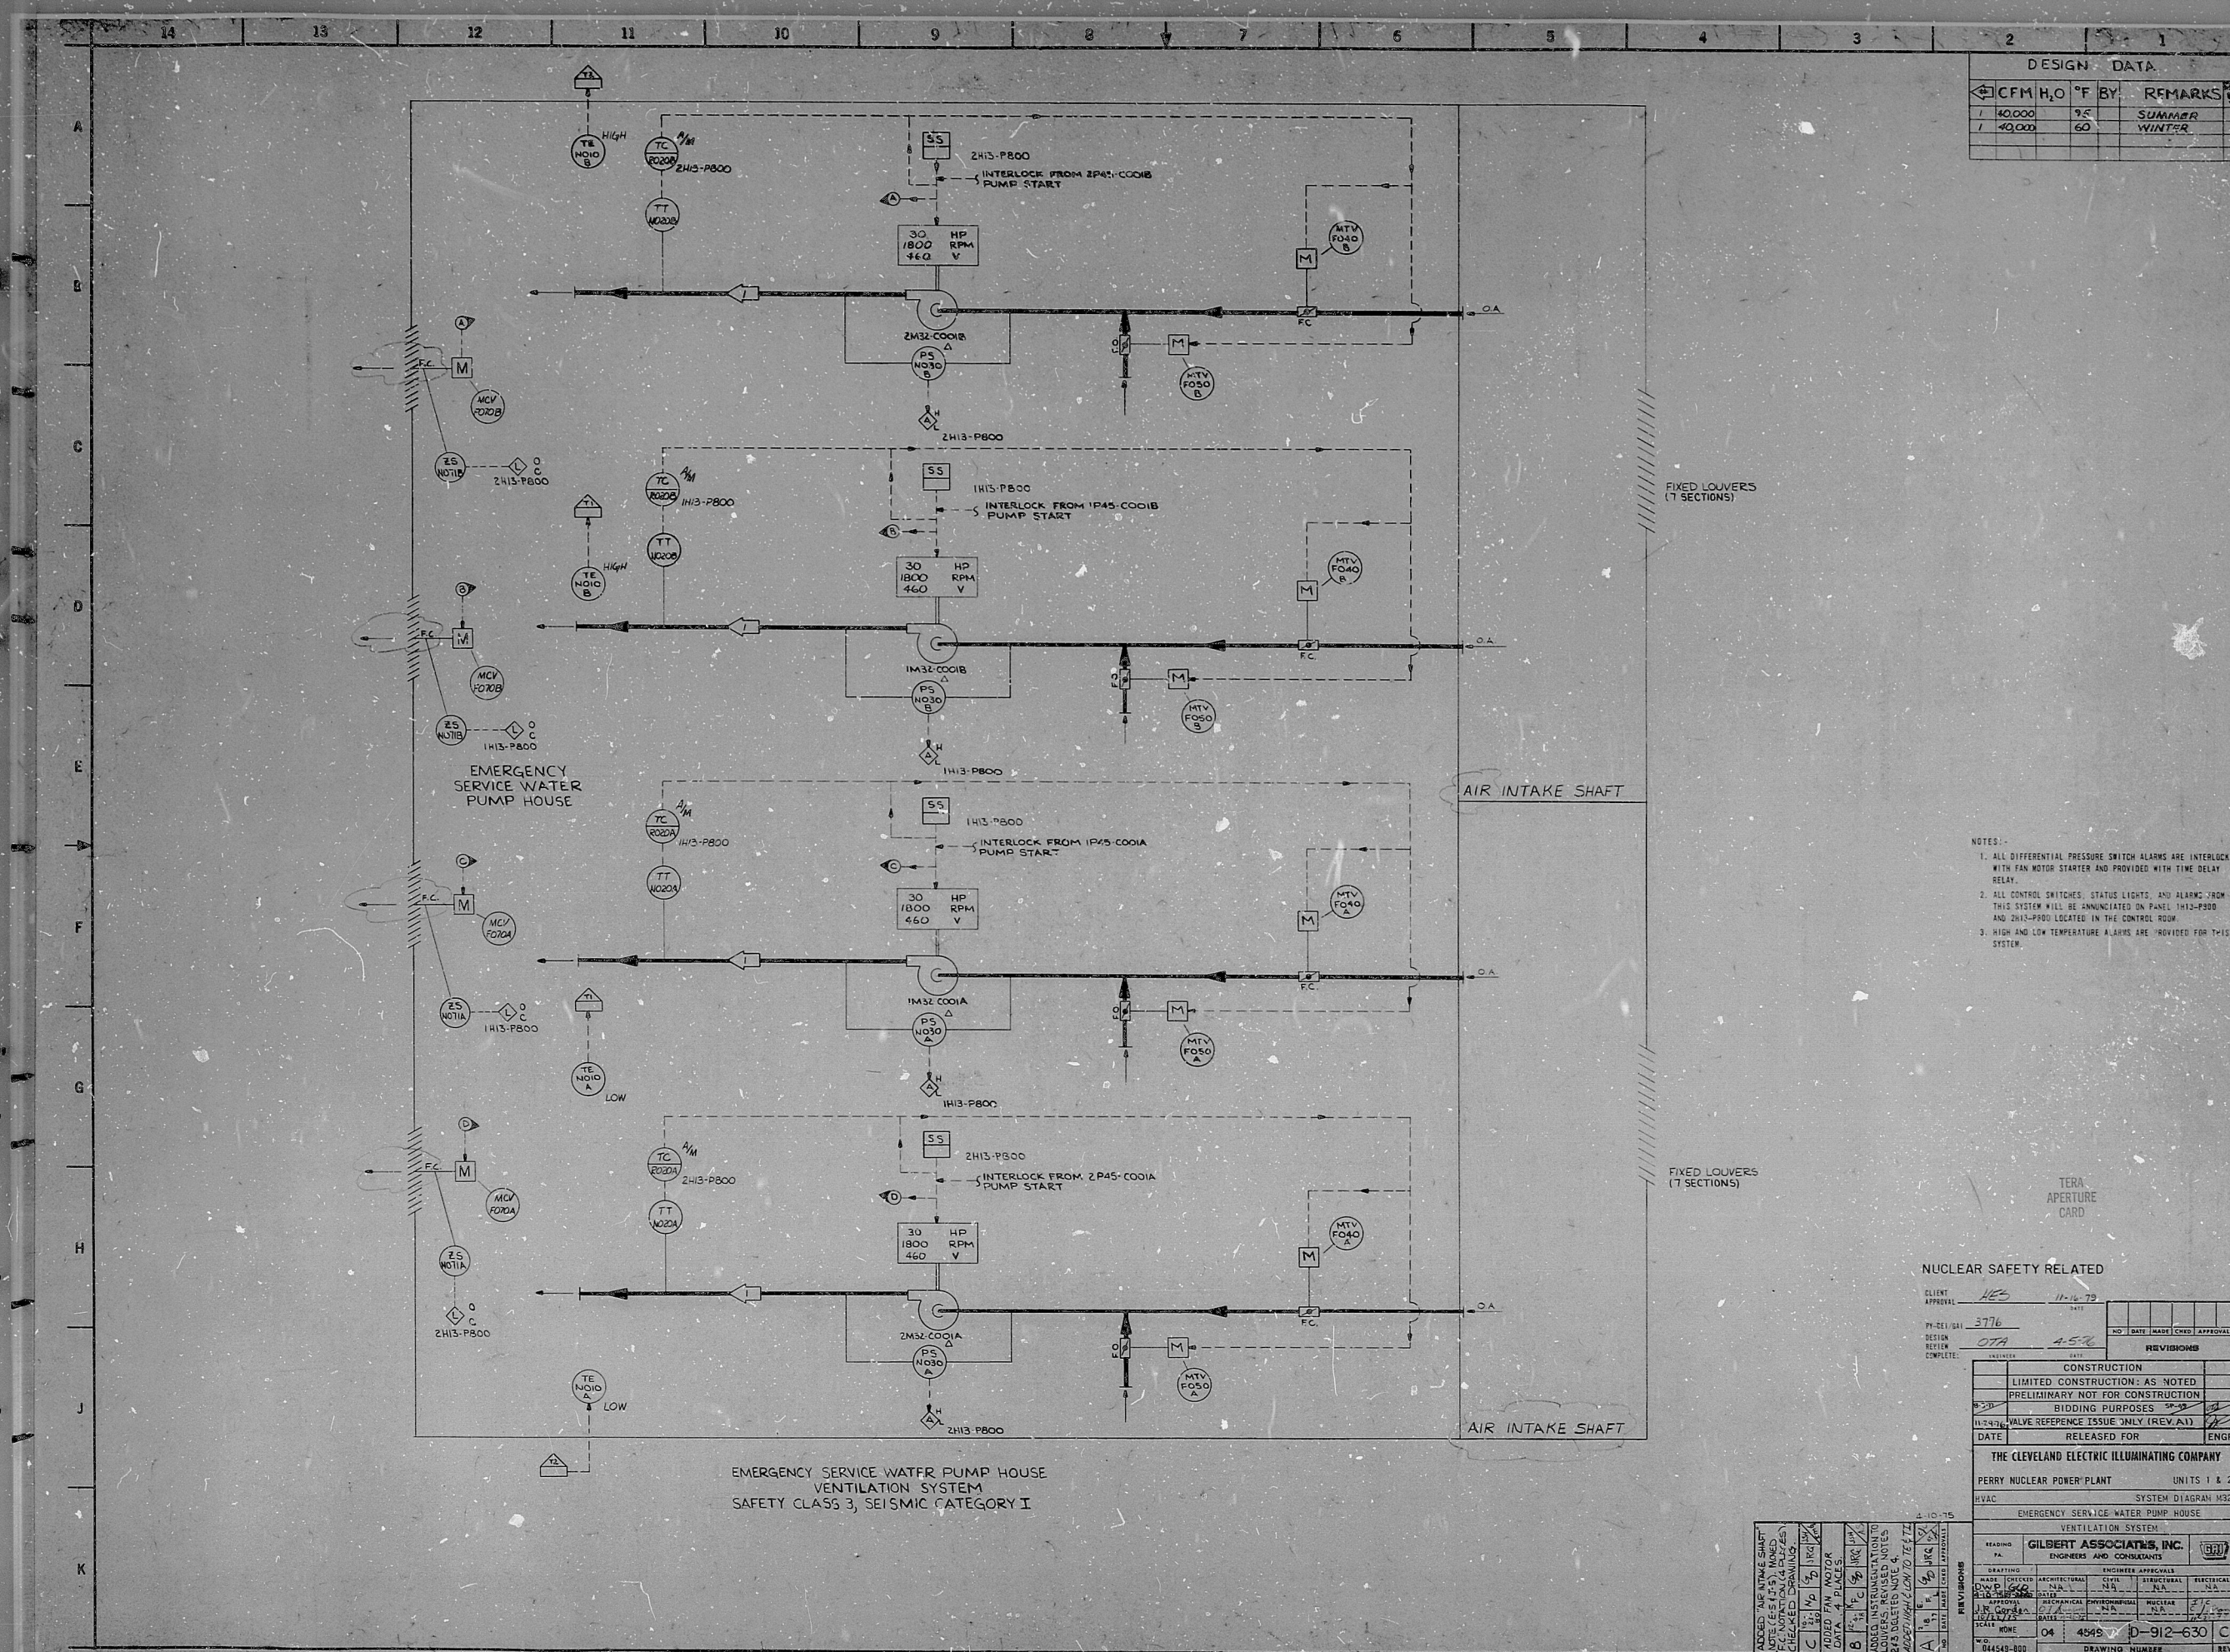

DESIGN DATA			
CFM	H ₂ O	°F	REMARKS
1	40,000	95	SUMMER
1	40,000	60	WINTER

- NOTES:
1. ALL DIFFERENTIAL PRESSURE SWITCH ALARMS ARE INTERLOCKED WITH FAN MOTOR STARTER AND PROVIDED WITH TIME DELAY RELAY.
 2. ALL CONTROL SWITCHES, STATUS LIGHTS, AND ALARMS FROM THIS SYSTEM WILL BE ANNUNCIATED ON PANEL 1H12-P800 AND 2H12-P800 LOCATED IN THE CONTROL ROOM.
 3. HIGH AND LOW TEMPERATURE ALARMS ARE PROVIDED FOR THIS SYSTEM.

NUCLEAR SAFETY RELATED

CLIENT	HEC	DATE	11-16-79
DESIGN	3776	NO.	DATE MADE CHD APPROVALS
REVIEW	OTA	DATE	4-5-80
COMPLETE		DATE	

CONSTRUCTION	
LIMITED CONSTRUCTION: AS NOTED	
PRELIMINARY NOT FOR CONSTRUCTION	
BIDDING PURPOSES	
VALUE REFERENCE ISSUE ONLY (REV. A1)	
DATE	RELEASED FOR
DATE	ENGR
THE CLEVELAND ELECTRIC ILLUMINATING COMPANY	
PERRY NUCLEAR POWER PLANT	
UNITS 1 & 2	
HVAC SYSTEM DIAGRAM M32	
EMERGENCY SERVICE WATER PUMP HOUSE	
VENTILATION SYSTEM	
GILBERT ASSOCIATES, INC.	
ENGINEERS AND CONSULTANTS	
READING	
DESIGN	
ENGINEER	
ARCHITECTURAL	
MECHANICAL	
ELECTRICAL	

RIDS-RDR

8/03/60/01

