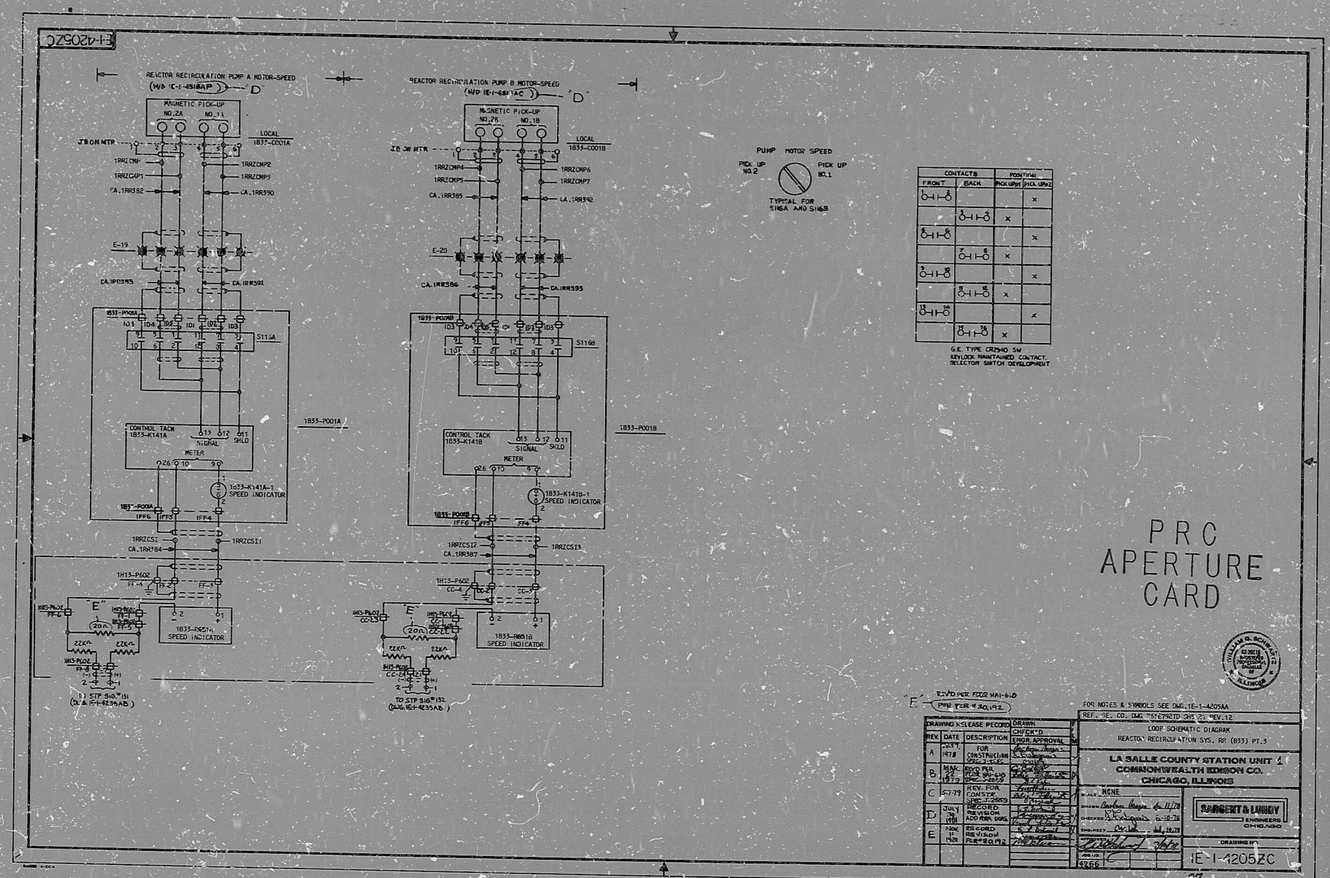
E-1-4205ZC
REACTOR RECIRCULATION PUMP A MOTOR-SPEED
REACTOR RECIRCULATION PUMP B MOTOR-SPEED
MAGNETIC PICK-UP
LOCAL
PUMP MOTOR SPEED
TYPICAL FOR S16A AND S16B
CONTACTS
POSITION
FRONT
BACK
PICK UP
G.E. TYPE CR2940 SW
KEYLOCK MAINTAINED CONTACT
SELECTOR SWITCH DEVELOPMENT
CONTROL TACH
SIGNAL
METER
SPEED INDICATOR
PRC
APERTURE
CARD
FOR NOTES & SYMBOLS SEE DWG. 1E-1-4205AA
LOOP SCHEMATIC DIAGRAM
REACTOR RECIRCULATION SYS. RR (B33) PT.3
LA SALLE COUNTY STATION UNIT 1
COMMONWEALTH EDISON CO.
CHICAGO, ILLINOIS
SARGENT & LUNDY
ENGINEERS
CHICAGO
DRAWING NO
1E-1-4205ZC

RIDS

8308240598

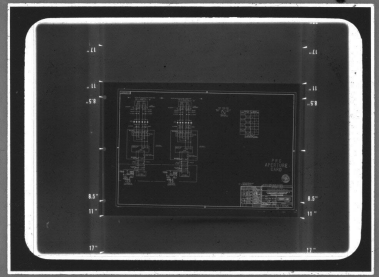

MMM 5824 — FILMSORT® Brand Aperture & Camera Cards and DUPLICARD® Brand Copy Cards — Product of 3M Company, St. Paul, Minn.