


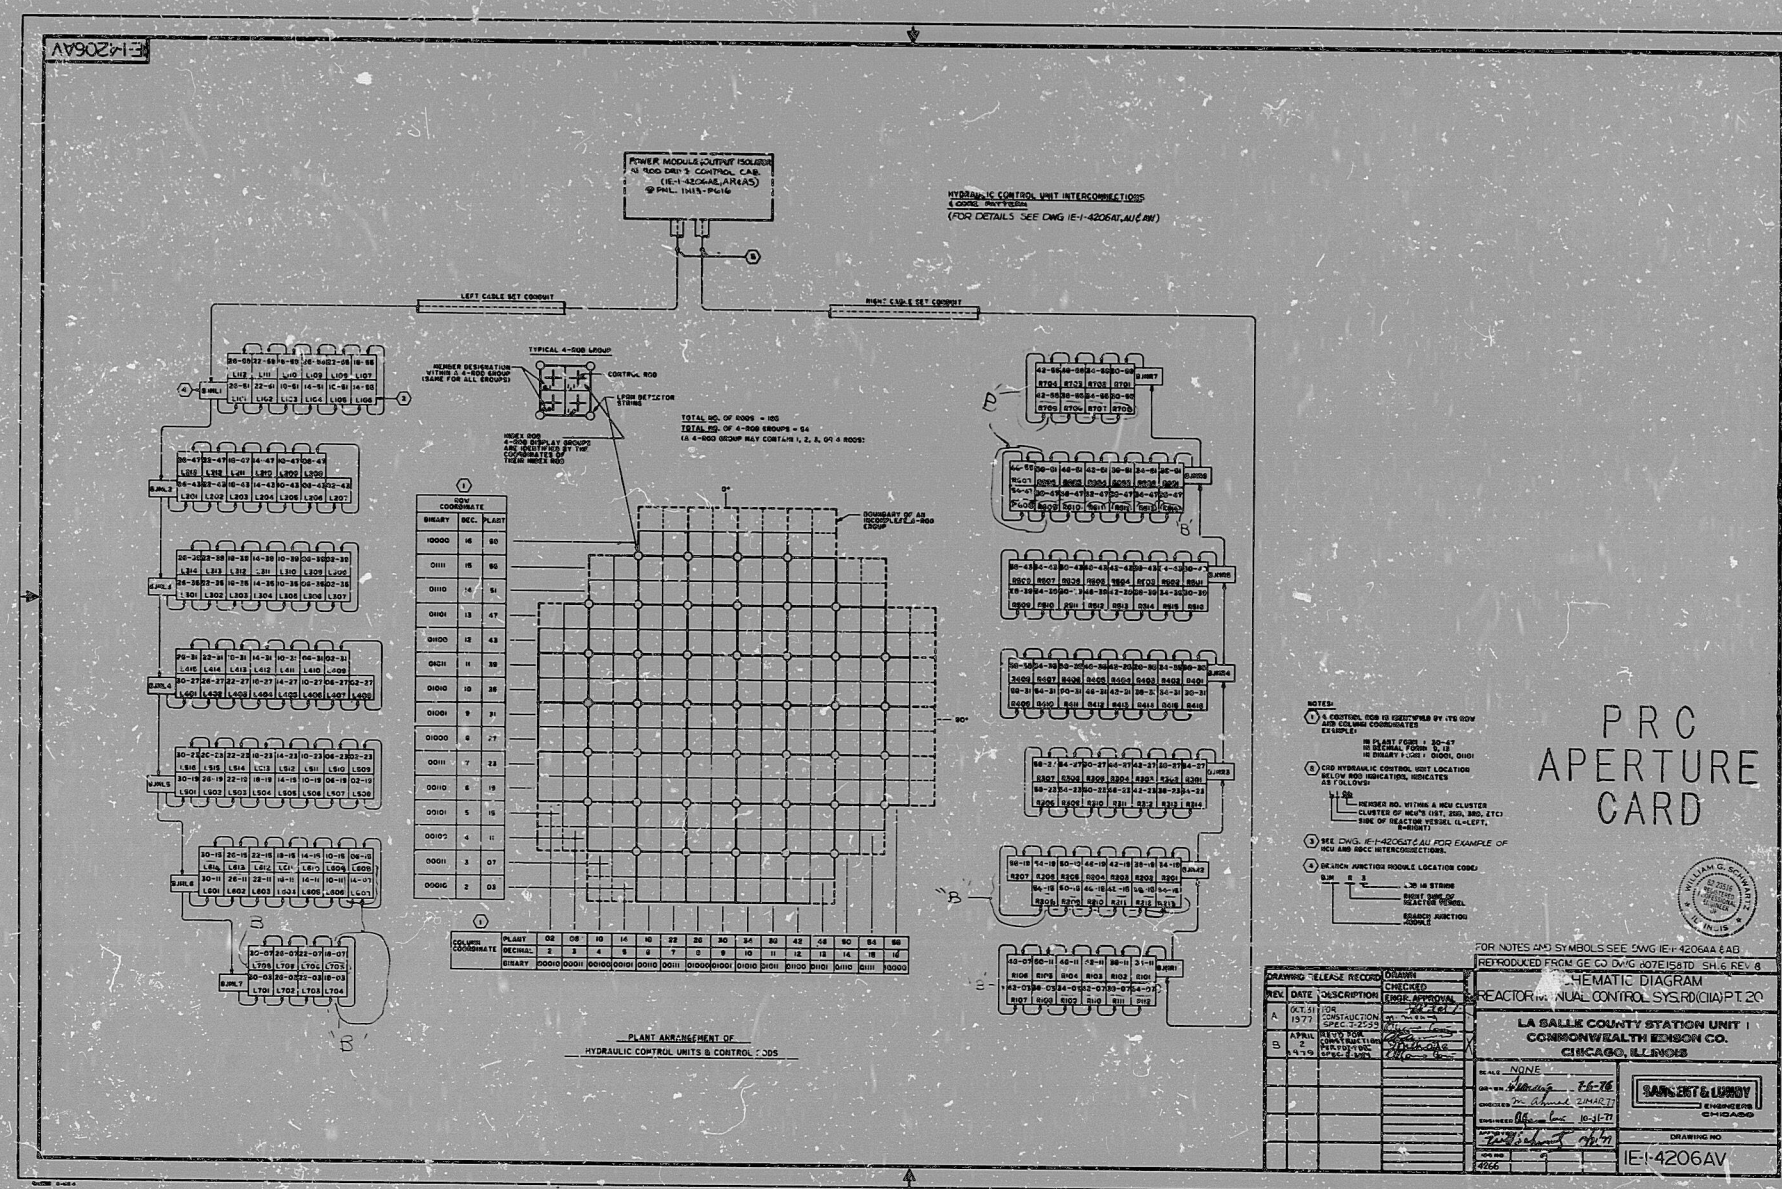

RIDS

8308240668

