


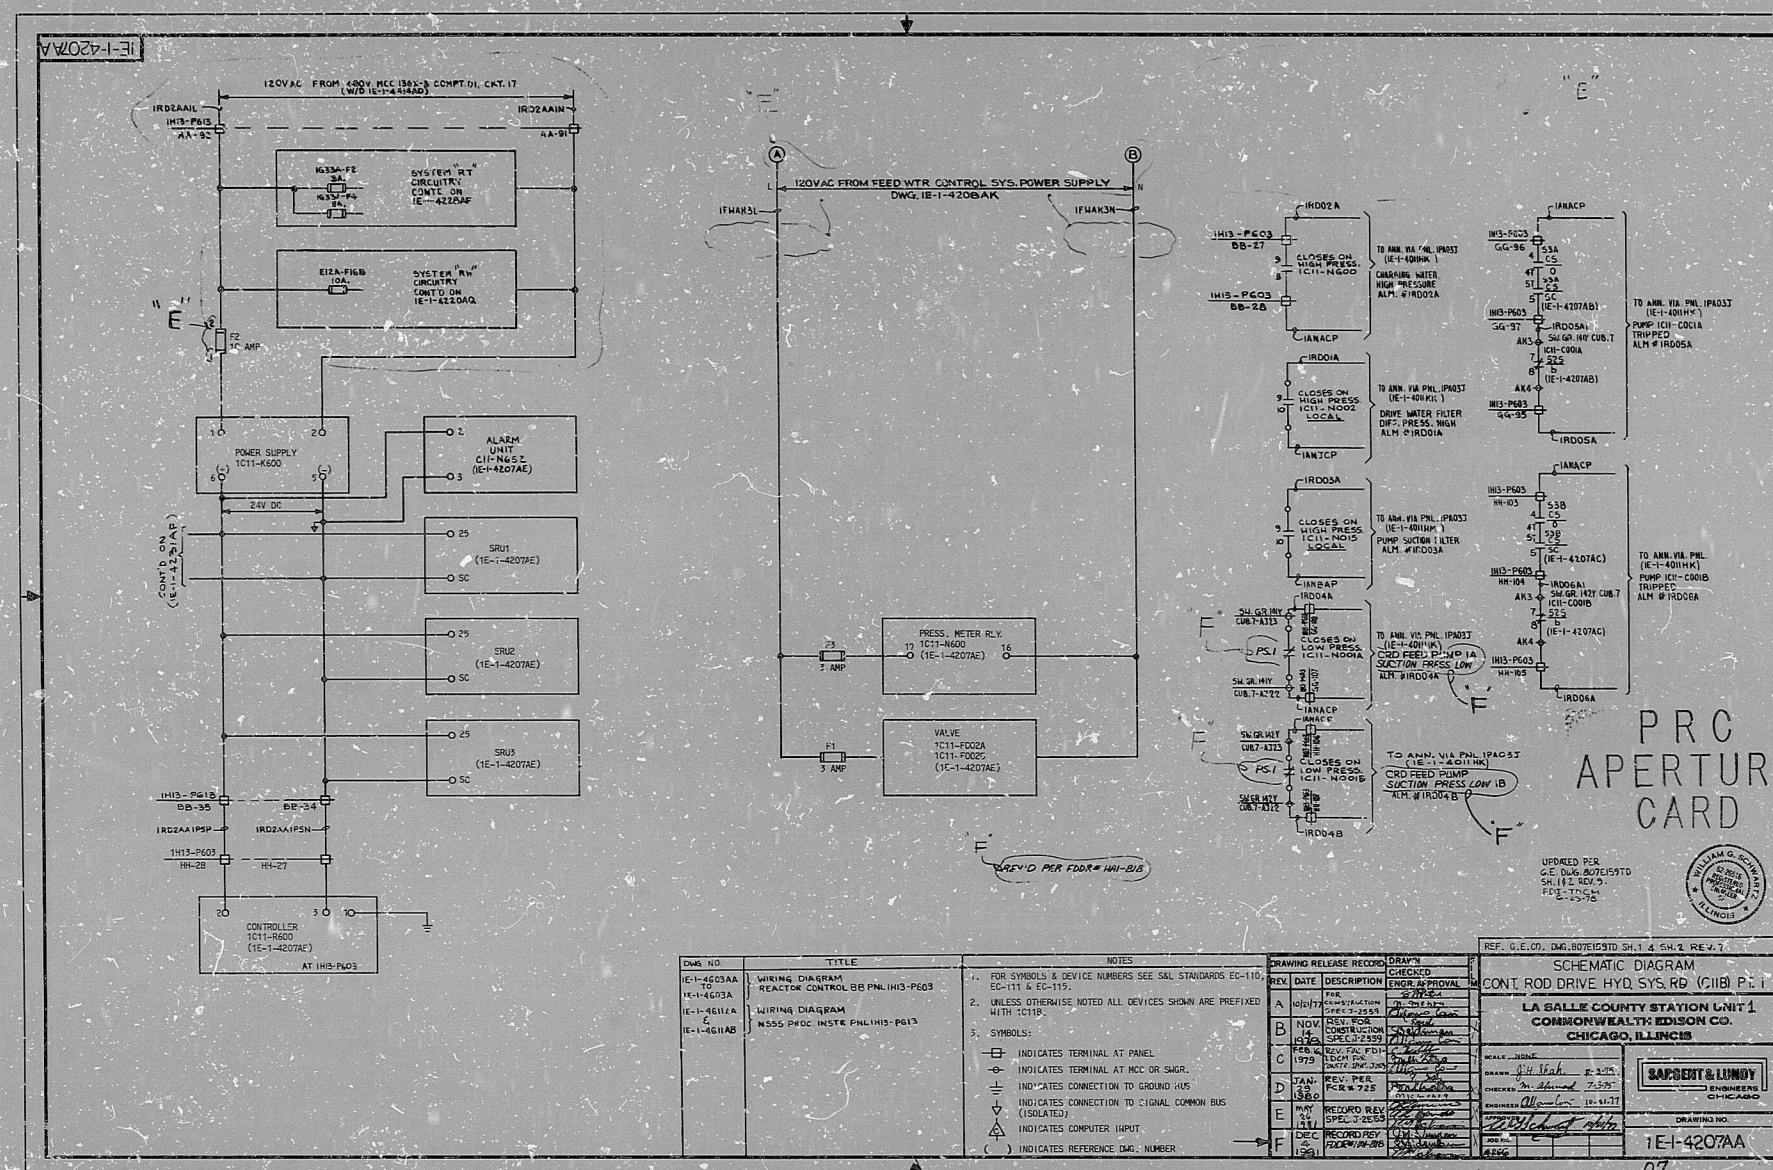

PRC
APERTUR
CARD

UPDATED PER
G.E. DWG. 807E1597
SH. 142 REV. 9.
FDI-TDCM

REF. G.E.CD. DWG. 807E15TD SH.1 & SH.2 REV. 2
SCHEMATIC DIAGRAM
CONT. ROD DRIVE HYD. SYS. RD. (C118)
LA SALLE COUNTY STATION &
COMMONWEALTH EDISON CO
CHICAGO, ILLINOIS

SARGENT & LUNDY

ENGINEERING
CHICAGO

DRAFTING NO.

1E-I-4207AA

07

RIDS

8308240690

