


NPR 40

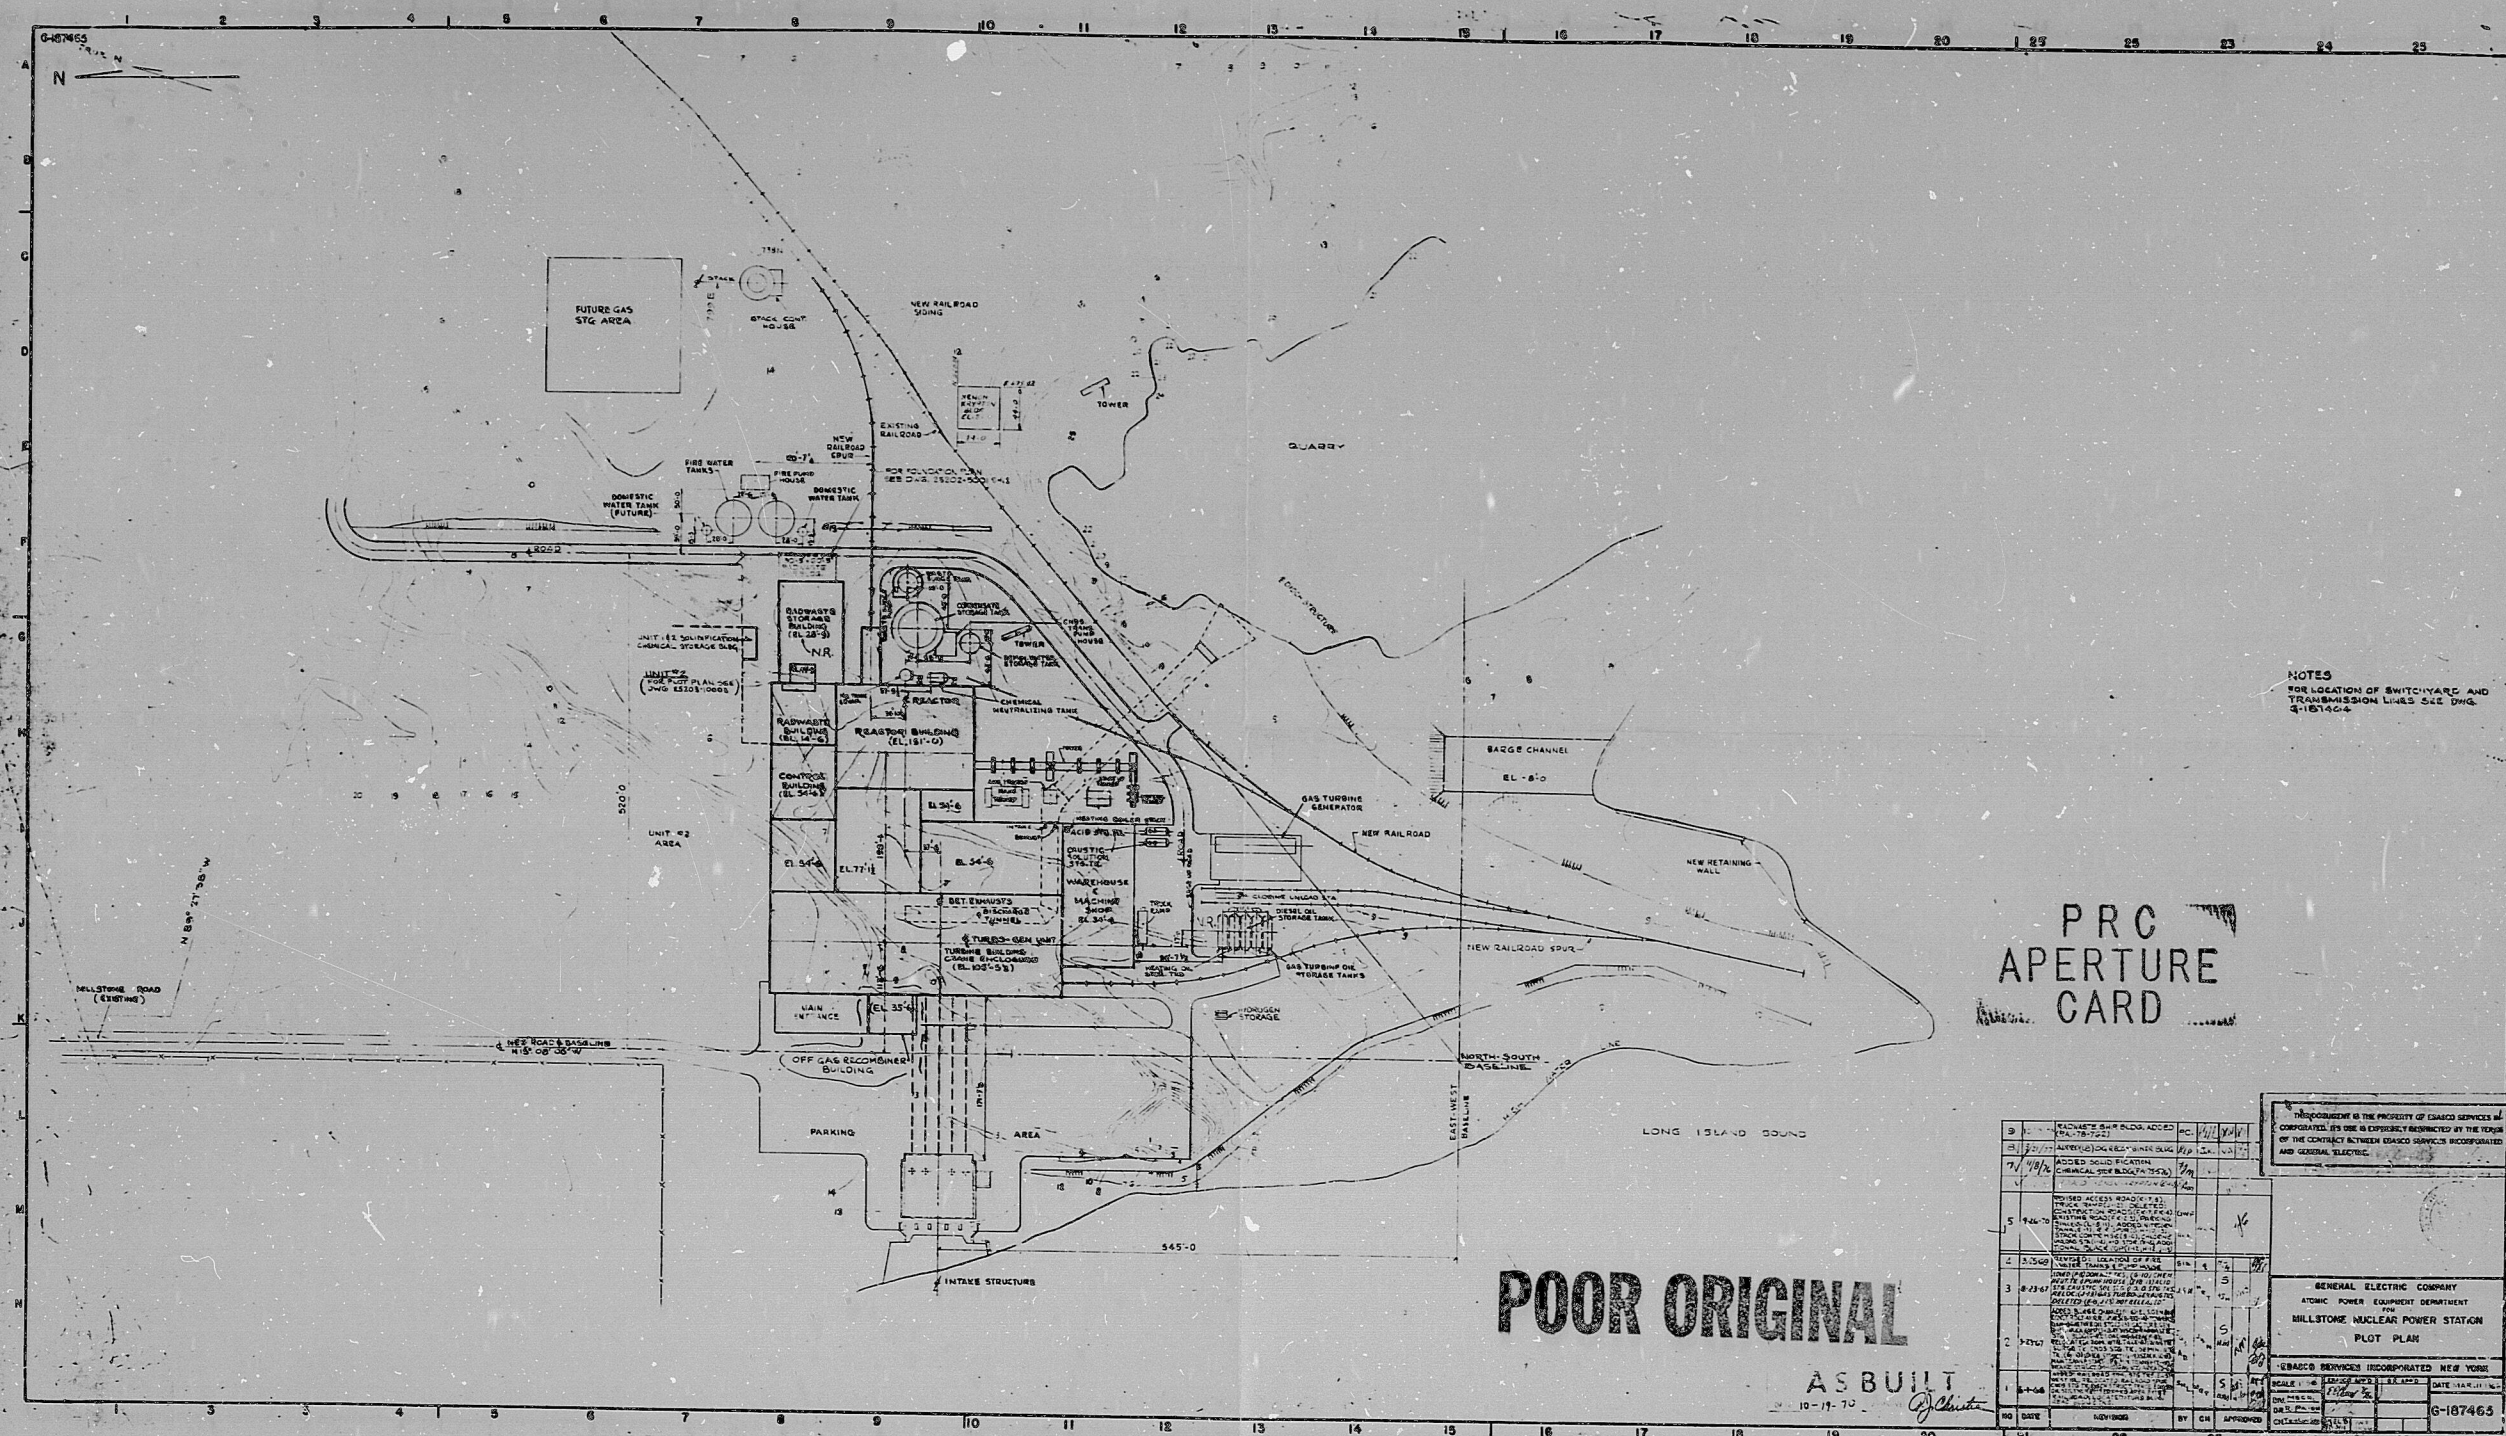

8205030459

RIDS

8205030459

