


NPR3

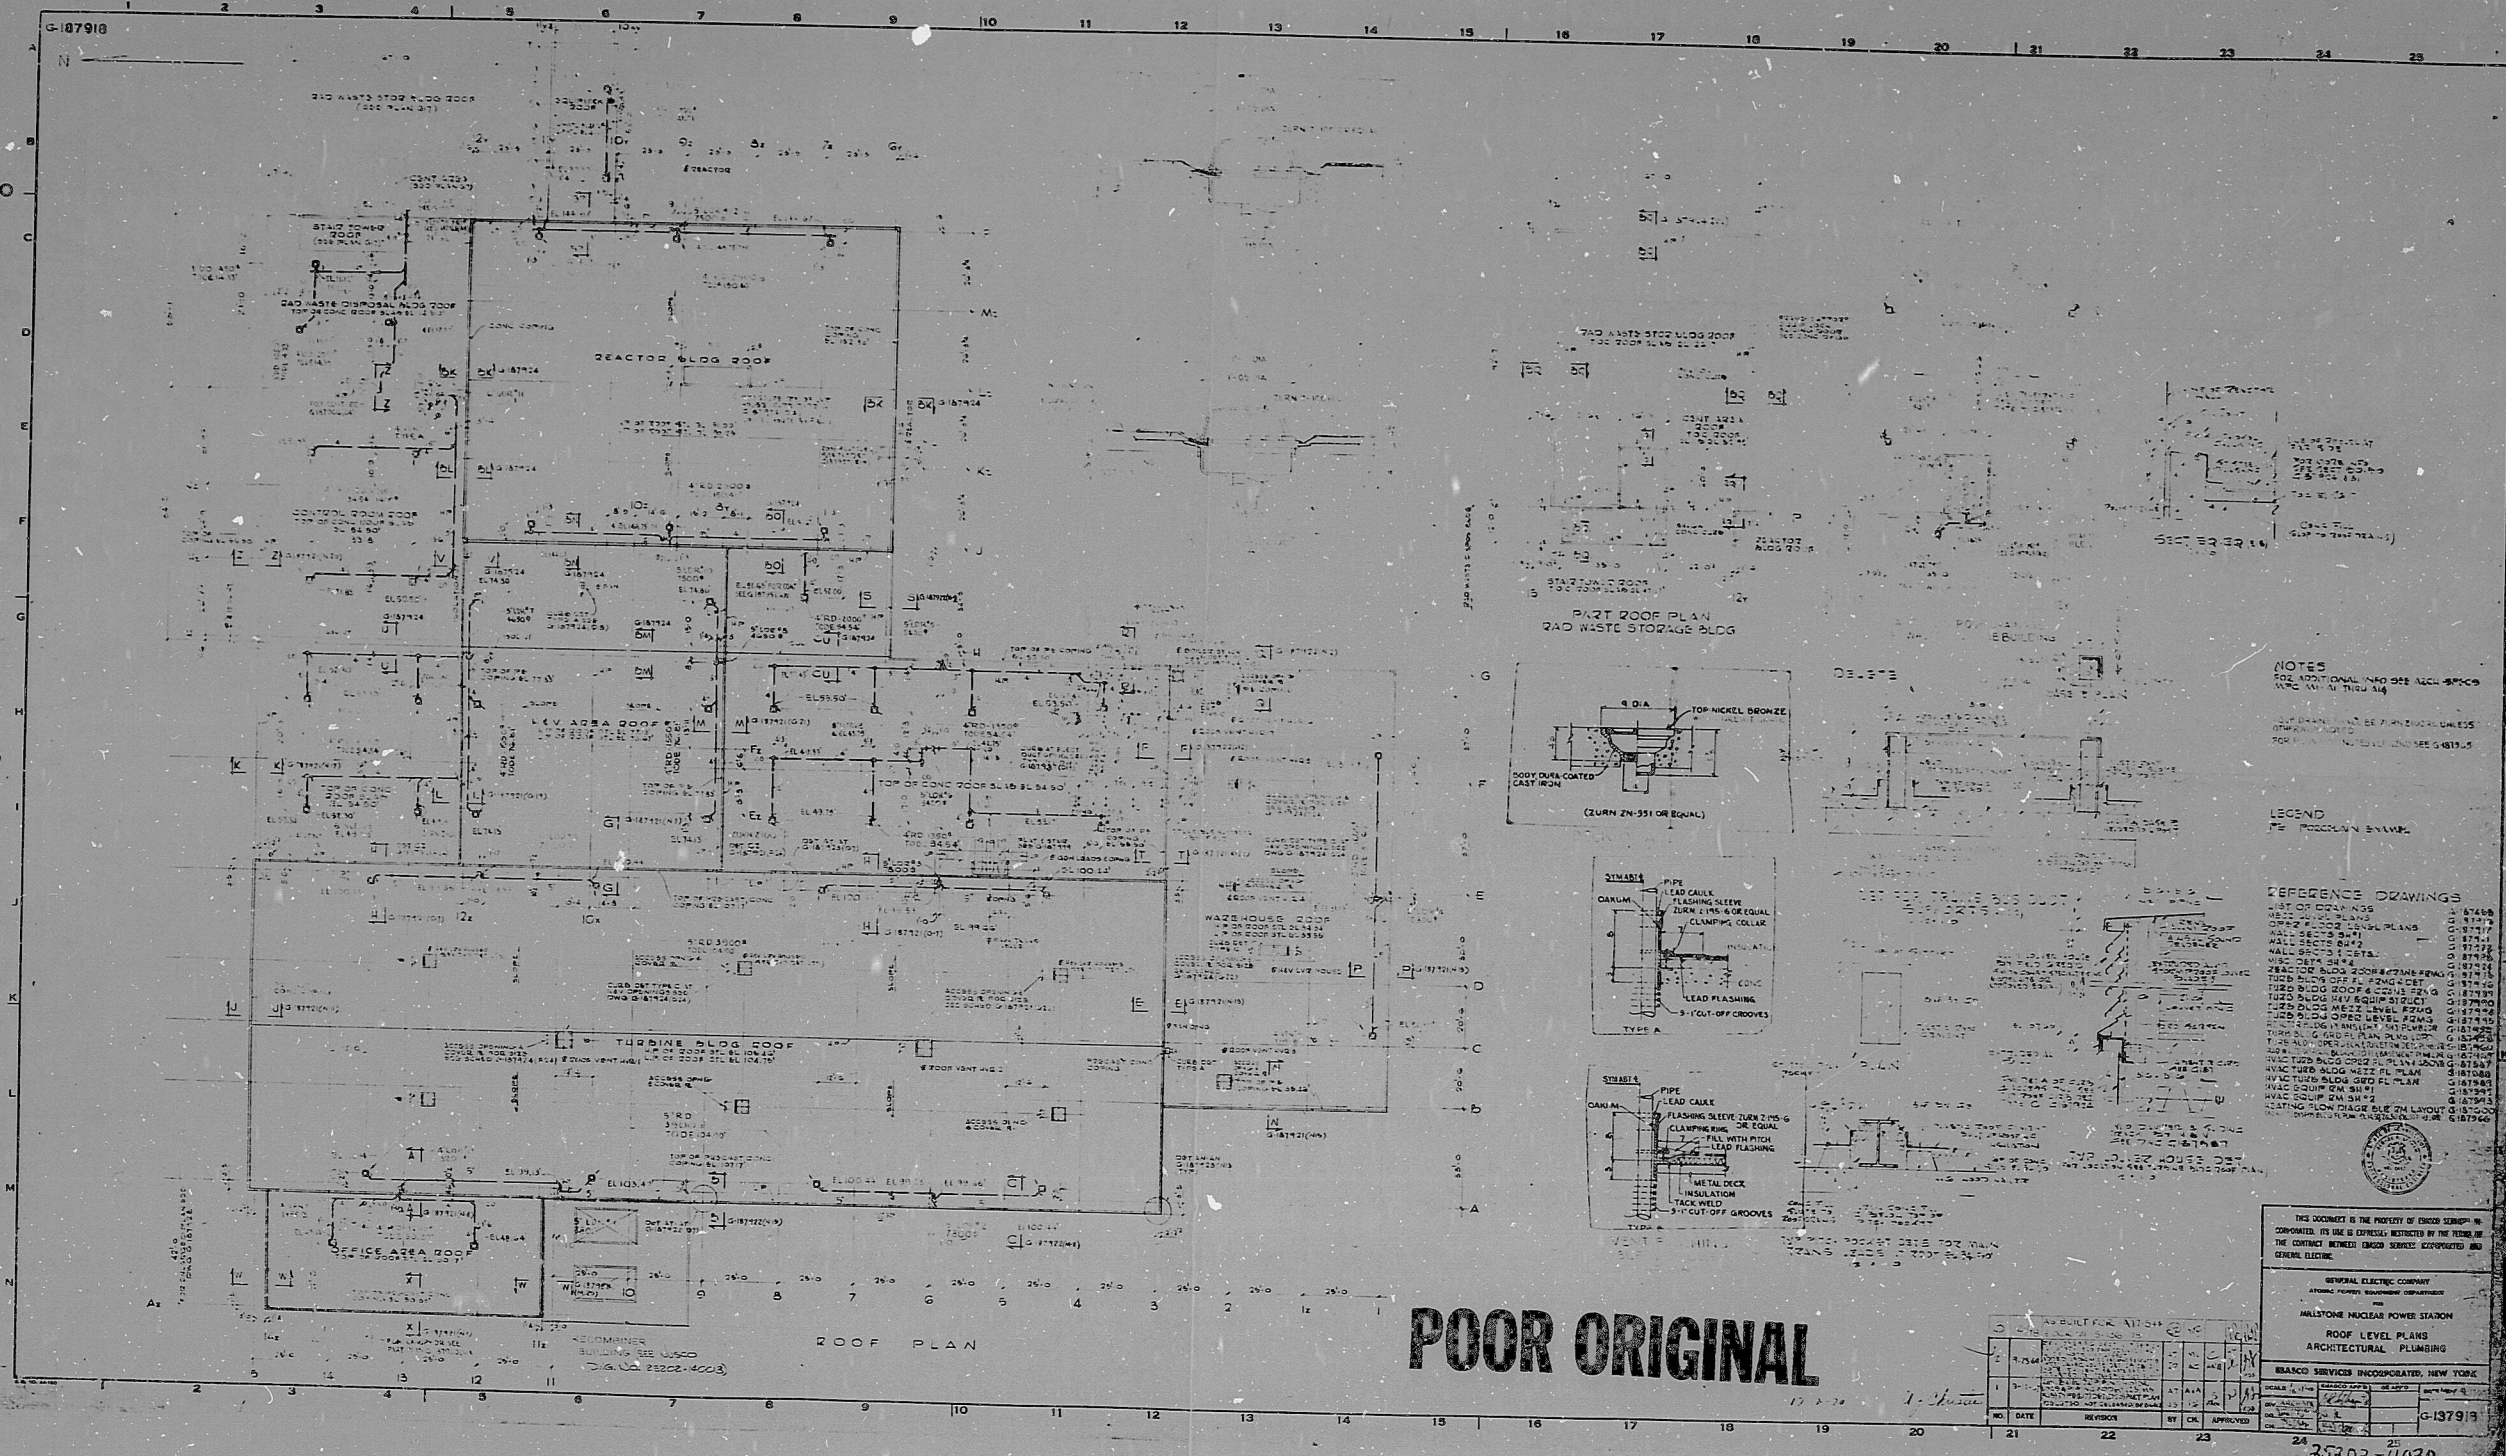

PRC
APERTURE
CARD

8205030484

RIDS

8205030484

