


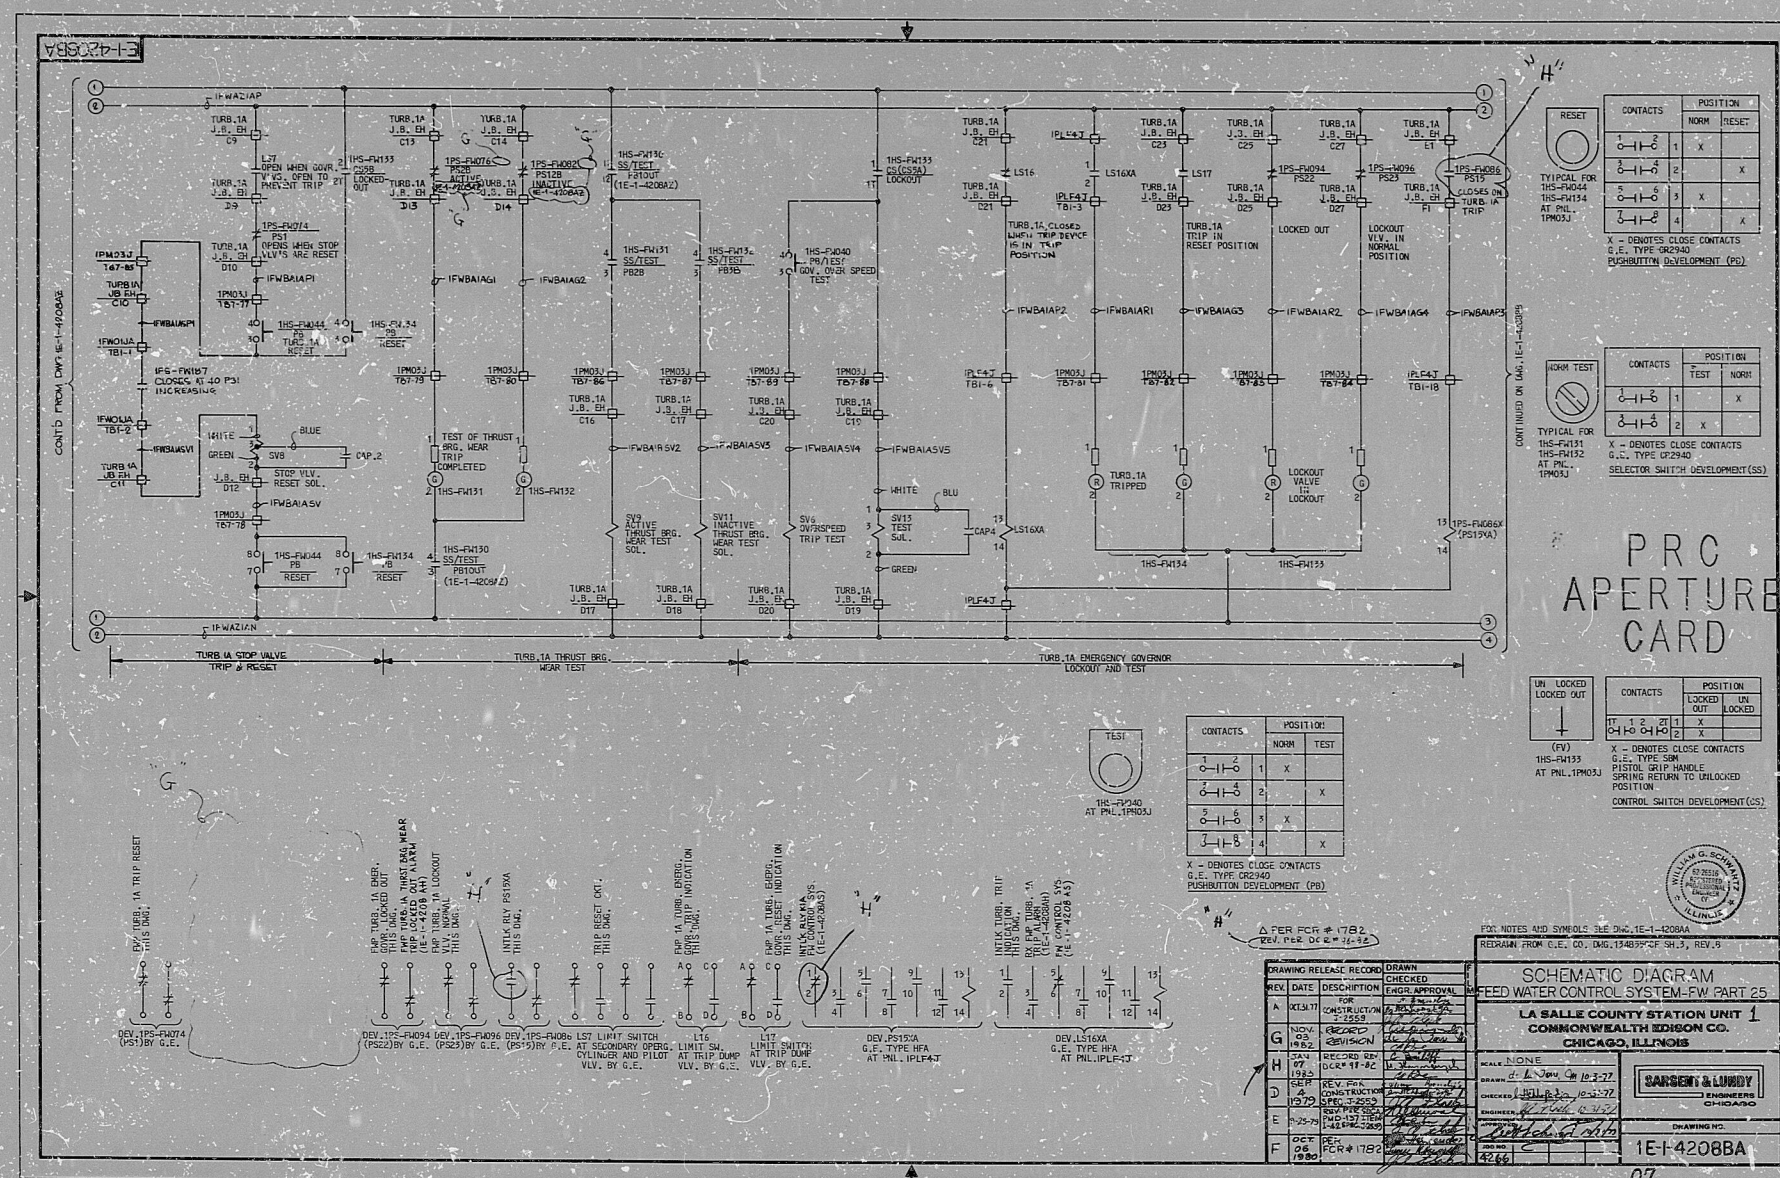

RIDS

8308240758

