


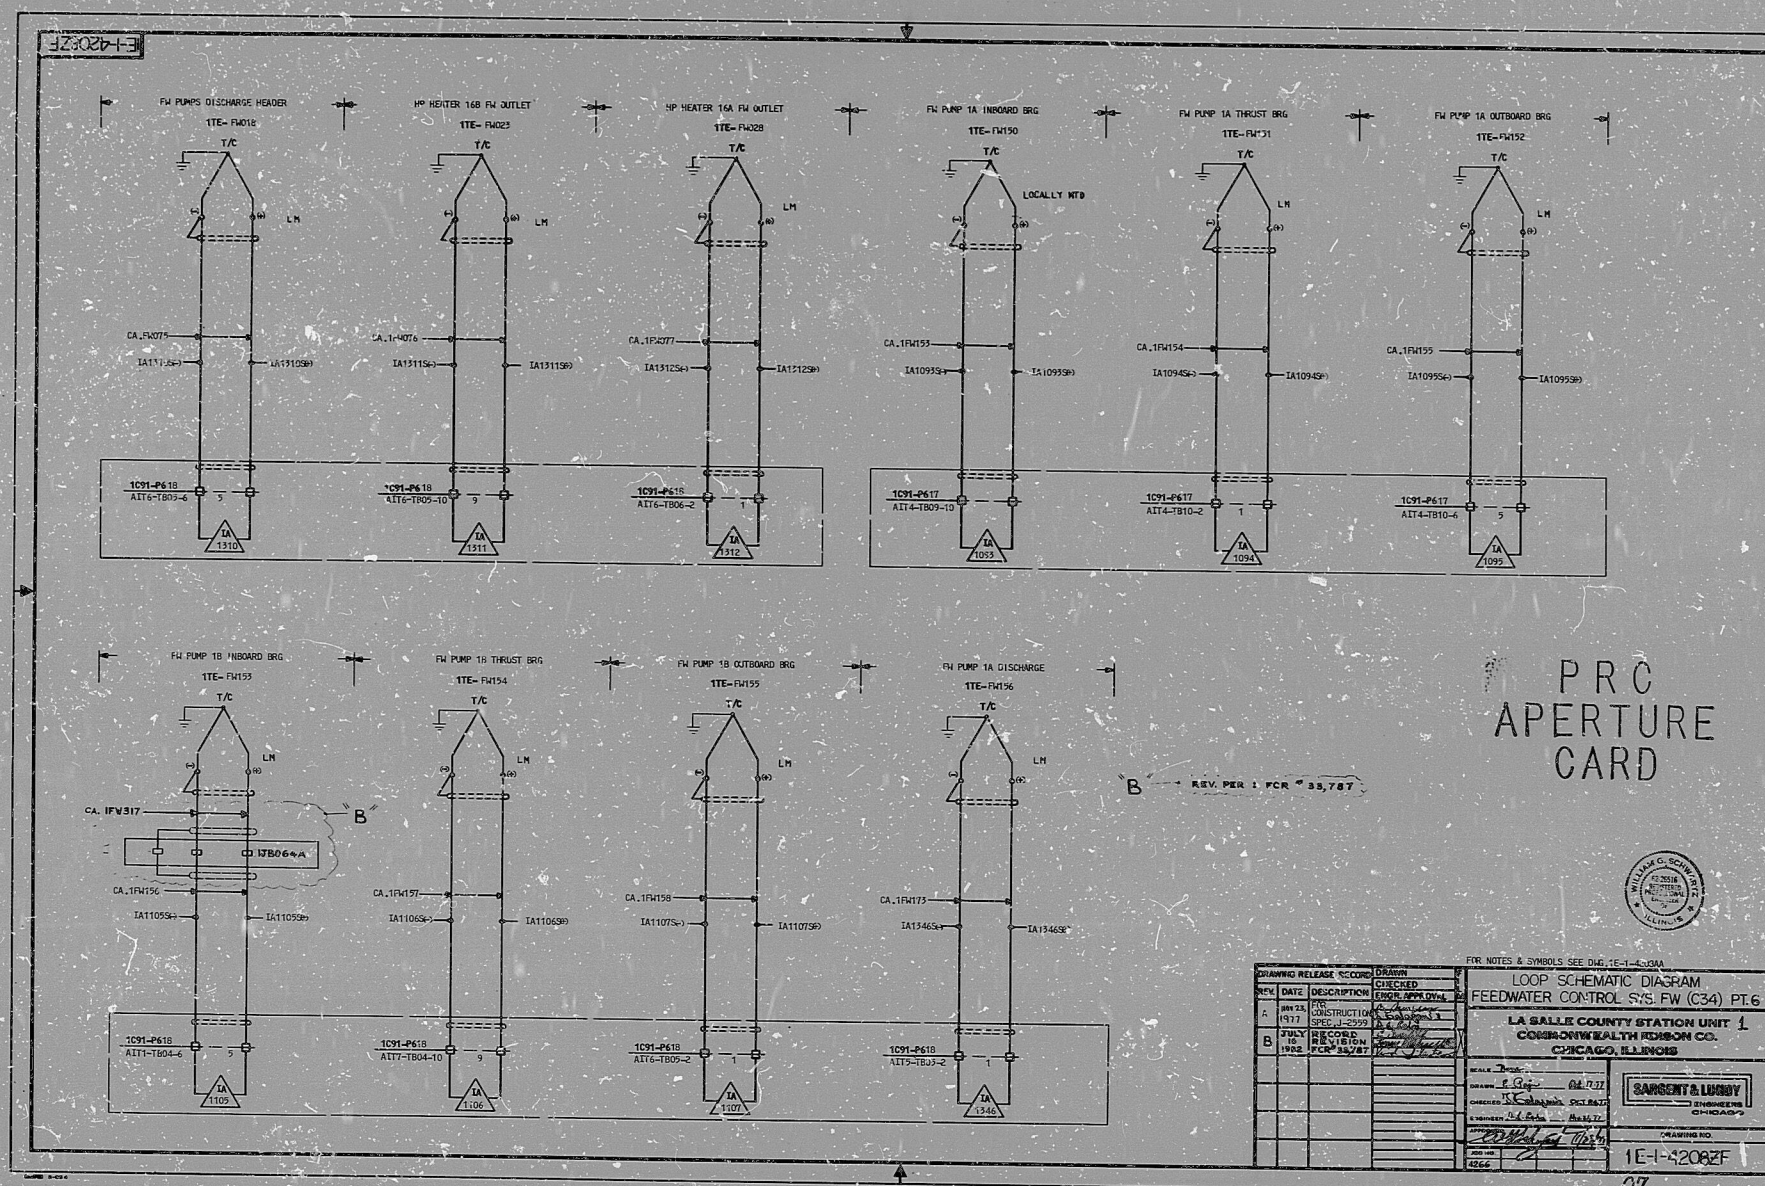

PRC  
APERTURE  
CARD



LOOP SCHEMATIC DIAGRAM  
FEEDWATER CONTROL S/S FW (C34) PT.6  
LA SALLE COUNTY STATION UNIT 1  
COMMONWEALTH EDISON CO.  
CHICAGO, ILLINOIS

ENGINEERS  
CHICAGO, ILLINOIS

1E-1-4208ZF  
27

# RIDS

8308240779

