


POOR ORIGINAL

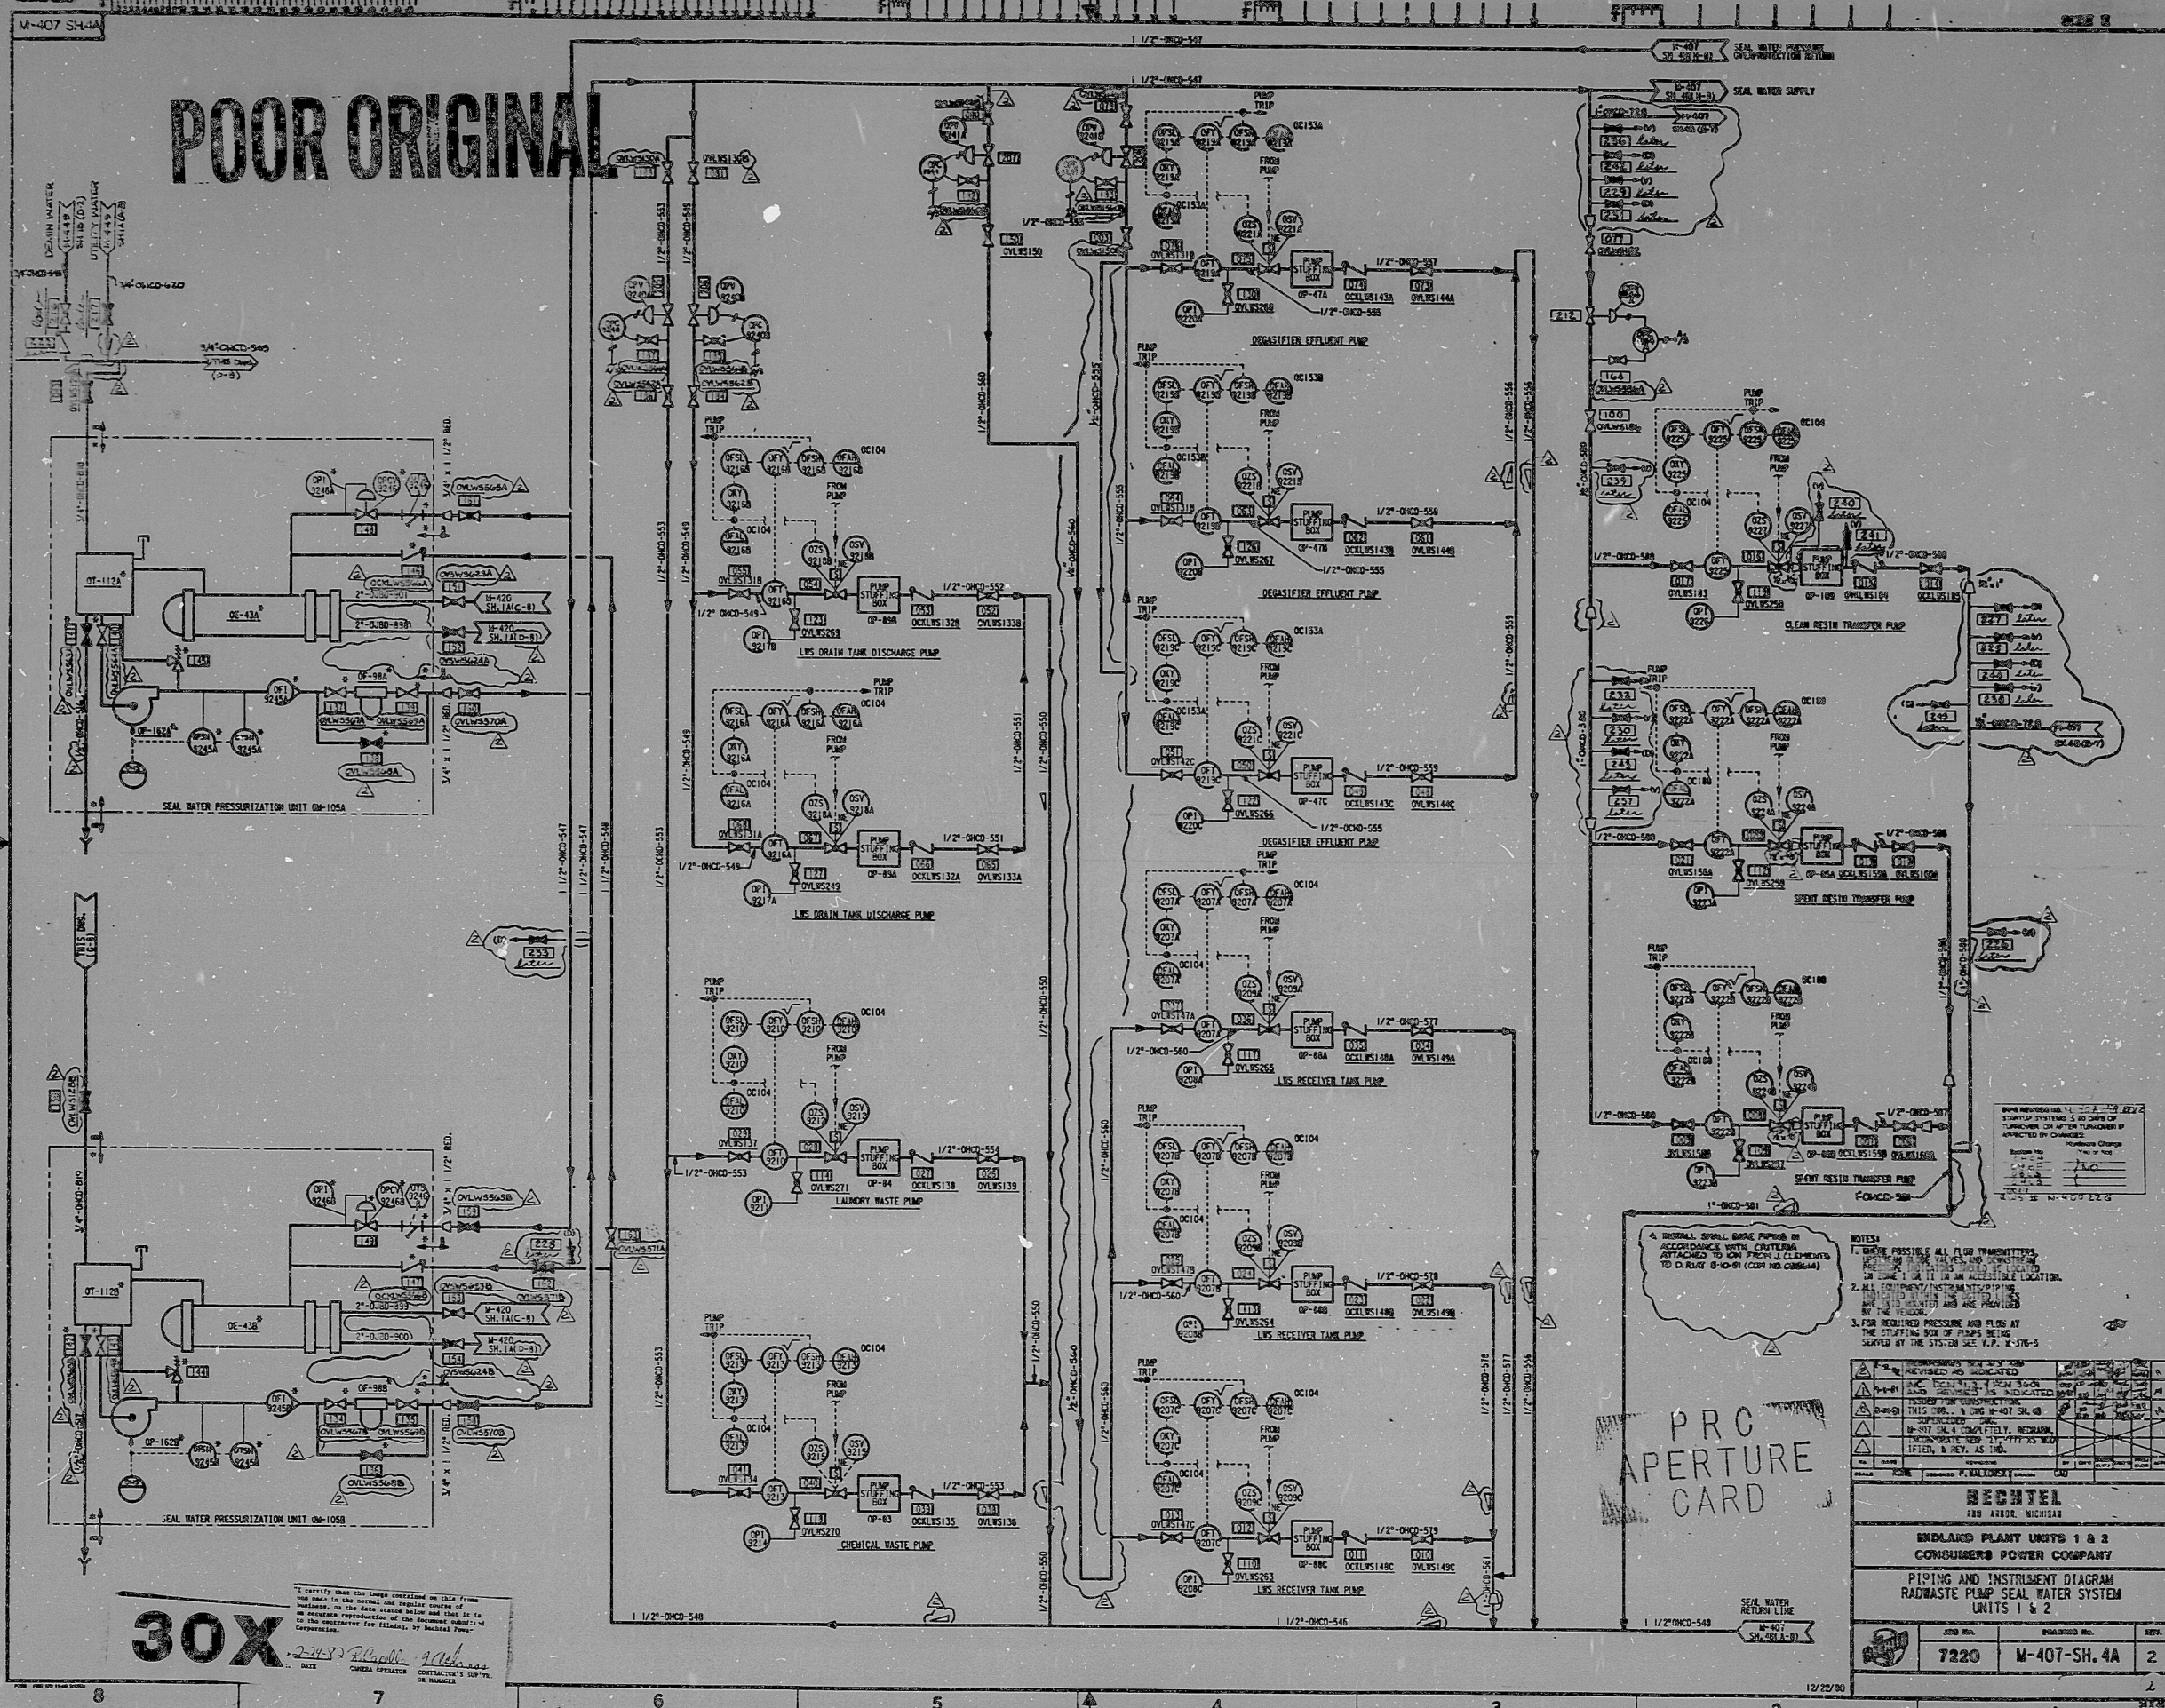

REVISIONS		
NO.	DESCRIPTION	DATE
1	REVISED AS INDICATED	12/22/80
2	REVISED AS INDICATED	12/22/80
PRC
APERTURE
CARD

30X

DATE 12/22/80

RIDS

8205050181

