


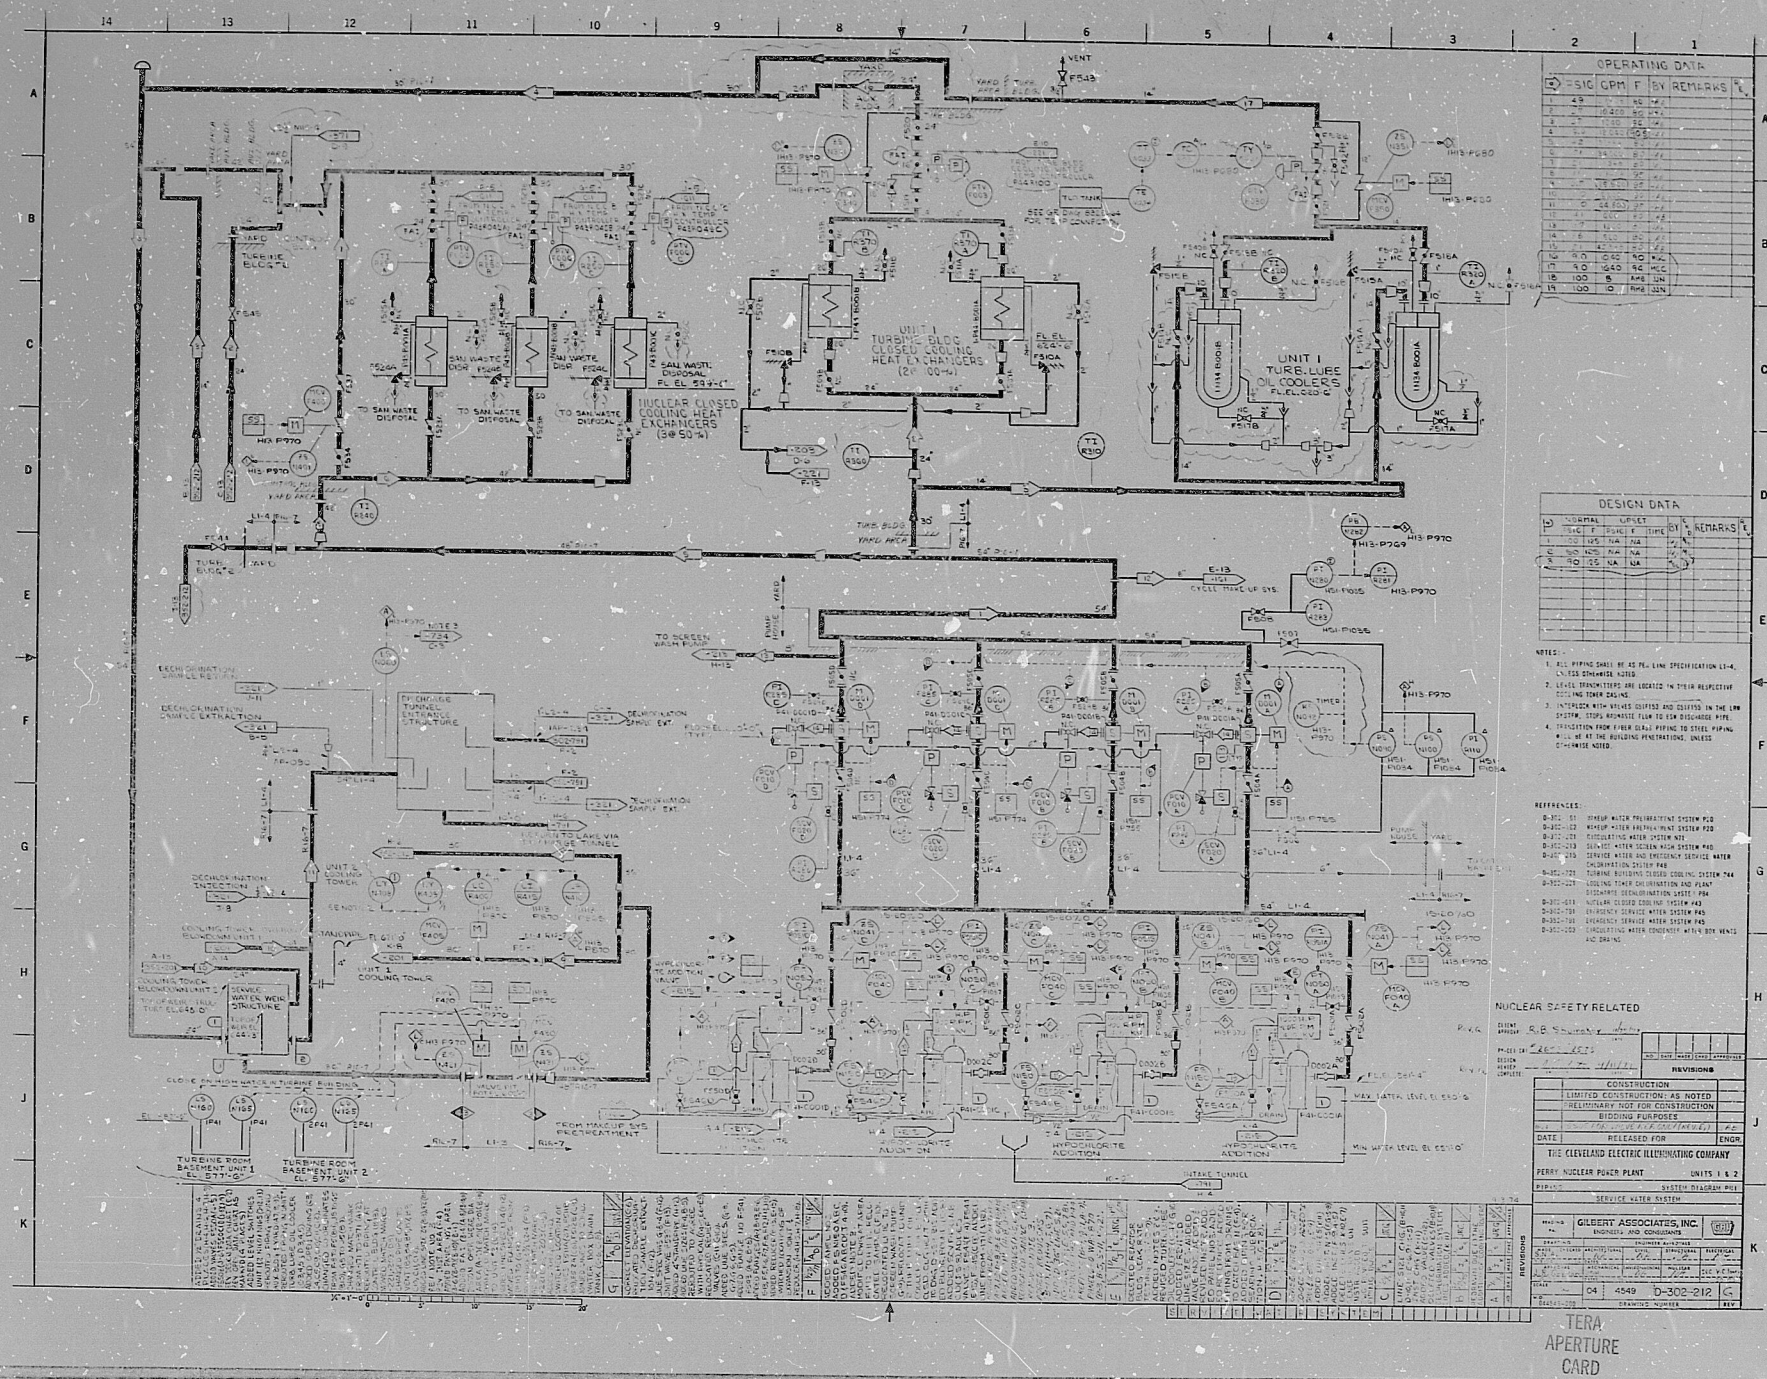

RUC-POR

7103180286

