


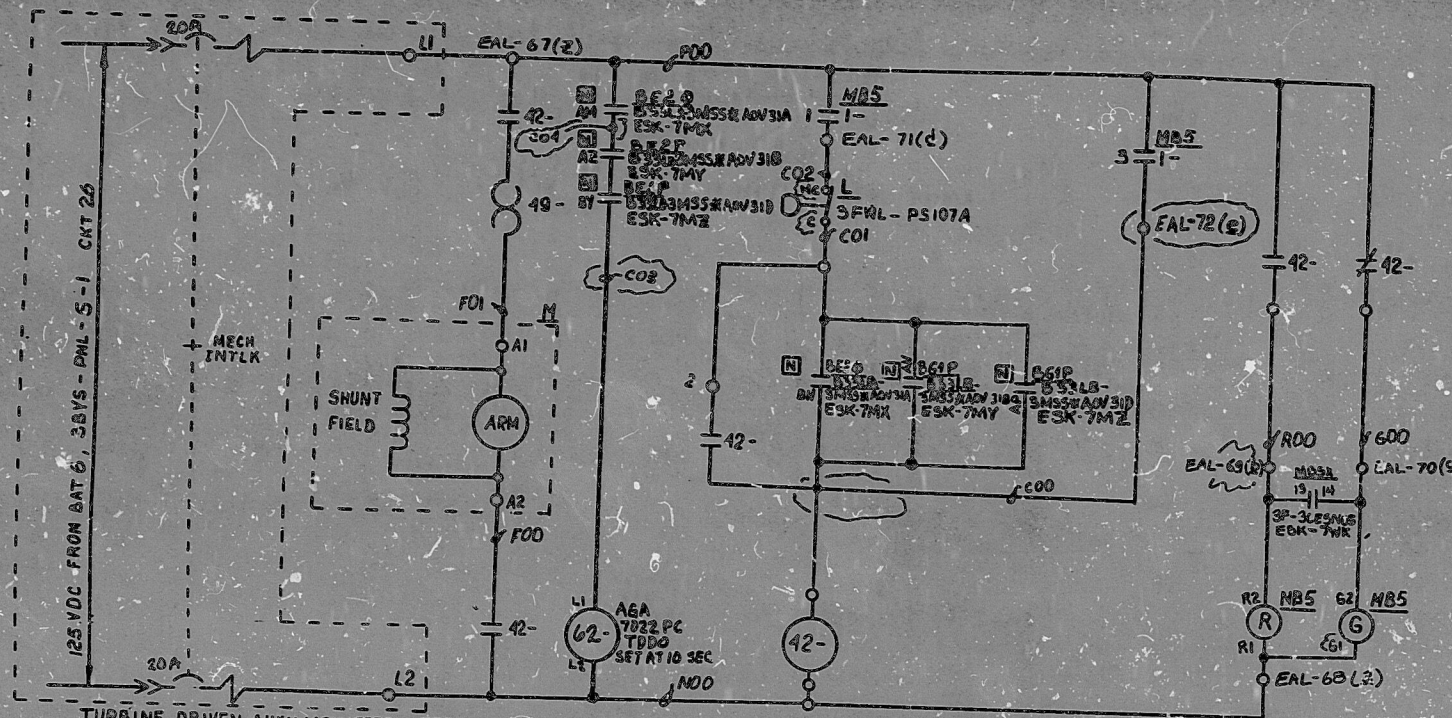
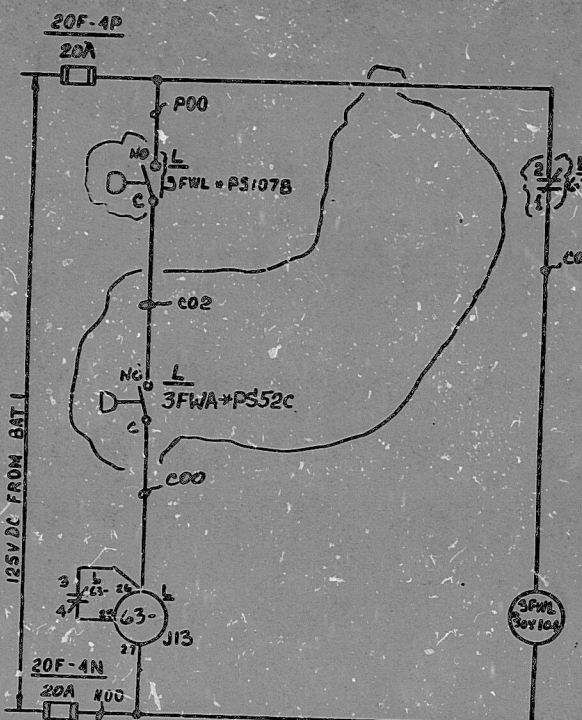
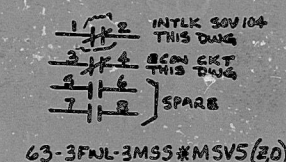
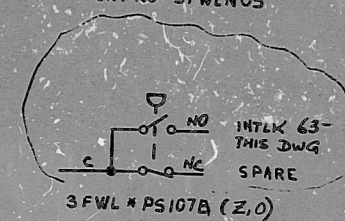
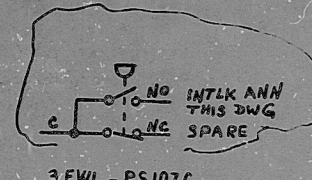


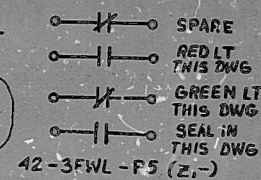

TURBINE DRIVEN AUXILIARY FEEDWATER PUMP AUXILIARY OIL PUMP [3FWL-P5] (Z,-) CNT NO. 3FWLN02

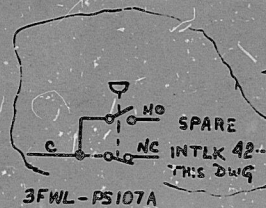


TURBINE TRIP AND THROTTLE VALVE TRIP SCHEME [3MSS-MSV5] (Z,0) CNT NO. 3FWLN03

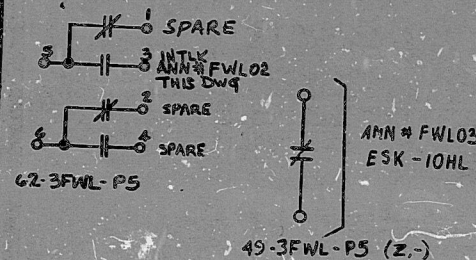

NOTES

1. ALL EQUIPMENT LOCATED ADJACENT TO TDAFW PP AUX OIL PP UNLESS OTHERWISE NOTED
2. REF LOGIC DIAG (LSK 7-3.2) ISSUE 5+

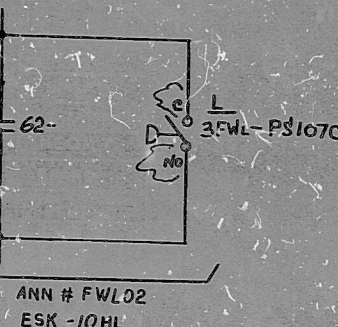

CS
1-3FWL-P5

DIAG
"BL"

ESH
3K

SPARES
2,4

NUCLEAR SAFETY RELATED QA CAT II

REV	DATE	DESCRIPTION	BY	CHK	APP
1	7-1-77	CHANGES CIRCLED	VP	SC	SC
2	7-1-77	CHANGES CIRCLED	VP	SC	SC
11
APERTURE
CARD

PDR RIDS

8504240423

