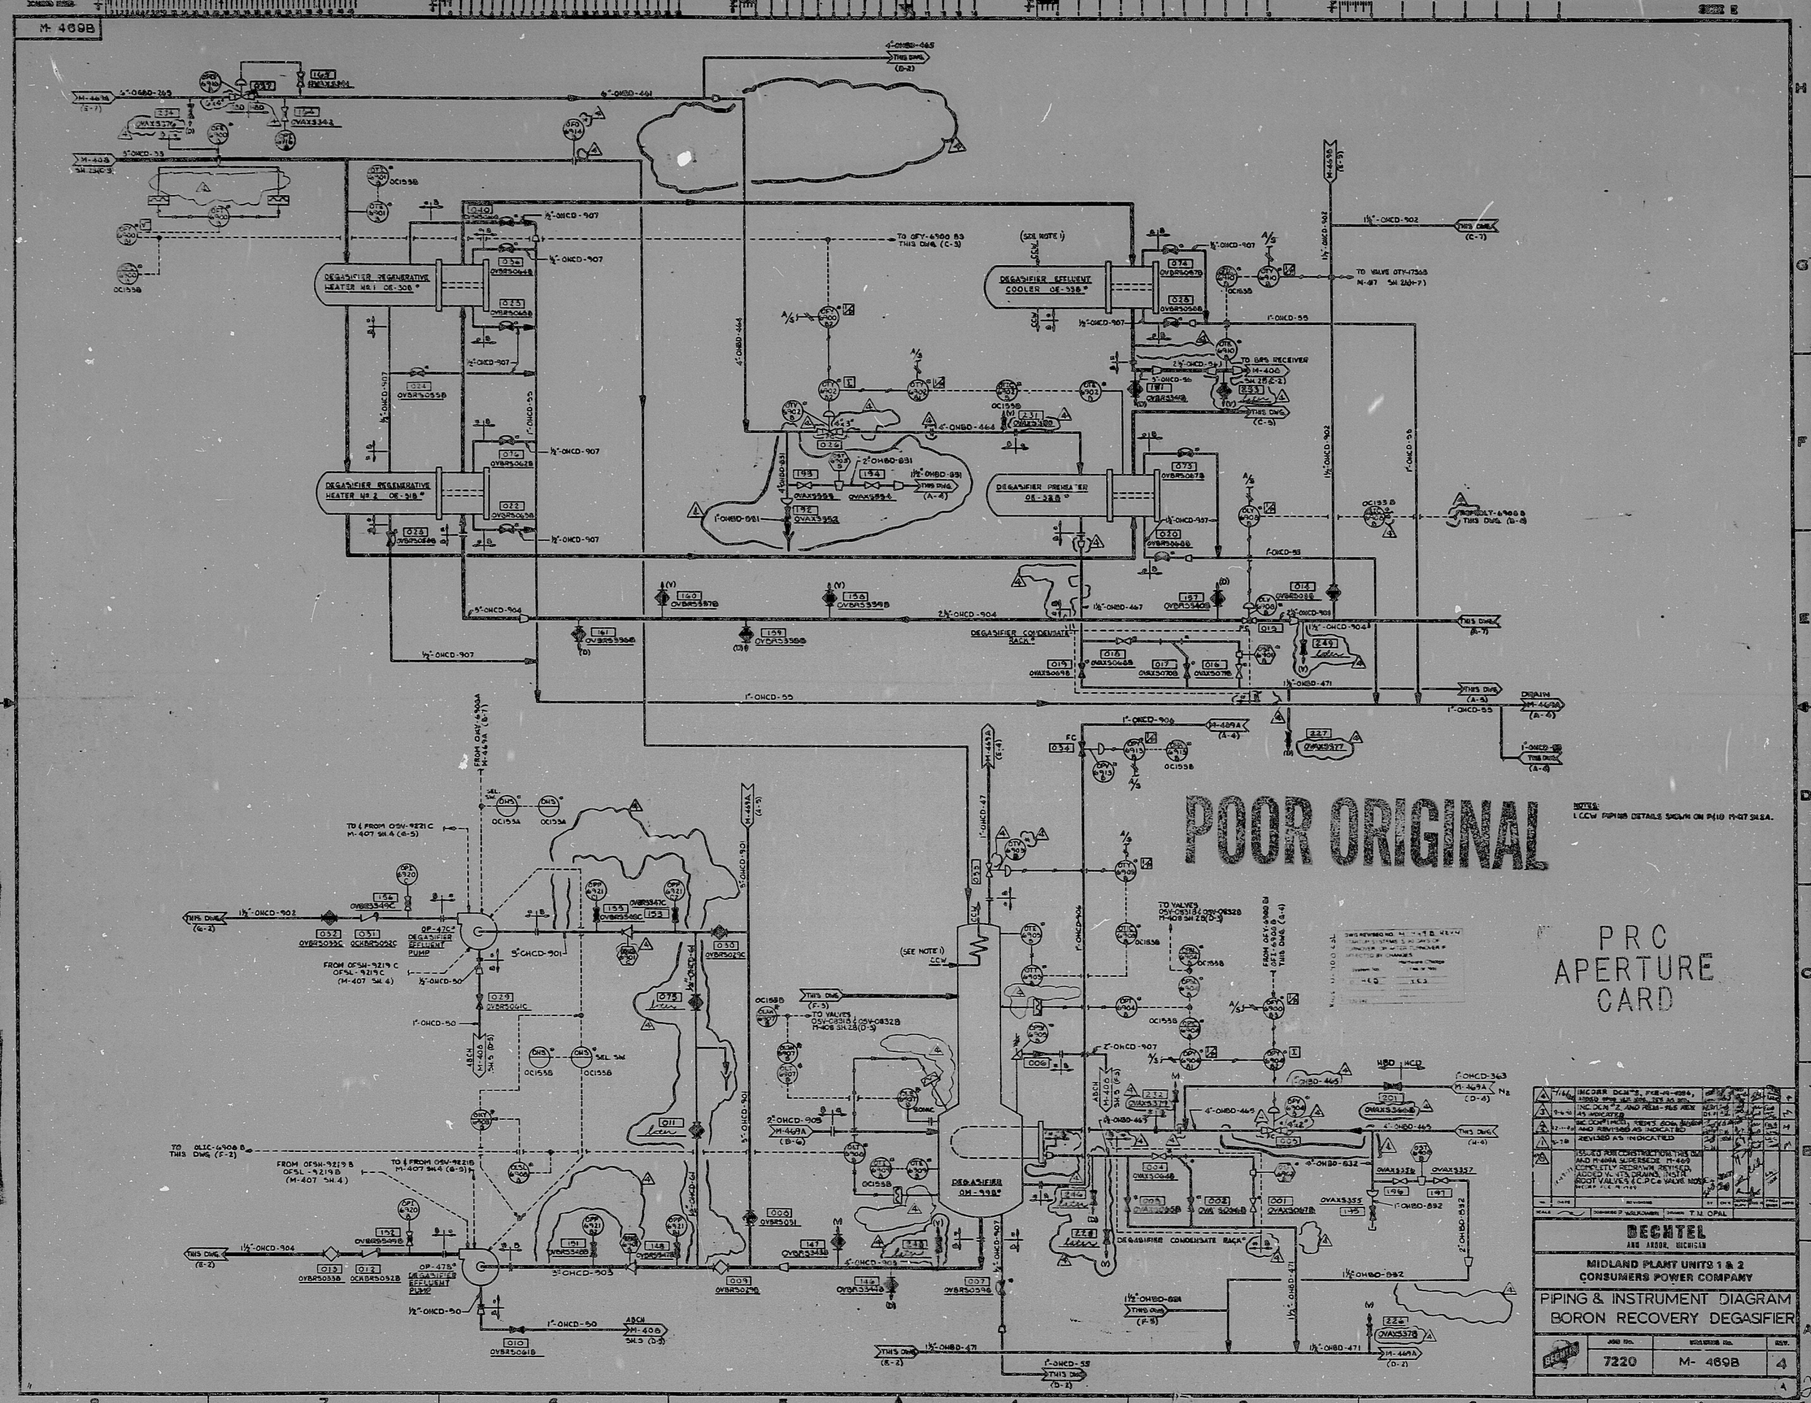
M- 469B
DEGASIFIER REGENERATIVE HEATER No. 1 OE-308*
DEGASIFIER REGENERATIVE HEATER No. 2 OE-318*
DEGASIFIER EFFLUENT COOLER OE-338*
DEGASIFIER PREHEATER OE-328*
DEGASIFIER CONDENSATE RACK*
DEGASIFIER OM-498*
OP-476* DEGASIFIER EFFLUENT PUMP
OP-478* DEGASIFIER EFFLUENT PUMP
POOR ORIGINAL
PRC APERTURE CARD
BECHTEL
ANN ARBOR, MICHIGAN
MIDLAND PLANT UNITS 1 & 2
CONSUMERS POWER COMPANY
PIPING & INSTRUMENT DIAGRAM
BORON RECOVERY DEGASIFIER
7220
M- 469B
4

RIDS

8205050402

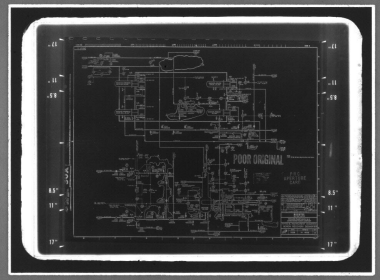

M:'M 5324 — FILMSORT® Brand Aperture & Camera Cards and DUPLICARD® Brand Copy Cards — Product of 3M Company, St. Paul, Minn.