


DRAWING RM78-682-E15
NUMBER 5/31/79
CHECKED BY SKV
APPROVED BY JST
3-8-79
DRAWN BY M.K.

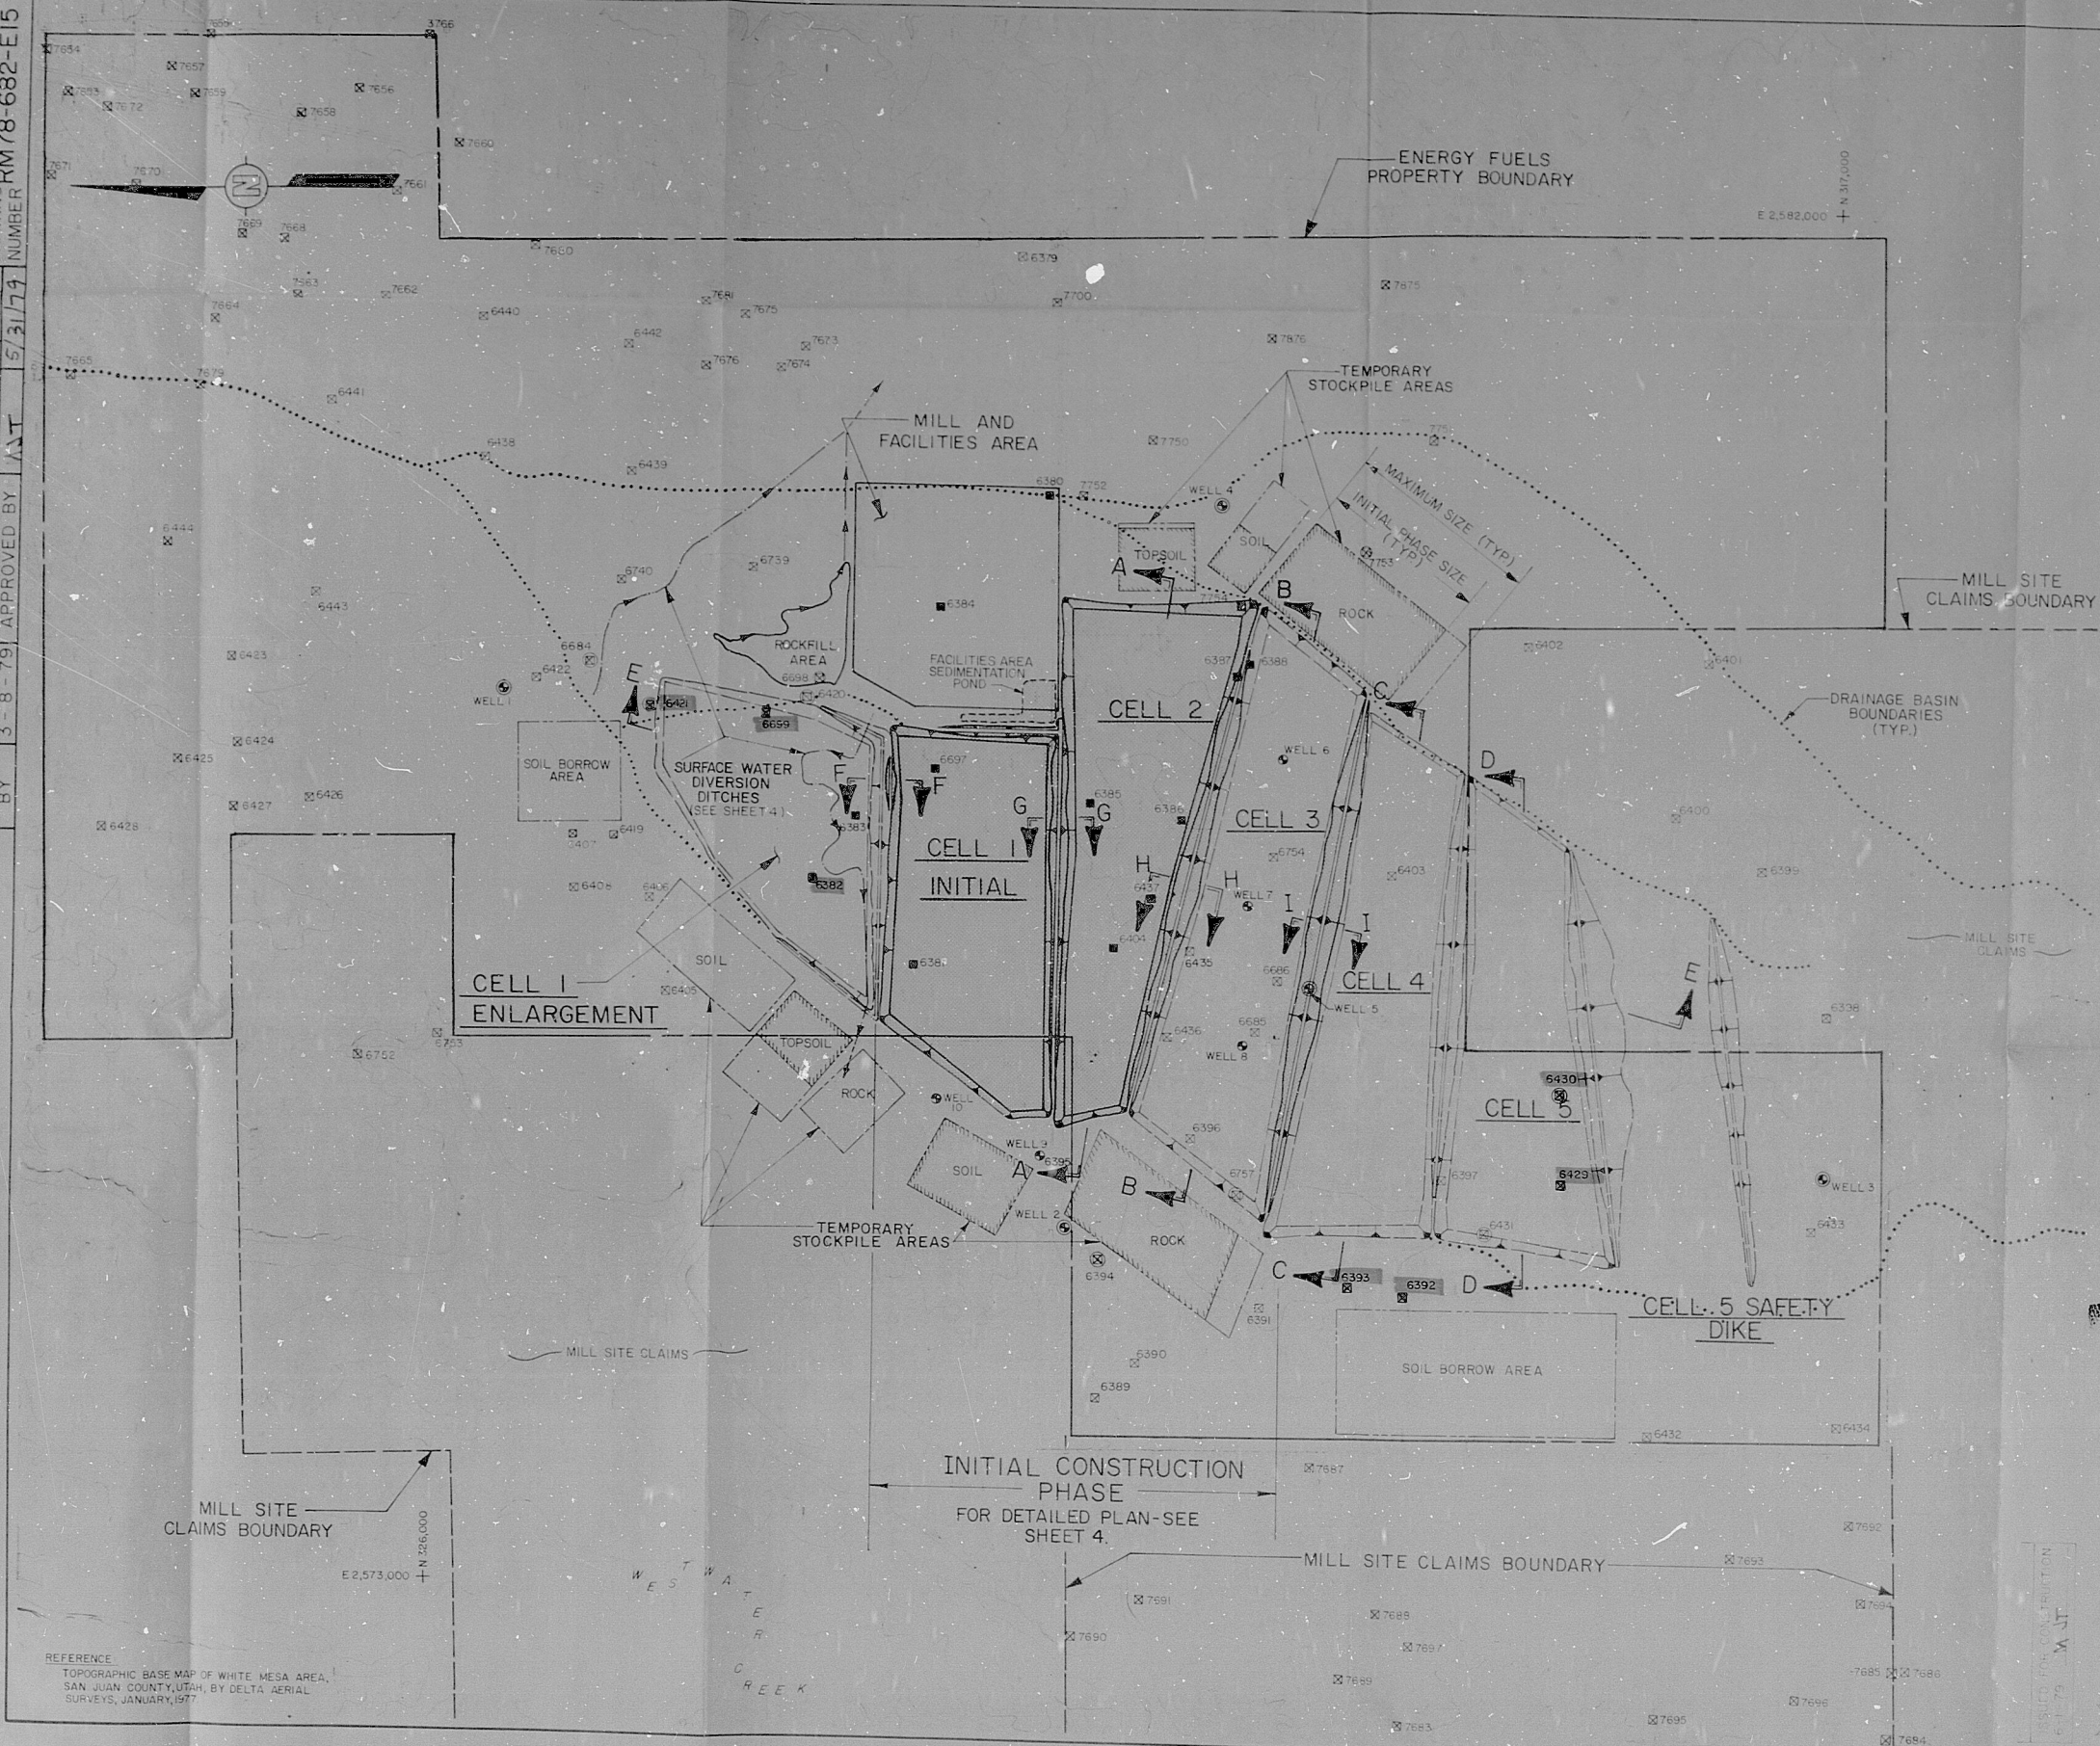


LEGEND

- DEEP GROUNDWATER MONITORING WELLS TO BE INSTALLED
- LOW, TWIN MONITORING WELLS TO BE INSTALLED
- ARCHAEOLOGICAL SITES FROM ENVIRONMENTAL REPORT WHITE MESA DRUM PROJECT, JANUARY 1978, LOCATIONS ARE APPROXIMATE AND ARE EXTENT UNSPECIFIED
- ARCHAEOLOGICAL SITES TO BE INVESTIGATED AND REMOVED
- ARCHAEOLOGICAL SITES POSSIBLY REQUIRING LOCAL MODIFICATION TO CELL LAYOUTS TO AVOID DISTURBANCE TO LOCATION AND AREAL EXTENT TO BE DETERMINED BY OTHERS. LAYOUT ADJUSTMENTS IN THE FIELD TO BE MADE AT THE DISCRETION OF THE ENGINEER.
- AREAS OF INITIAL PHASE CONSTRUCTION

NOTES

- SEE SHEETS 4, 5, AND 6 FOR DETAILED LAYOUTS OF CELLS
- SEE SHEET 7 FOR SECTIONS A-A, B-B, AND C-C
- SEE SHEET 8 FOR SECTIONS D-D AND E-E
- SEE SHEET 9 FOR SECTION F-F
- SEE SHEET 10 FOR SECTION G-G AND H-H, AND SHEET 11 FOR SECTION I-I

- Archaeological Sites Referenced in 4-7-82 letter to NRC

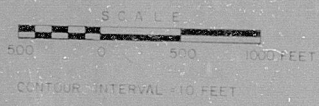

PRO APERTURE CARD SHEET 2 OF 16

GENERAL ARRANGEMENT
TAILINGS MANAGEMENT SYSTEM

PREPARED FOR

ENERGY FUELS NUCLEAR, INC.
DENVER, COLORADO

D'APPOLONIA

8205110069

REFERENCE
TOPOGRAPHIC BASE MAP OF WHITE MESA AREA,
SAN JUAN COUNTY, UTAH, BY DELTA AERIAL
SURVEYS, JANUARY 1977

PDR. DF.

8205110069

