


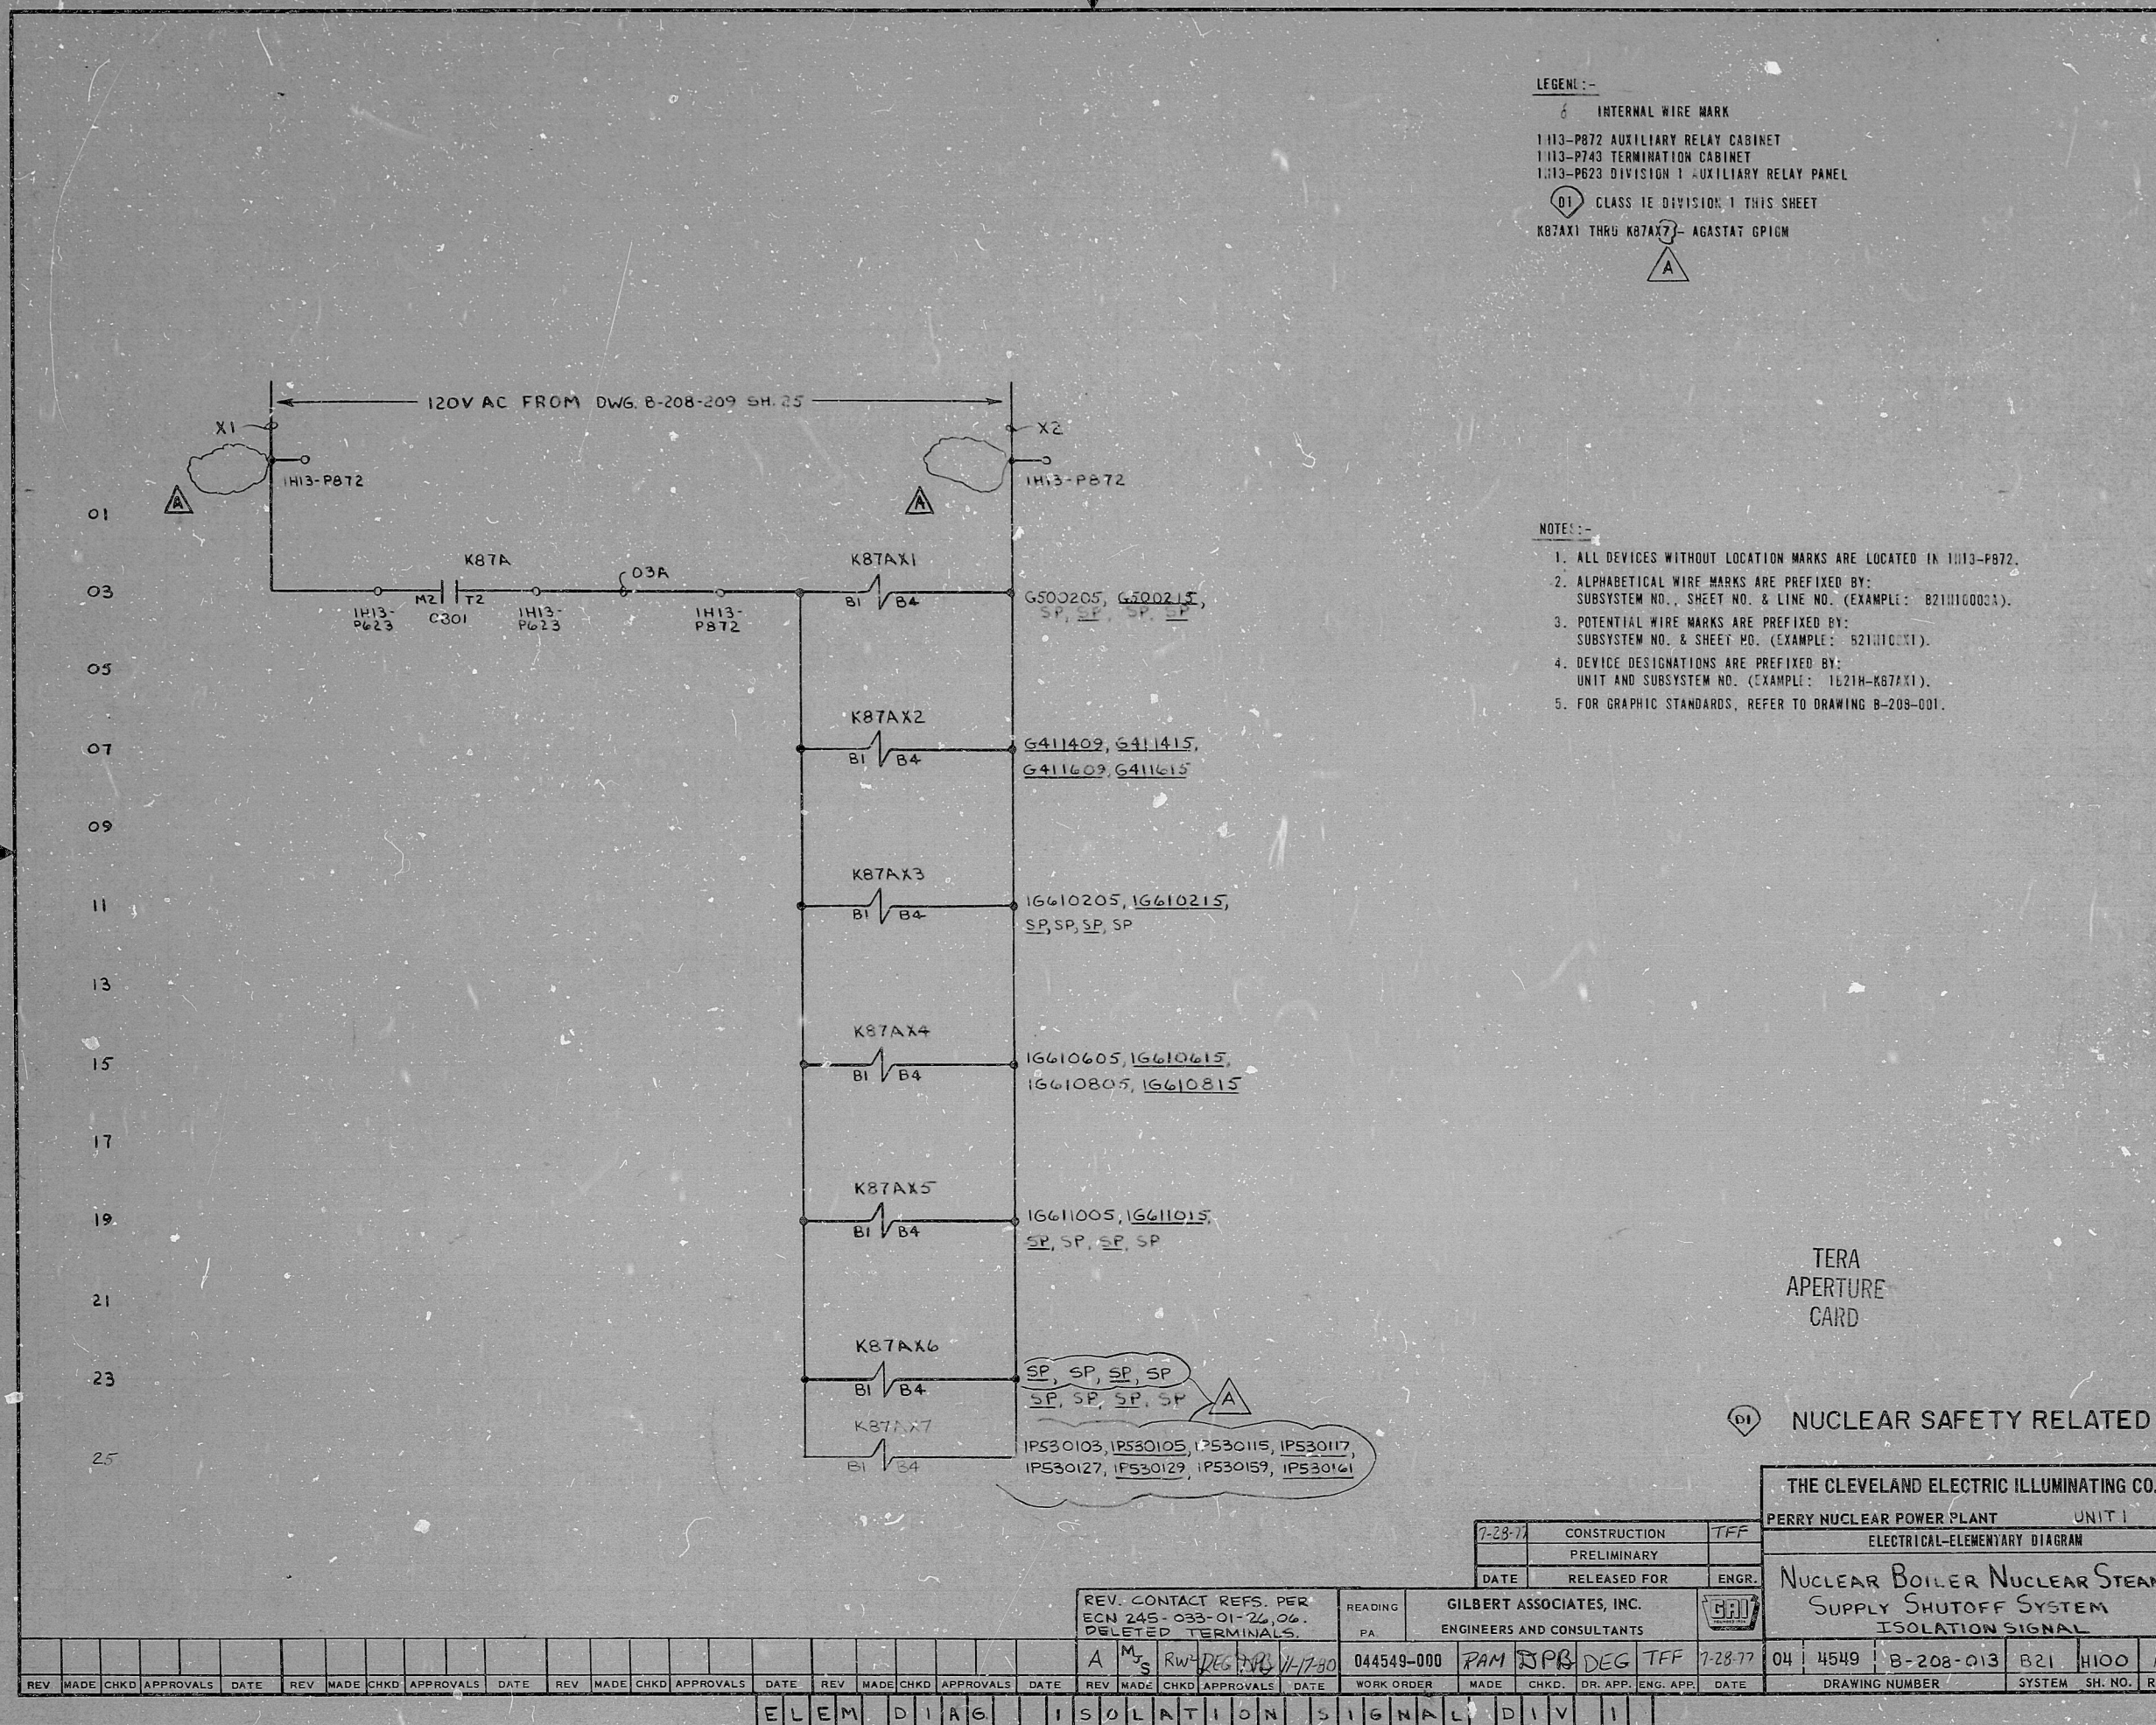



8103180811

