


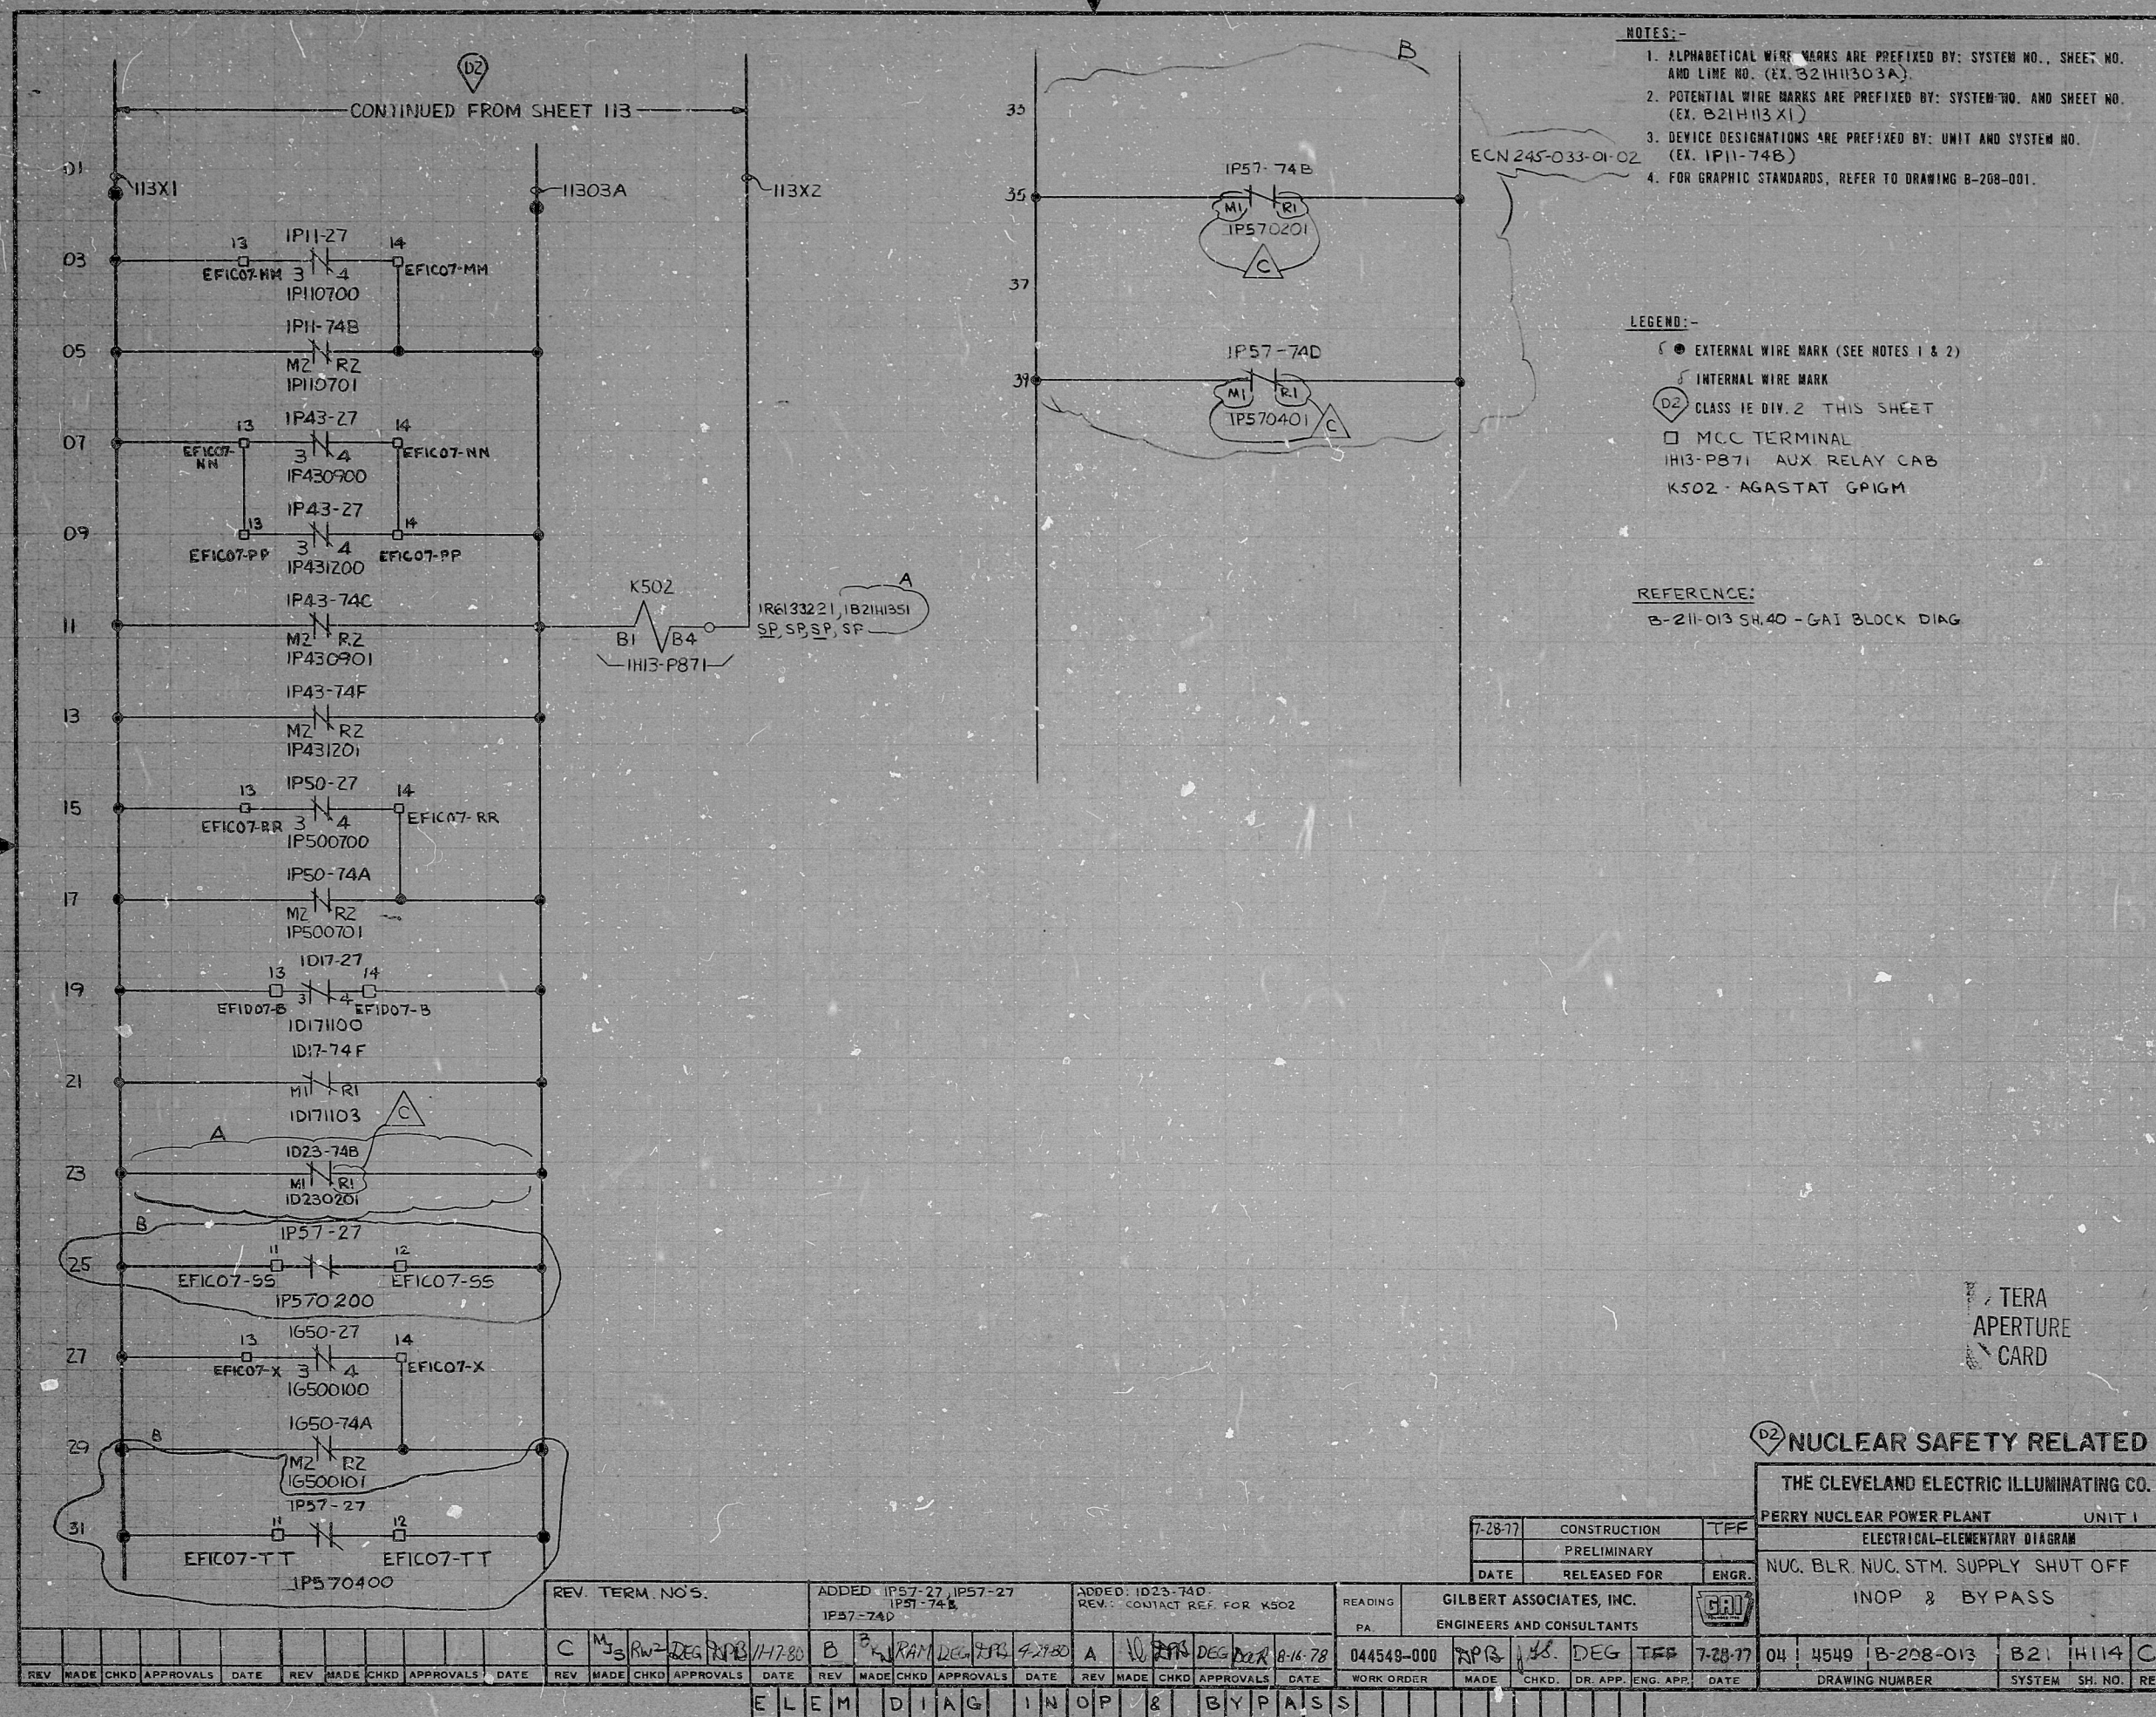



8103180912

