



This drawing and the design it covers are the property of BECHTEL. They are loaned to you for your information only. They are not to be reproduced, copied, loaned, exhibited, or used in any way without express written permission by the lender to the borrower.

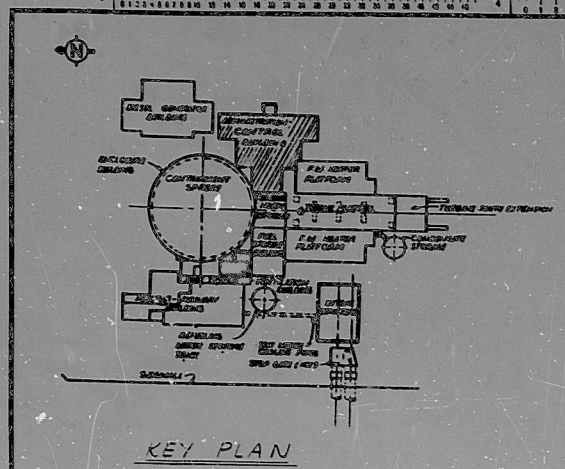


KEY PLAN

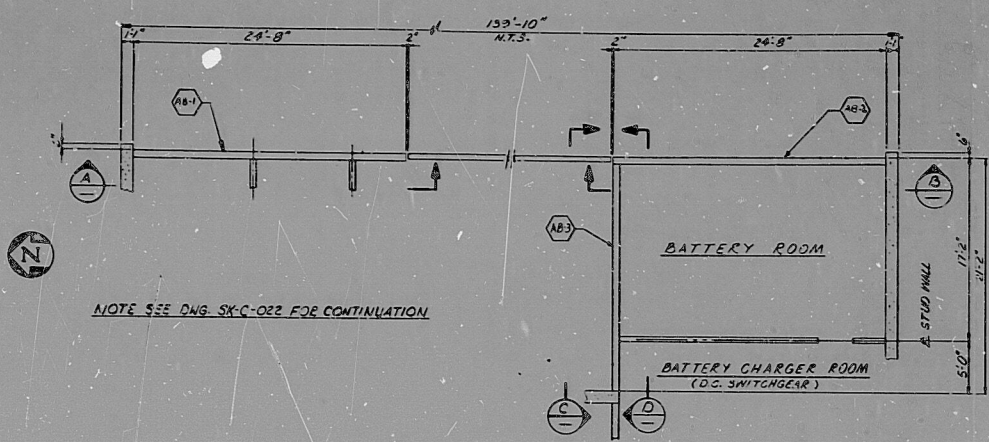


NOTE SEE DWS SK-C-022 FOR CONTINUATION


ADMINISTRATION BUILDING (PARTIAL PLAN)

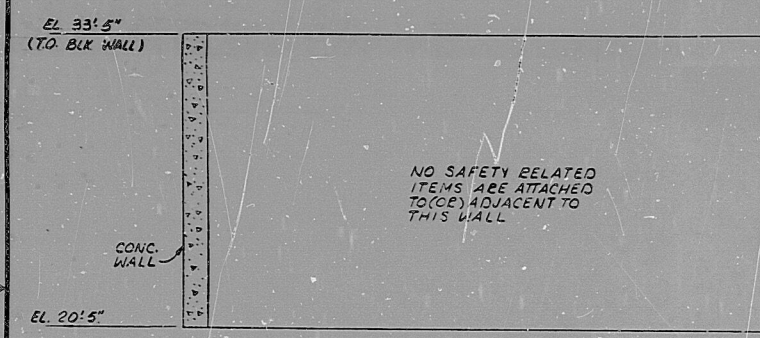


SECTION A

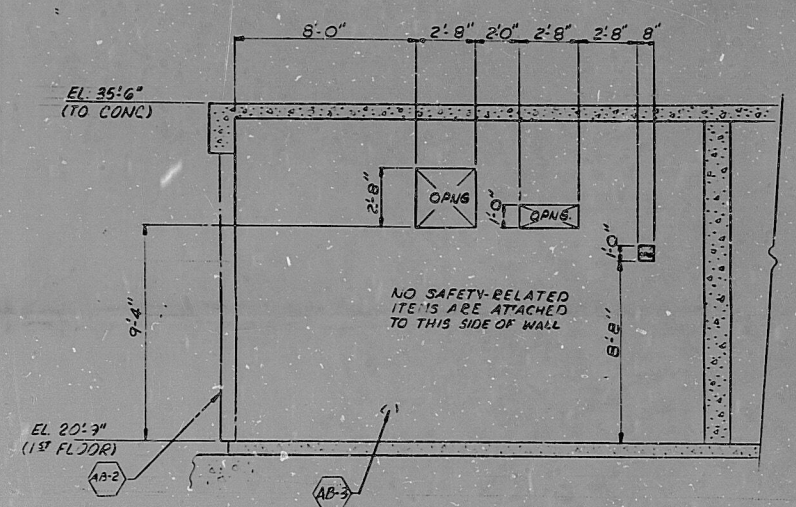

SECTION C

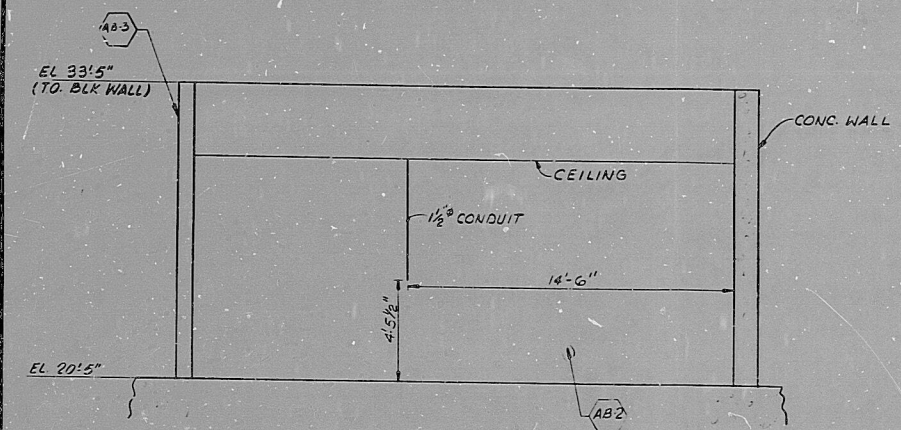

SECTION B

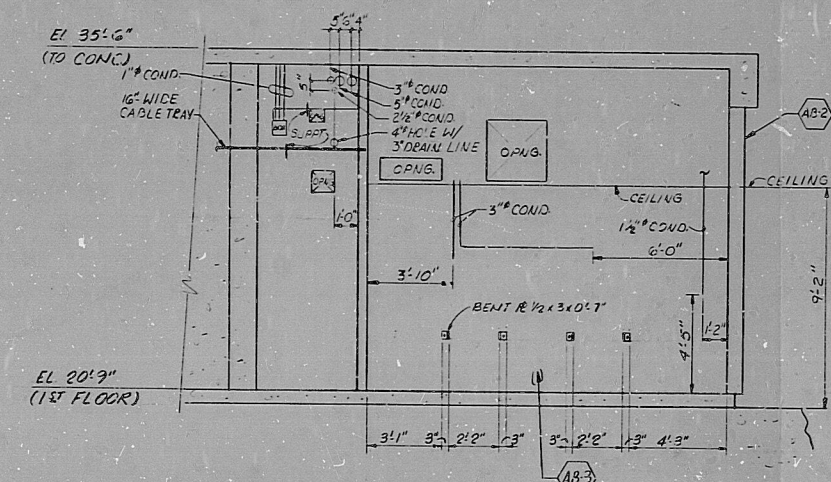

SECTION D

INSPECTION STATUS					
WALL NO.	SAFETY RELATED	FIELD REVIEWED	DATE	FIELD REVIEWED BY	DATE

Notes
1. For General Notes See DWS SK-C-001

RECHTEL	LOS ANGELES
UNIT I	SAN ONFRE NUCLEAR GEN. STATION
SOUTHERN CALIFORNIA EDISON CO.	
ADMINISTRATION BUILDING (PARTIAL PLAN)	
14E BULLETIN #80-11 DETAILS	
JOB NO.	DRAWING P.N.
14000-074	SK-C-023
REV.	B

820512.0240

RIDS.

8205120240

