


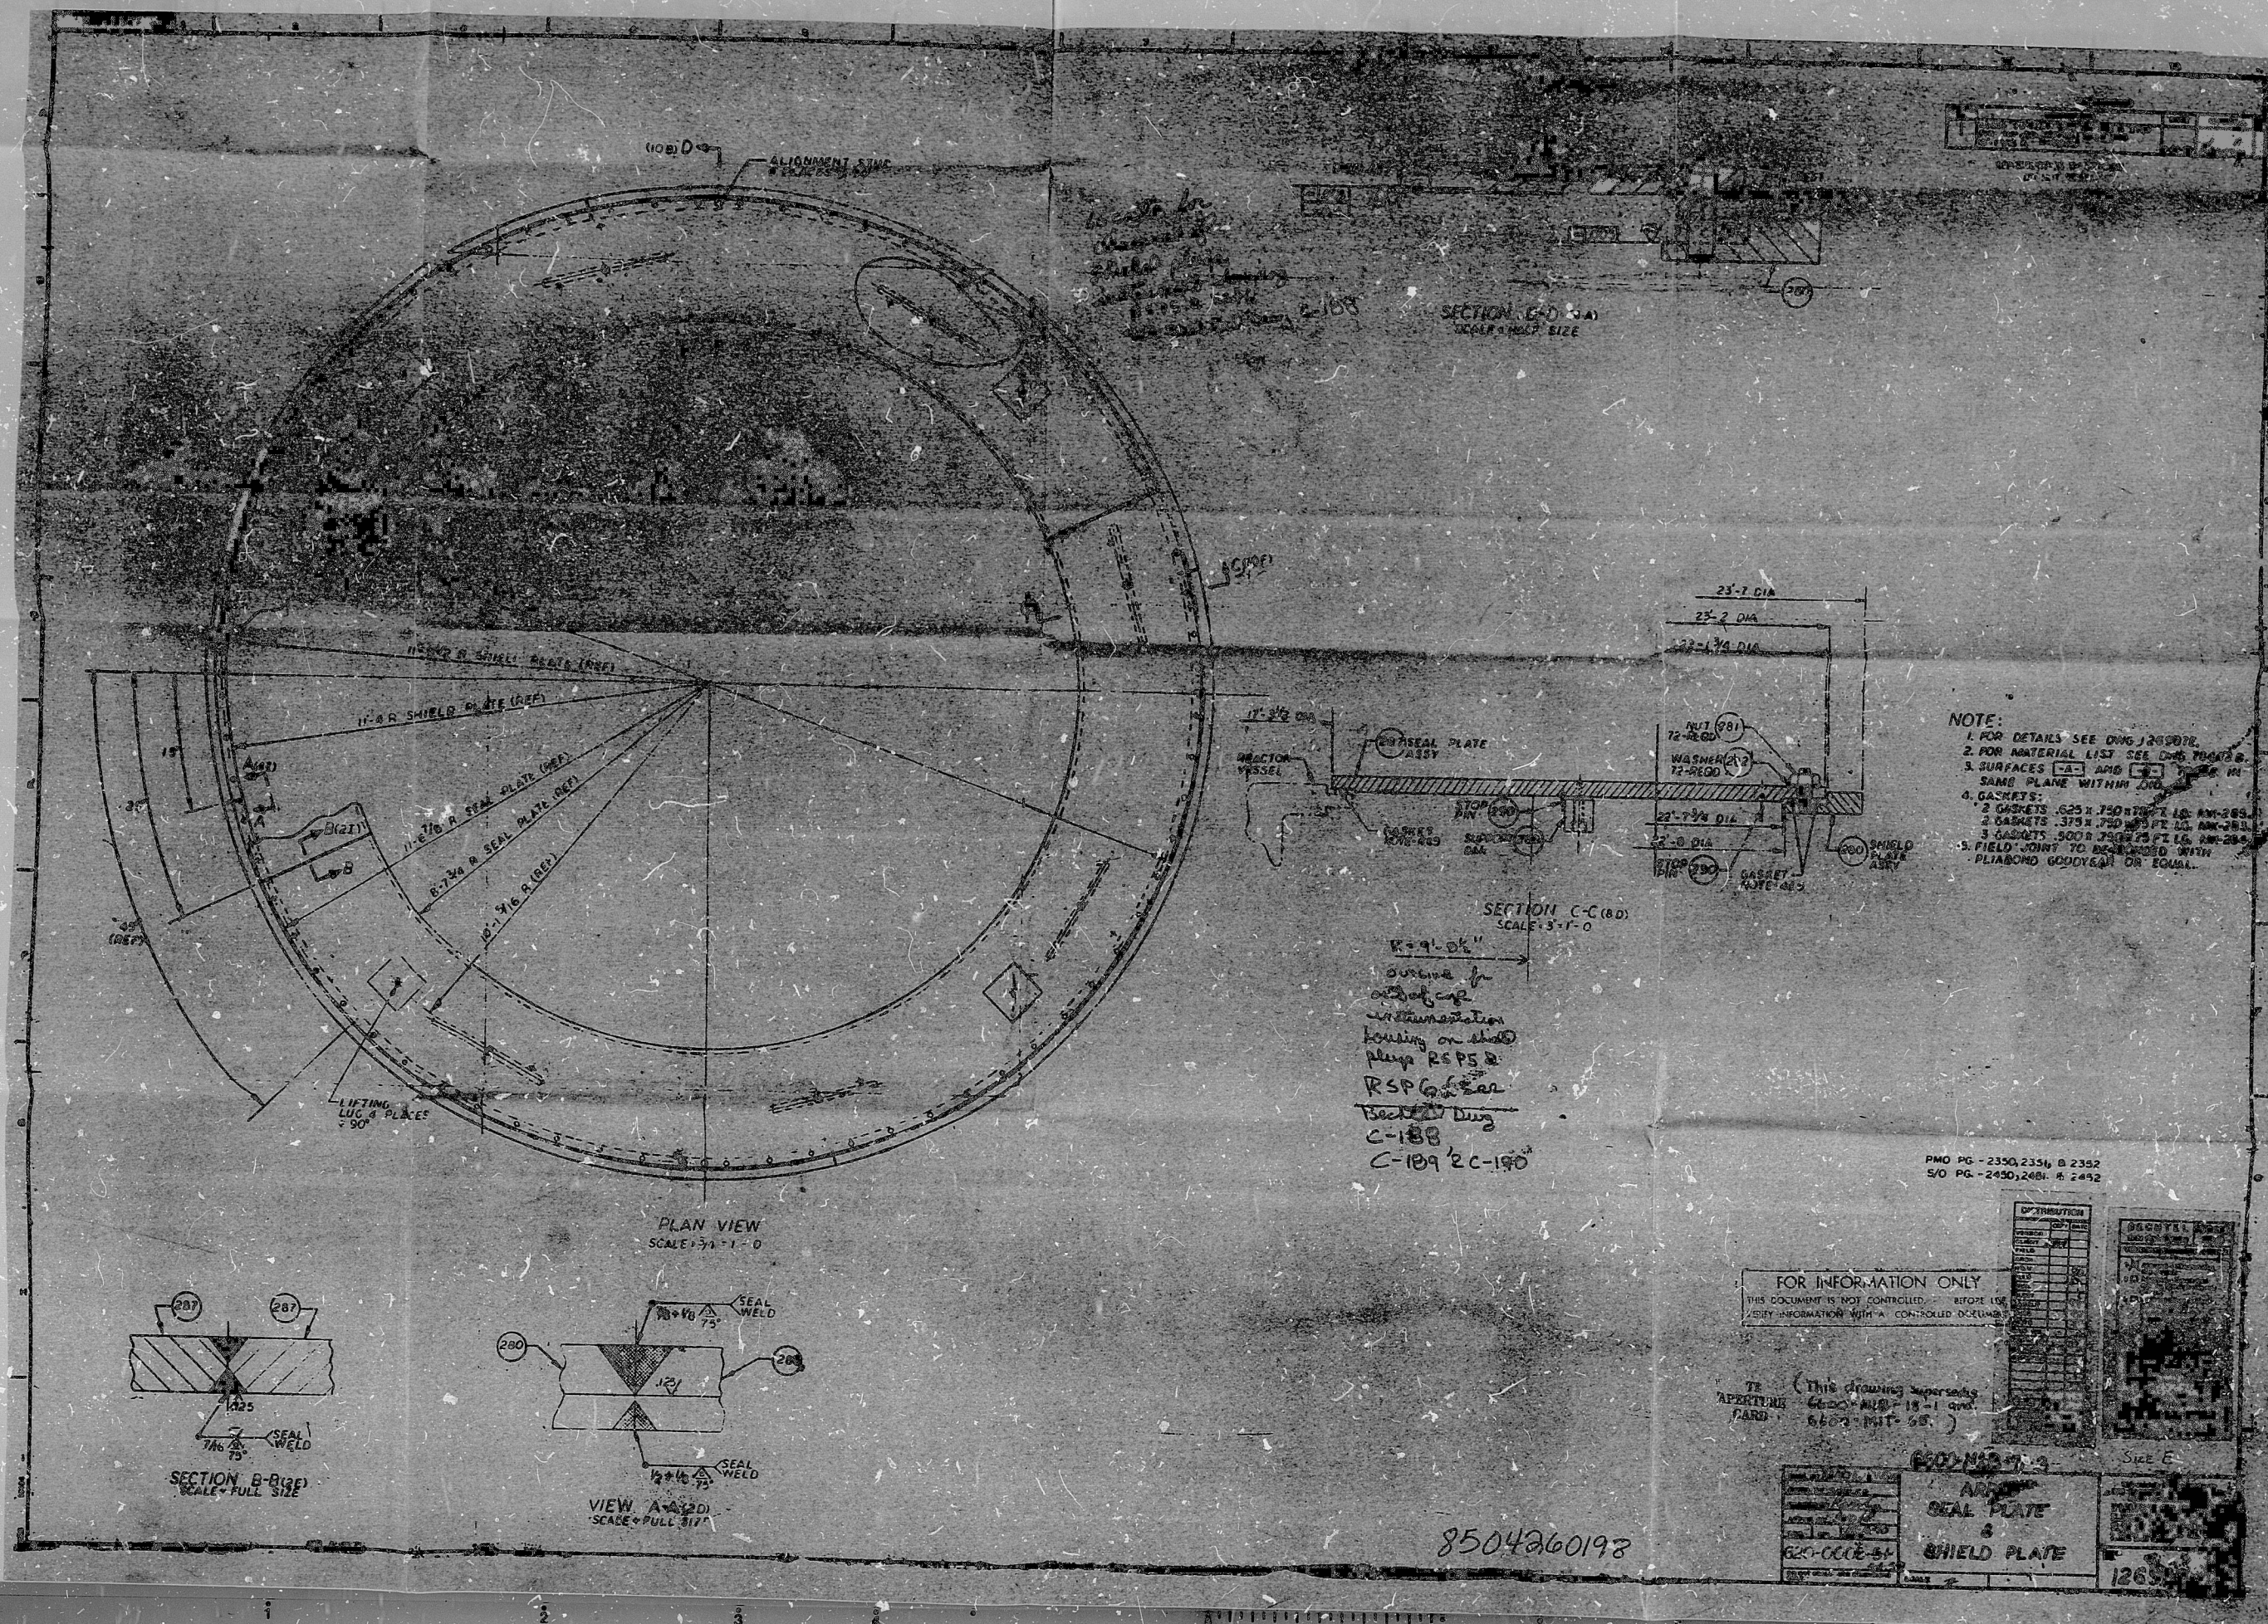

PDR RIDS

8504260198

