


(0) 952-1



RIDS

205130404

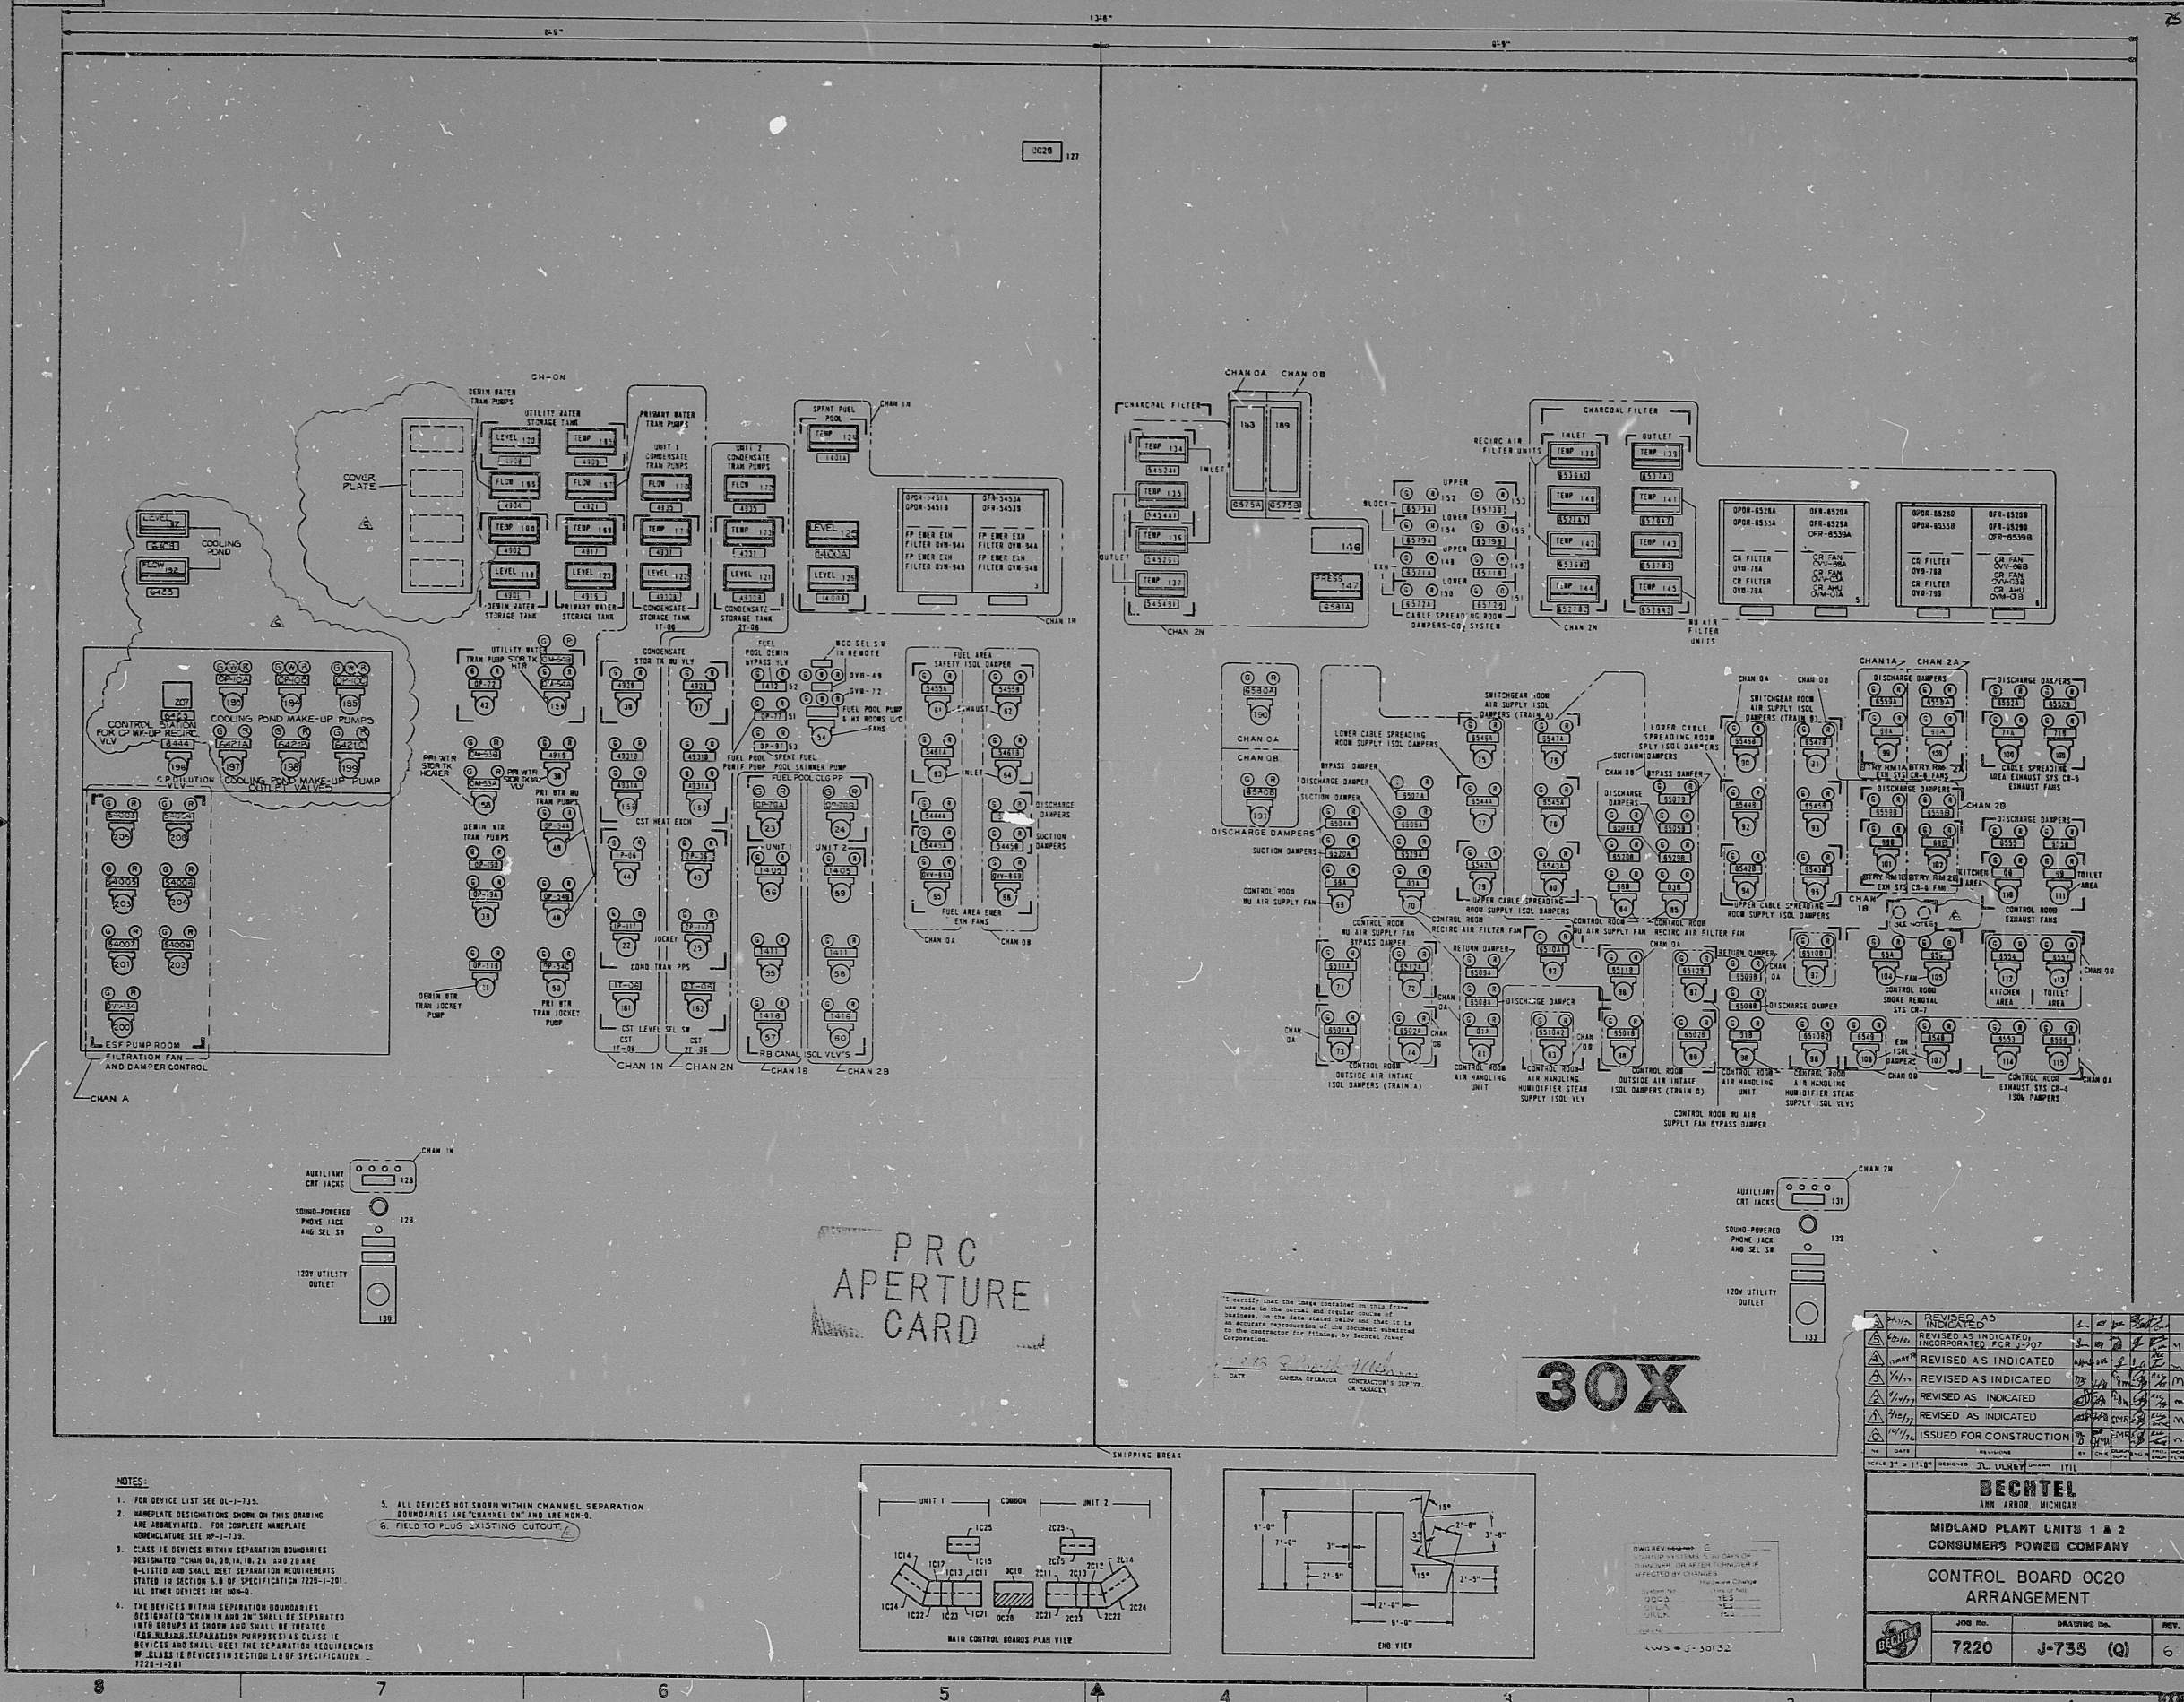