


This drawing and the design it covers are the property of BECHTEL. They are hereby loaned and on the borrower's express agreement that they will not be reproduced, copied, loaned, exhibited, or used except in the limited way and extent permitted by the written consent given by the lender to the borrower.

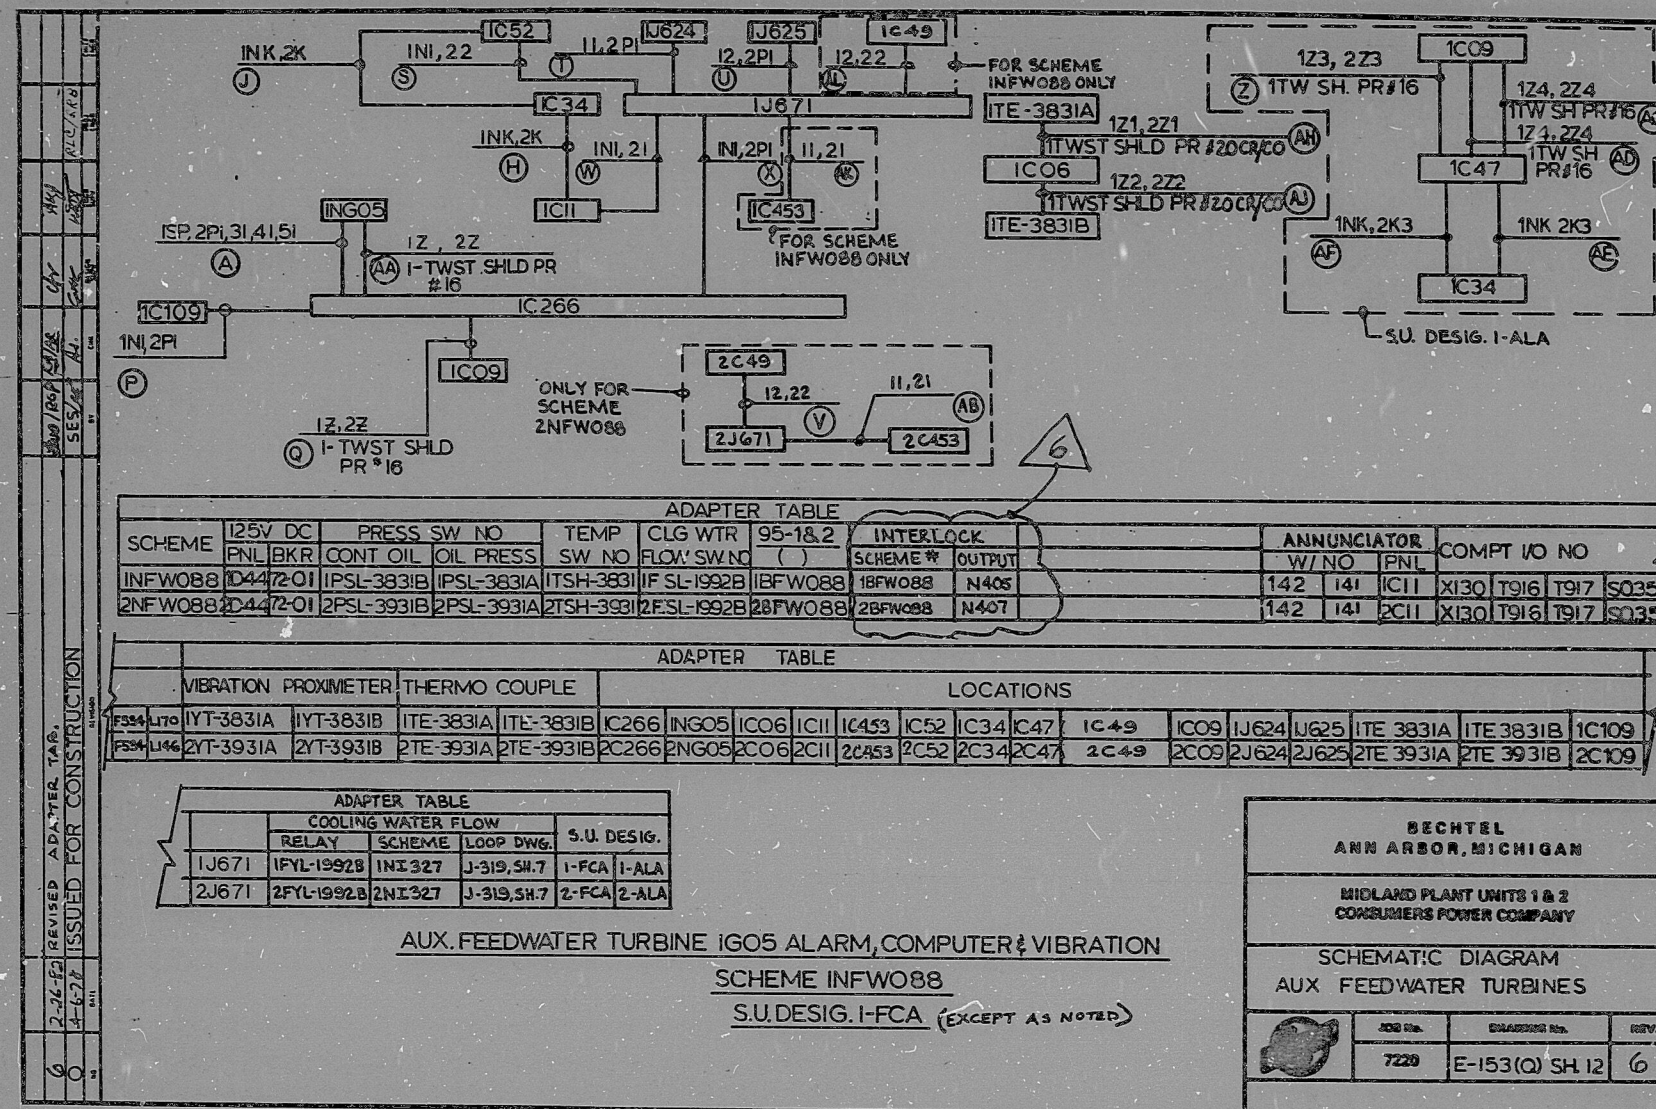

CERTIFICATE OF MICROFILMING

I Certify that the image contained on this frame was made on the normal and regular course of business, in the date stated below and that it is an accurate reproduction of the document submitted to the contractor for filming, by Bechtel Power Corporation.

3-5-77 Rex Spices Sue Brockman
Date Camera Operator Contractor's Sign

PRC
APERTURE
CARD

RIDS

805130479

