


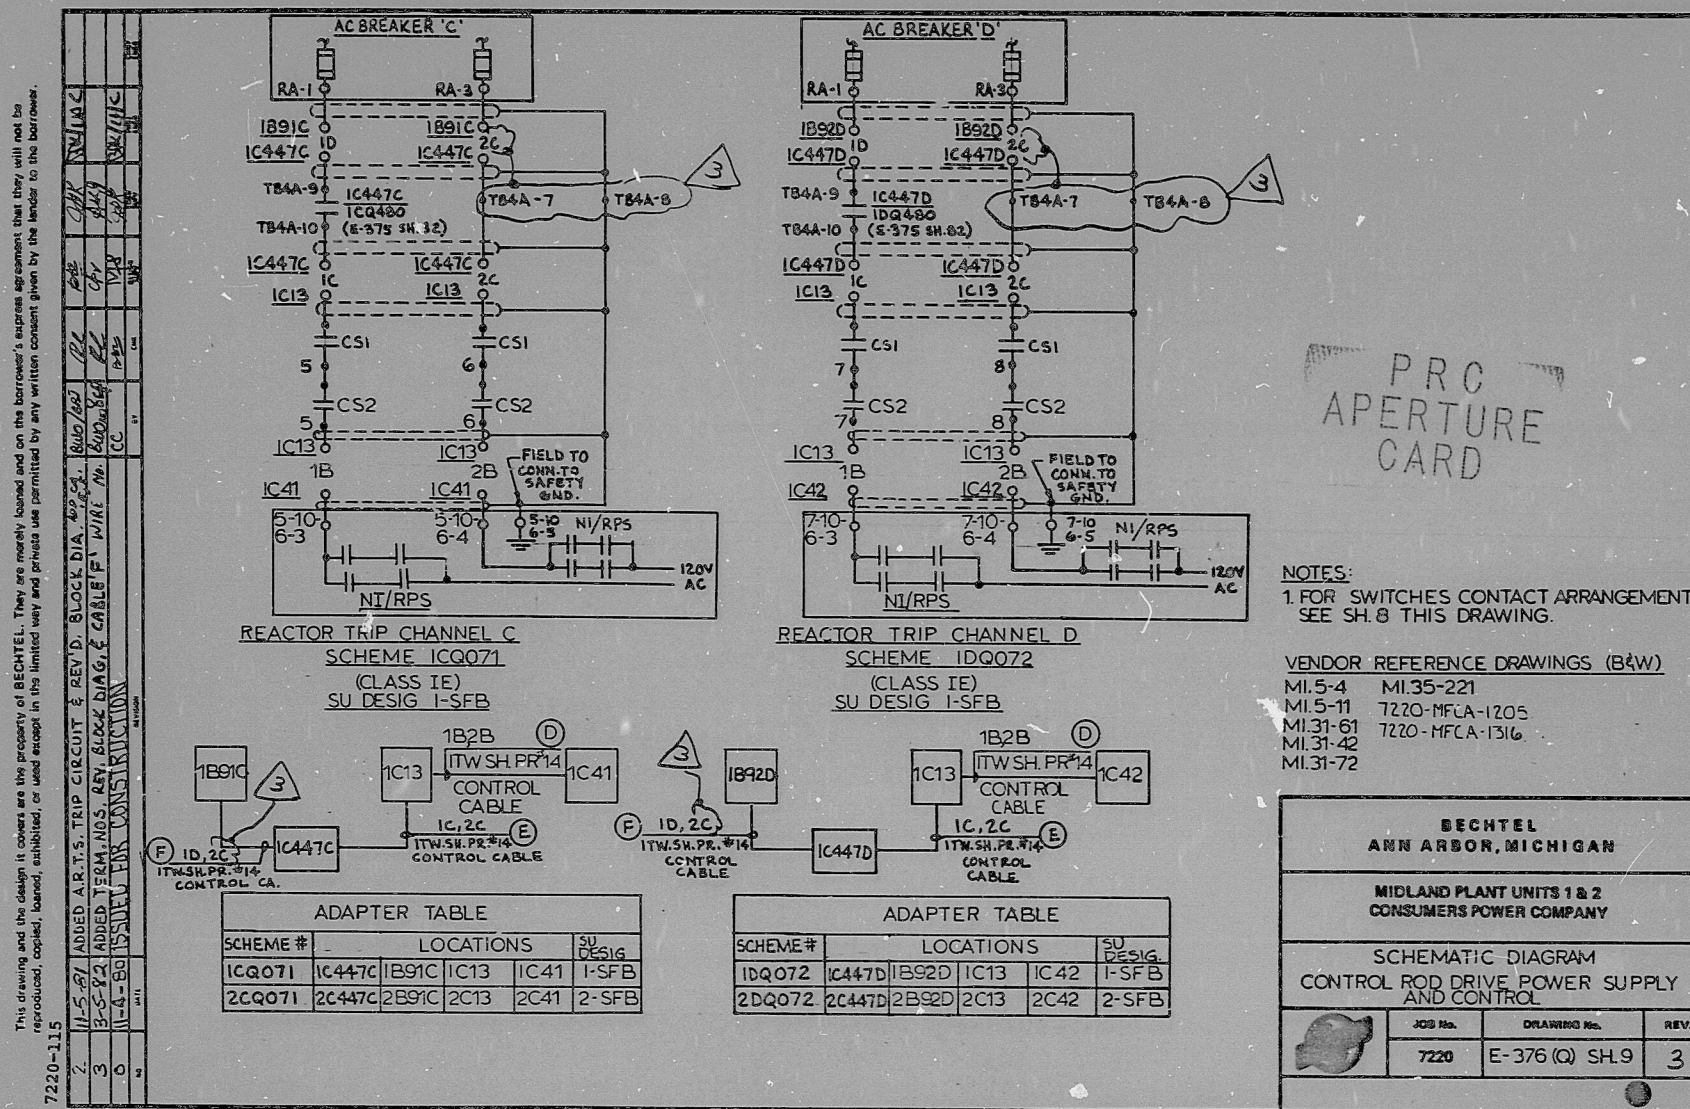

RIDS

8205170915

