


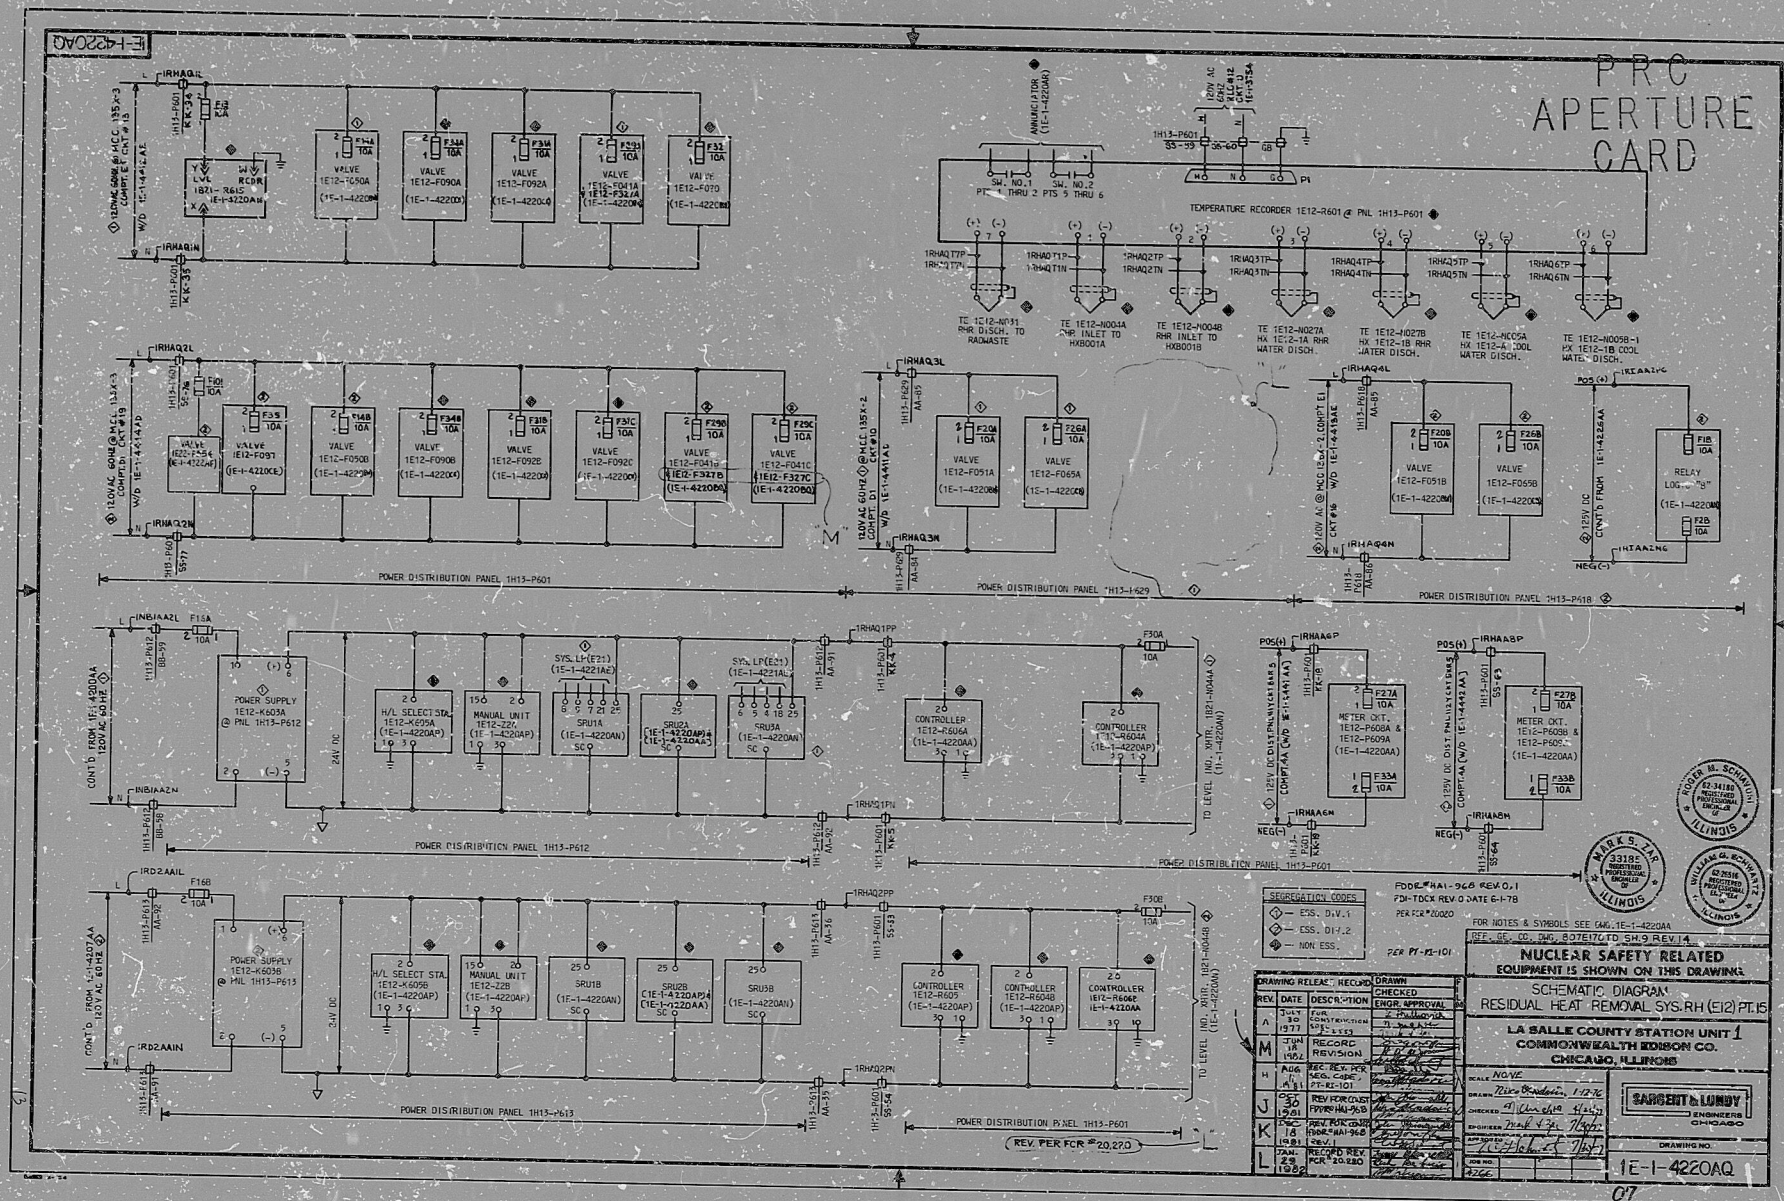

RIDS

8308250488

