



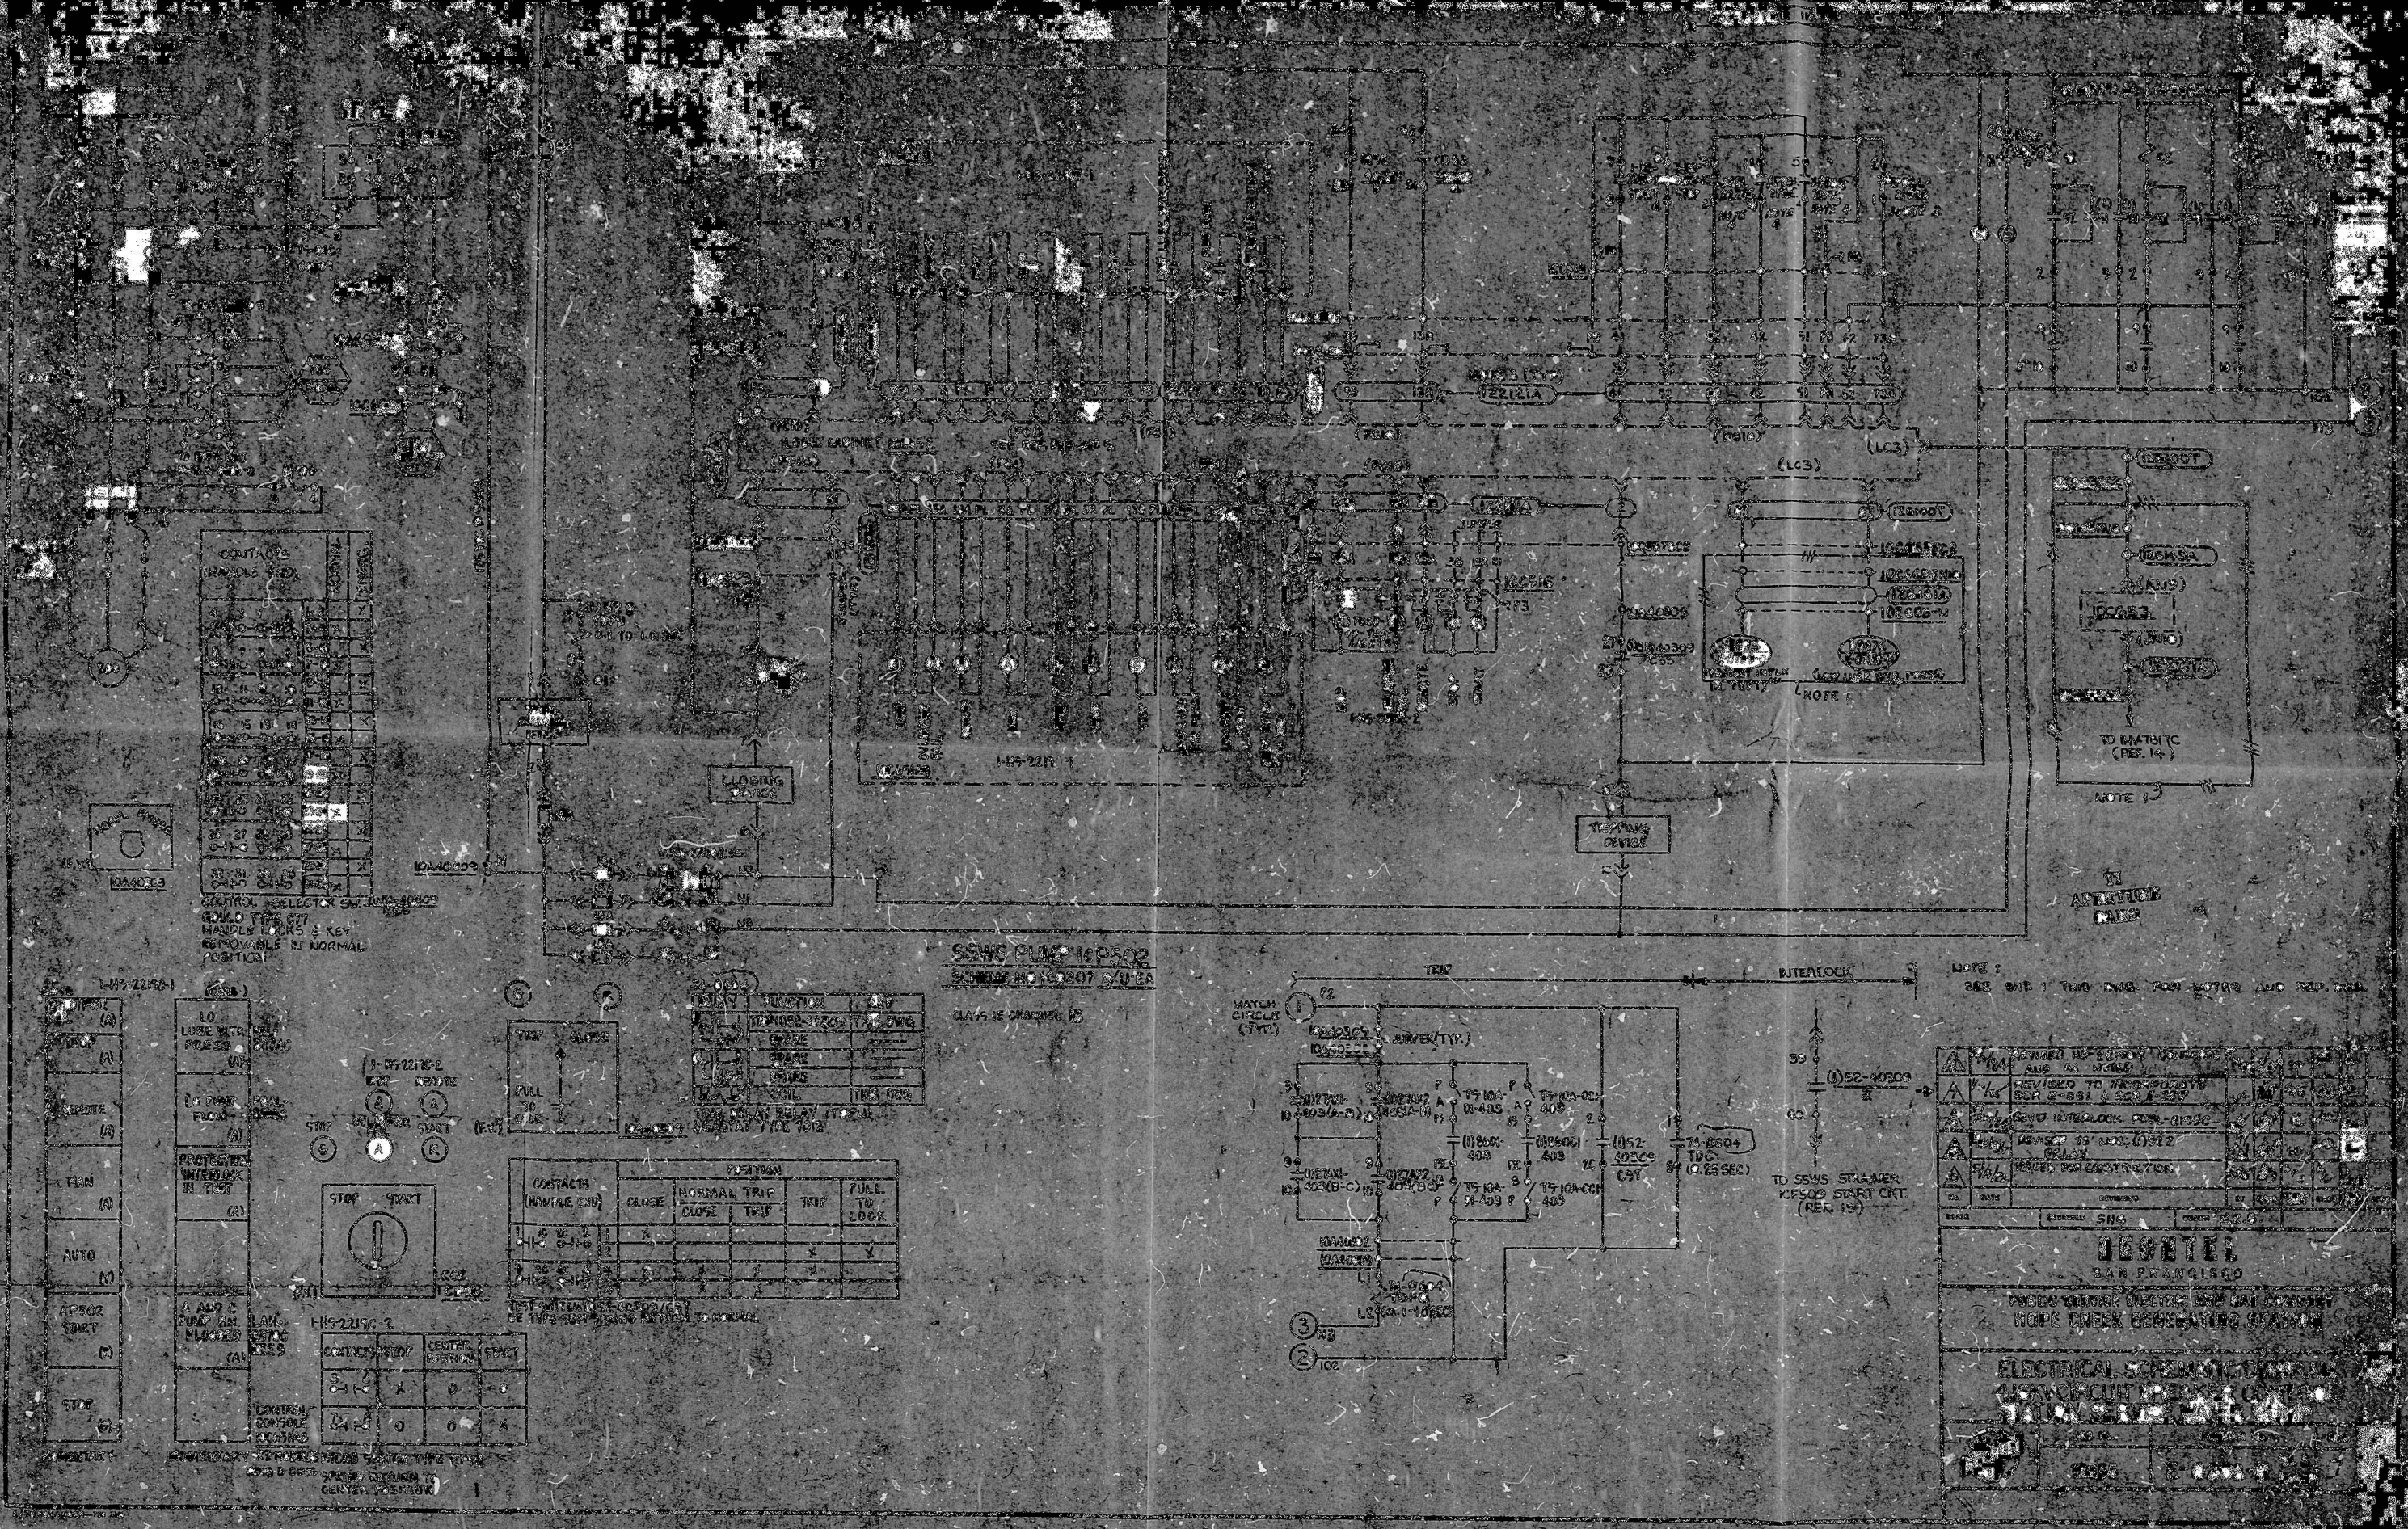



CONTACTS

CONTACT	NO.	TYPE	POSITION
1	10	NO	1

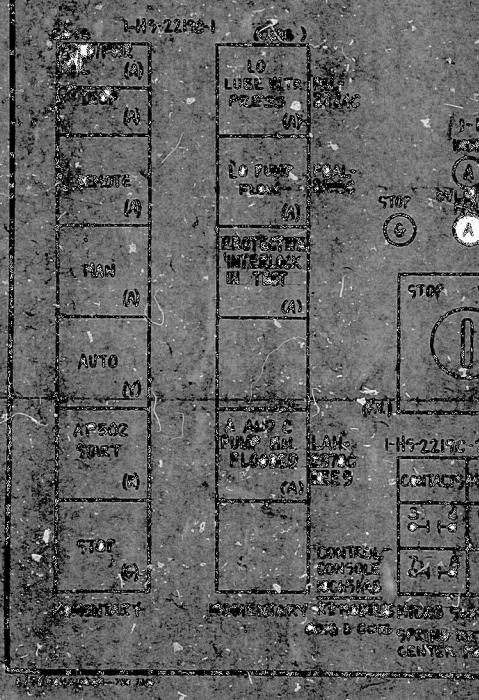



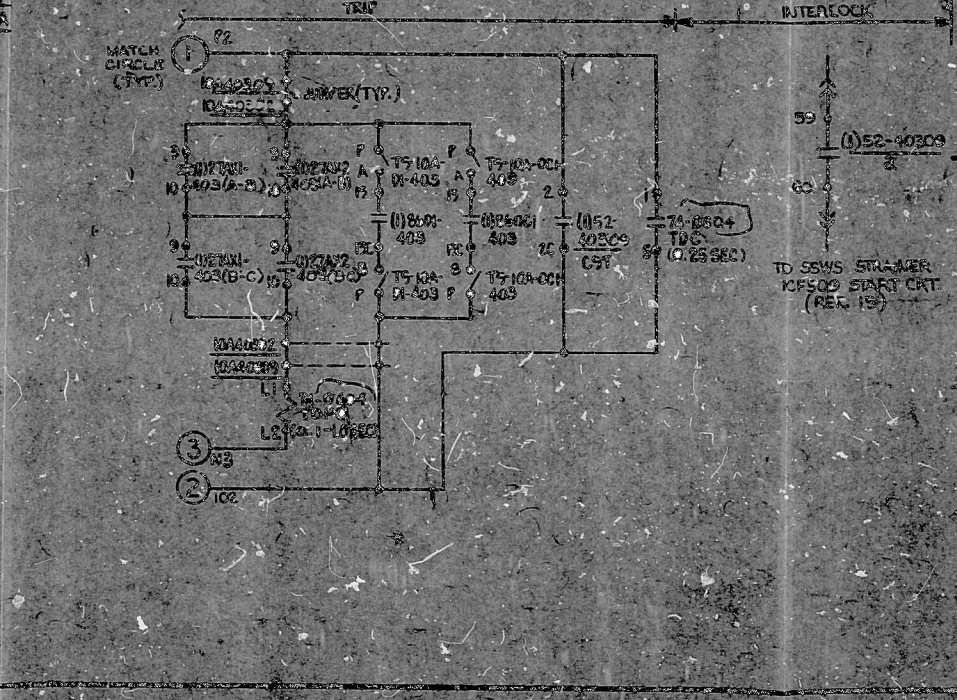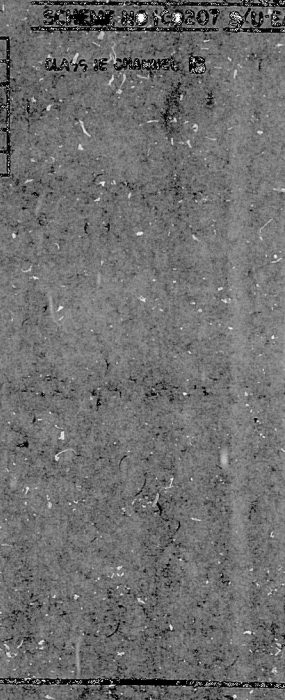

NOTE 2

ALL ONE OF THE TWO FOR NOTES AND REV. ONE

1	1/4	REVISION 1	10-2215-1	10-2215-1	10-2215-
---	-----	------------	-----------	-----------	----------

PDR RIDs

8503090043

