

34"

22"

17"

11"

8.5"

11"

17"

22"

34"

34"

22"

17"

11"


8.5"

11"

17"

22"

34"

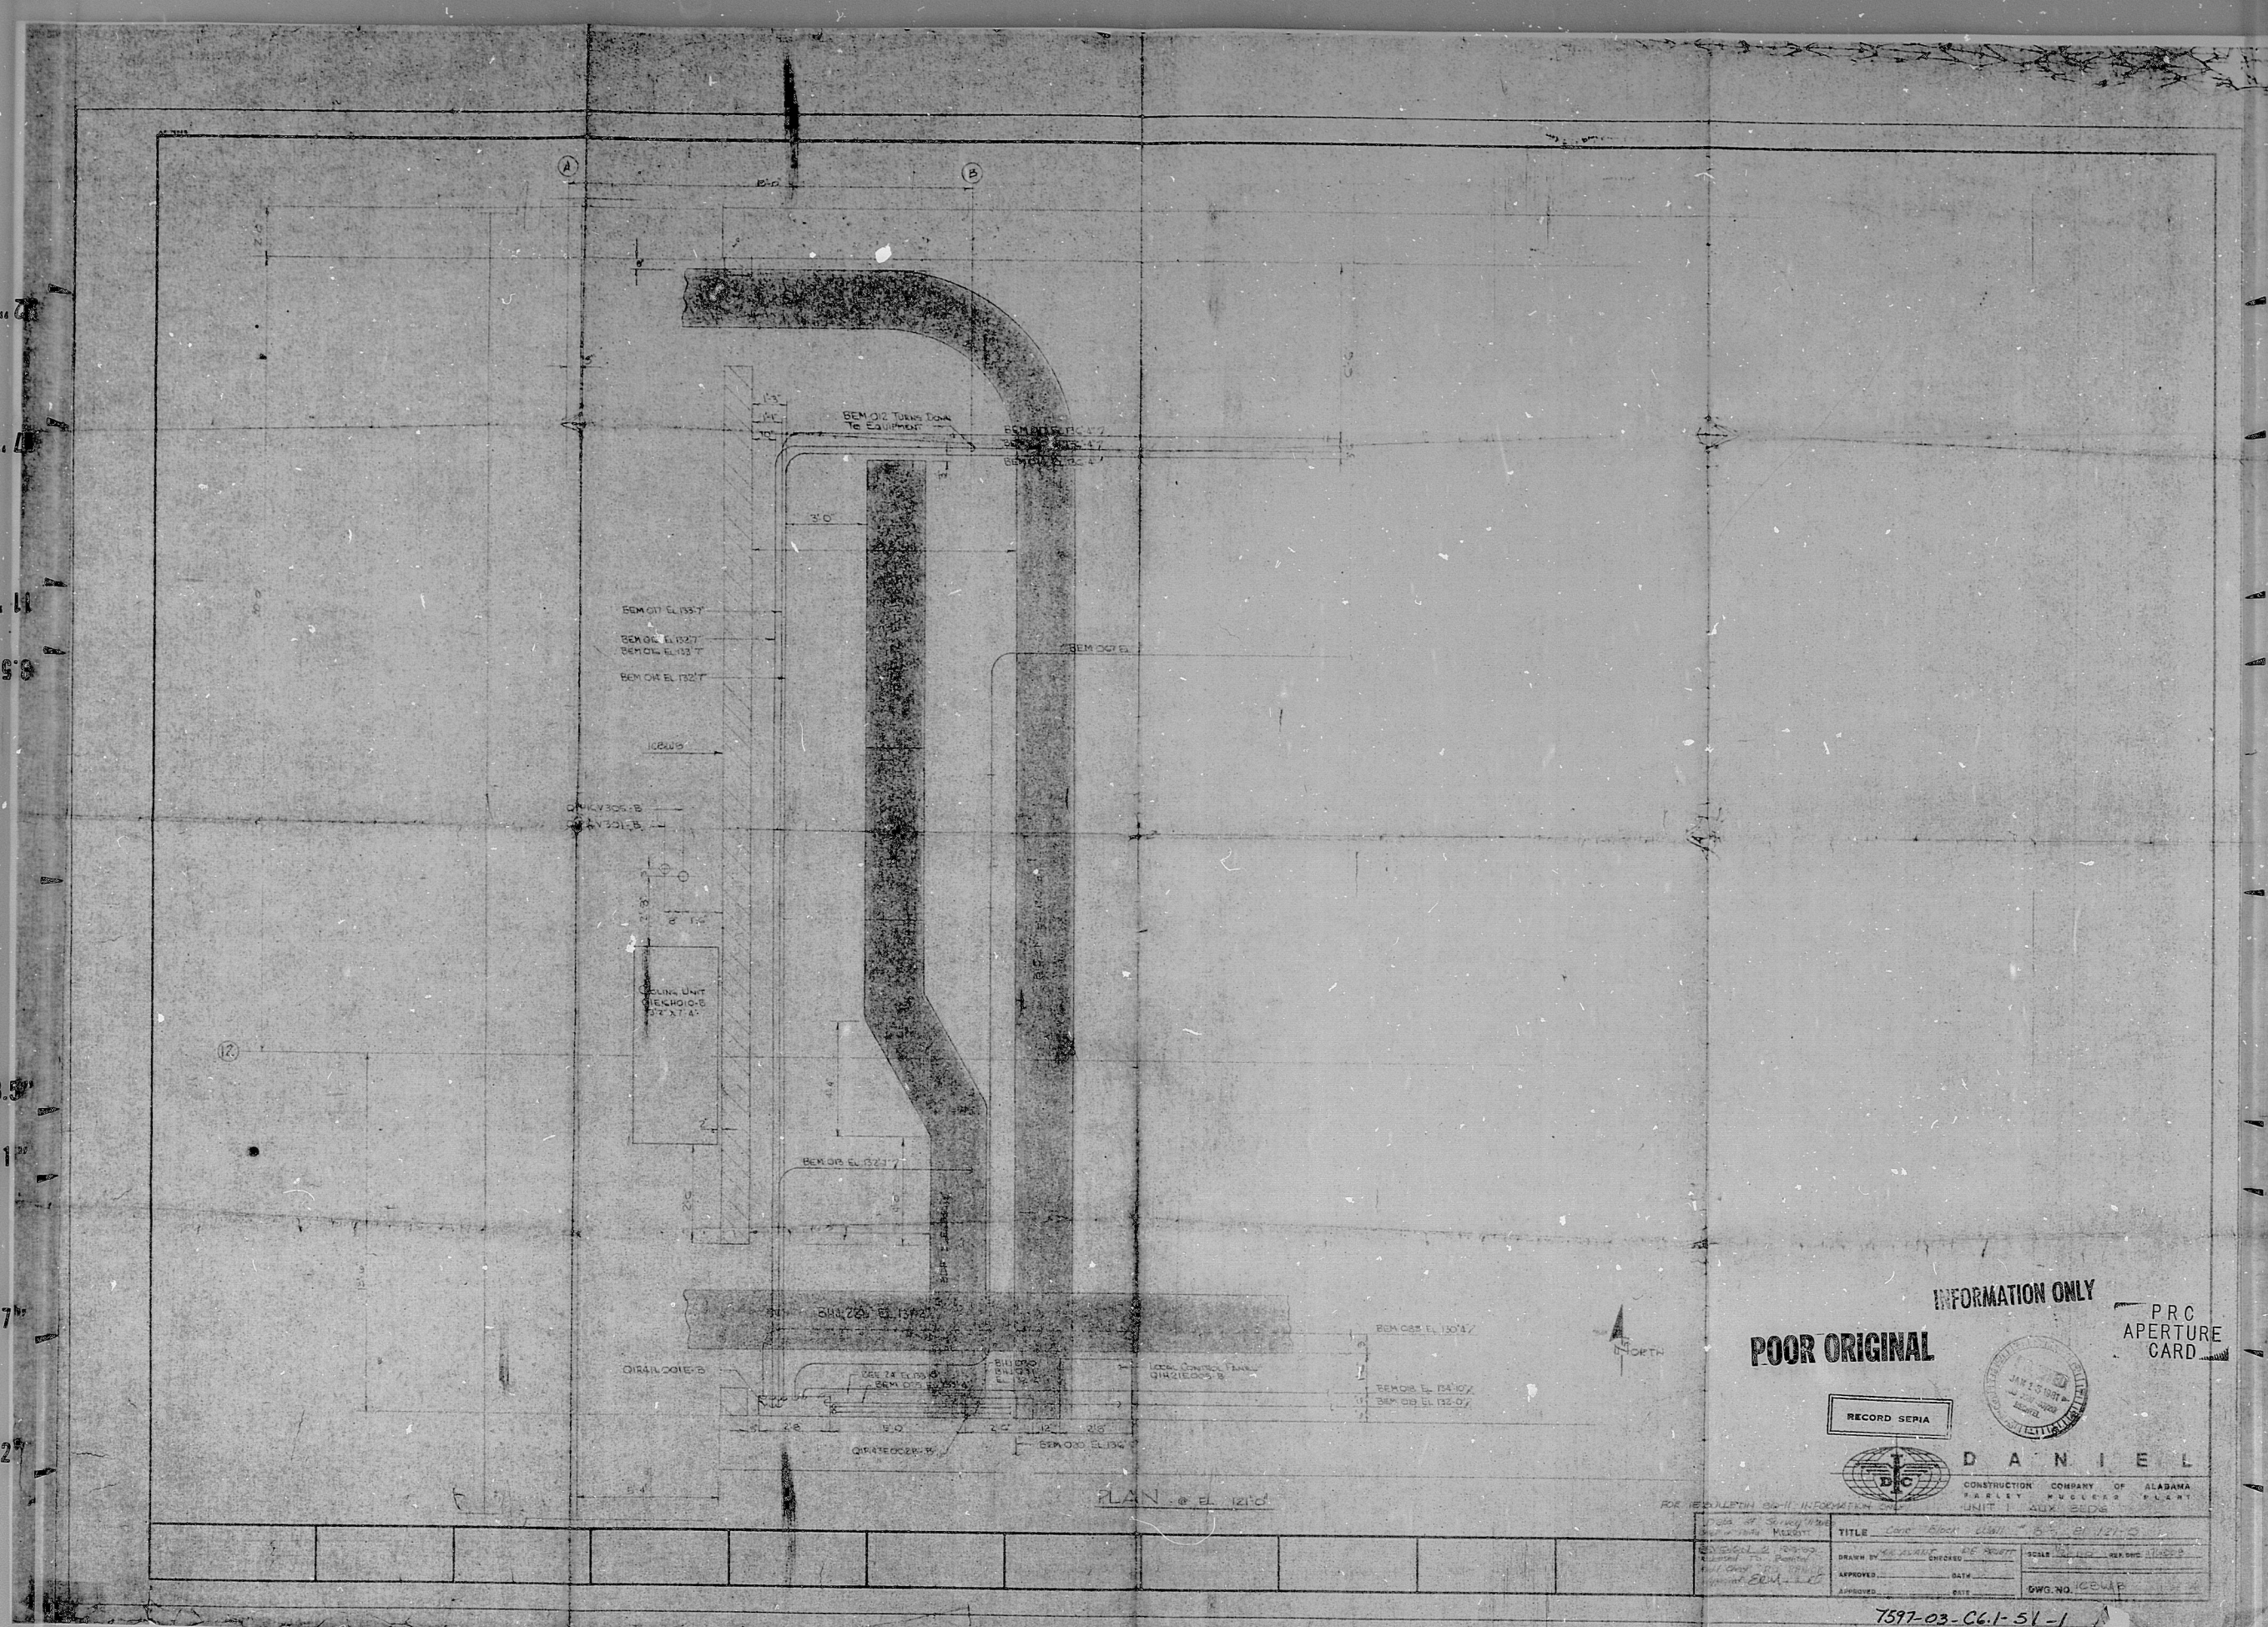

INFORMATION ONLY

POOR ORIGINAL

RECORD SERIAL

DANIEL

CONSTRUCTION COMPANY OF ALABAMA

UNIT 1 - AUX. BLDG.

FOR REVISION ONLY INFORMATION




SCALE: 1/4" = 1'-0"


7517-03-C6.1-51-1



RIDS

8205180087

