


34"



34"

34"

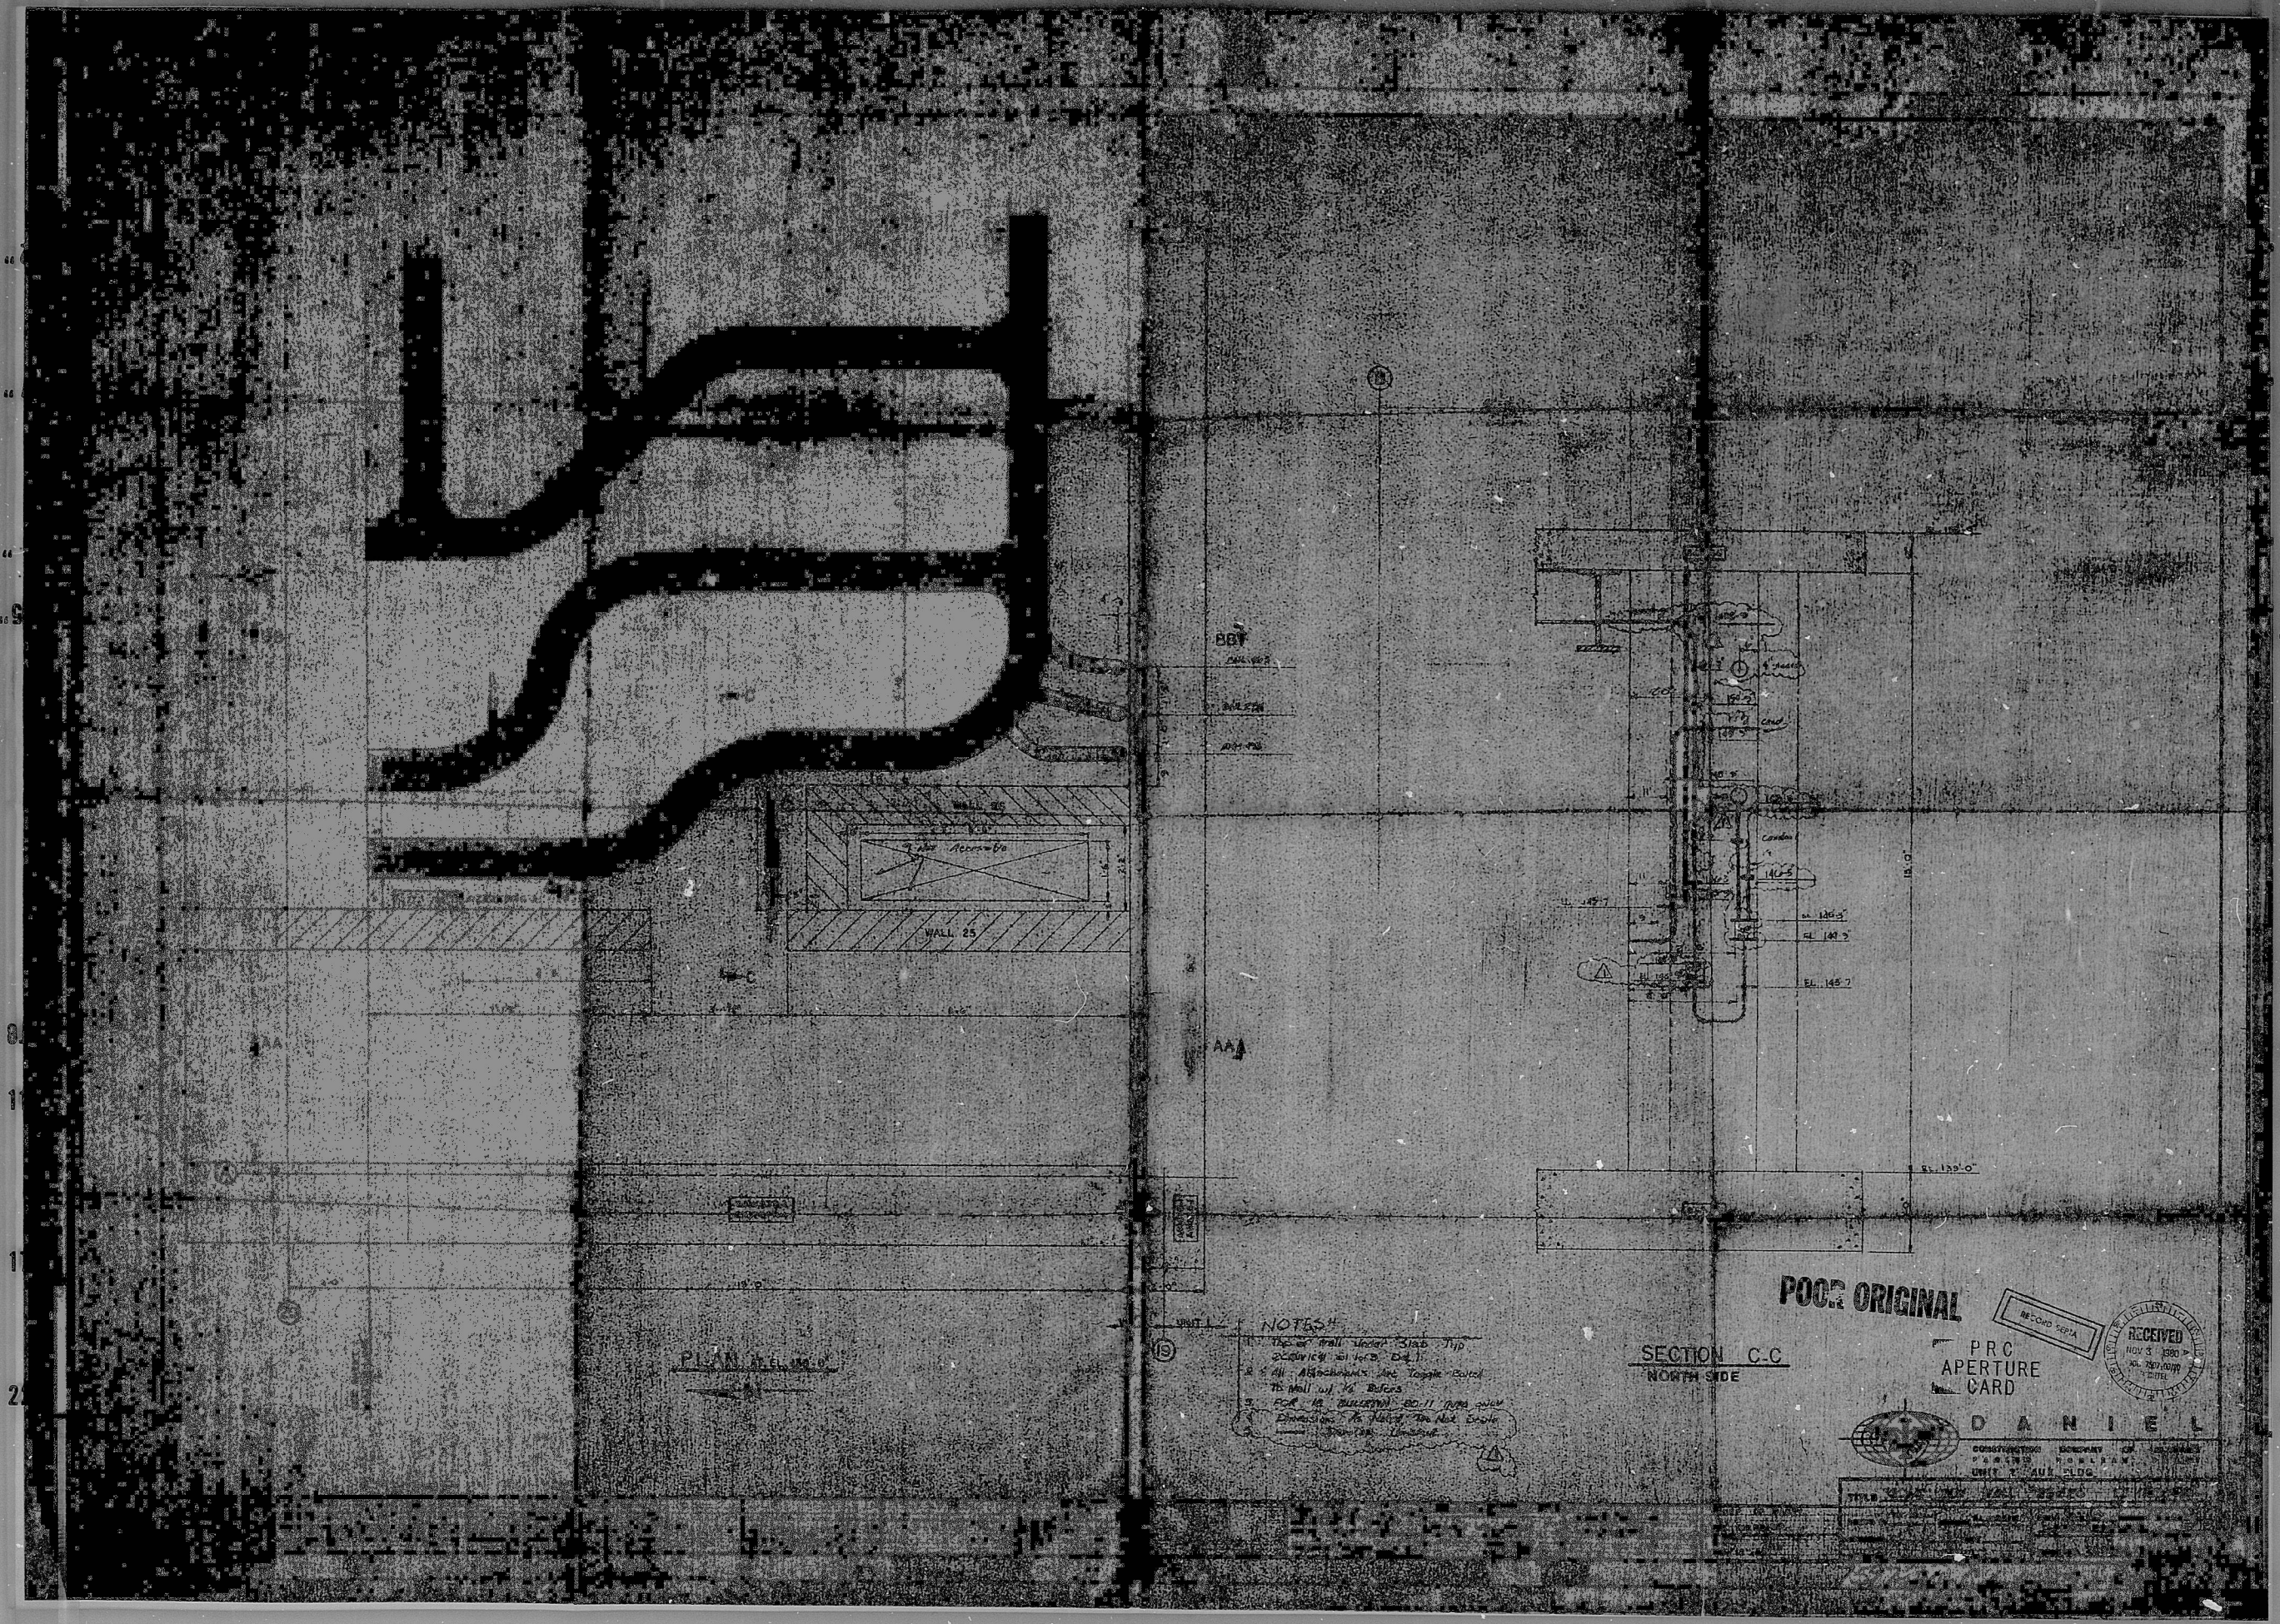

RIDS

805180165

