


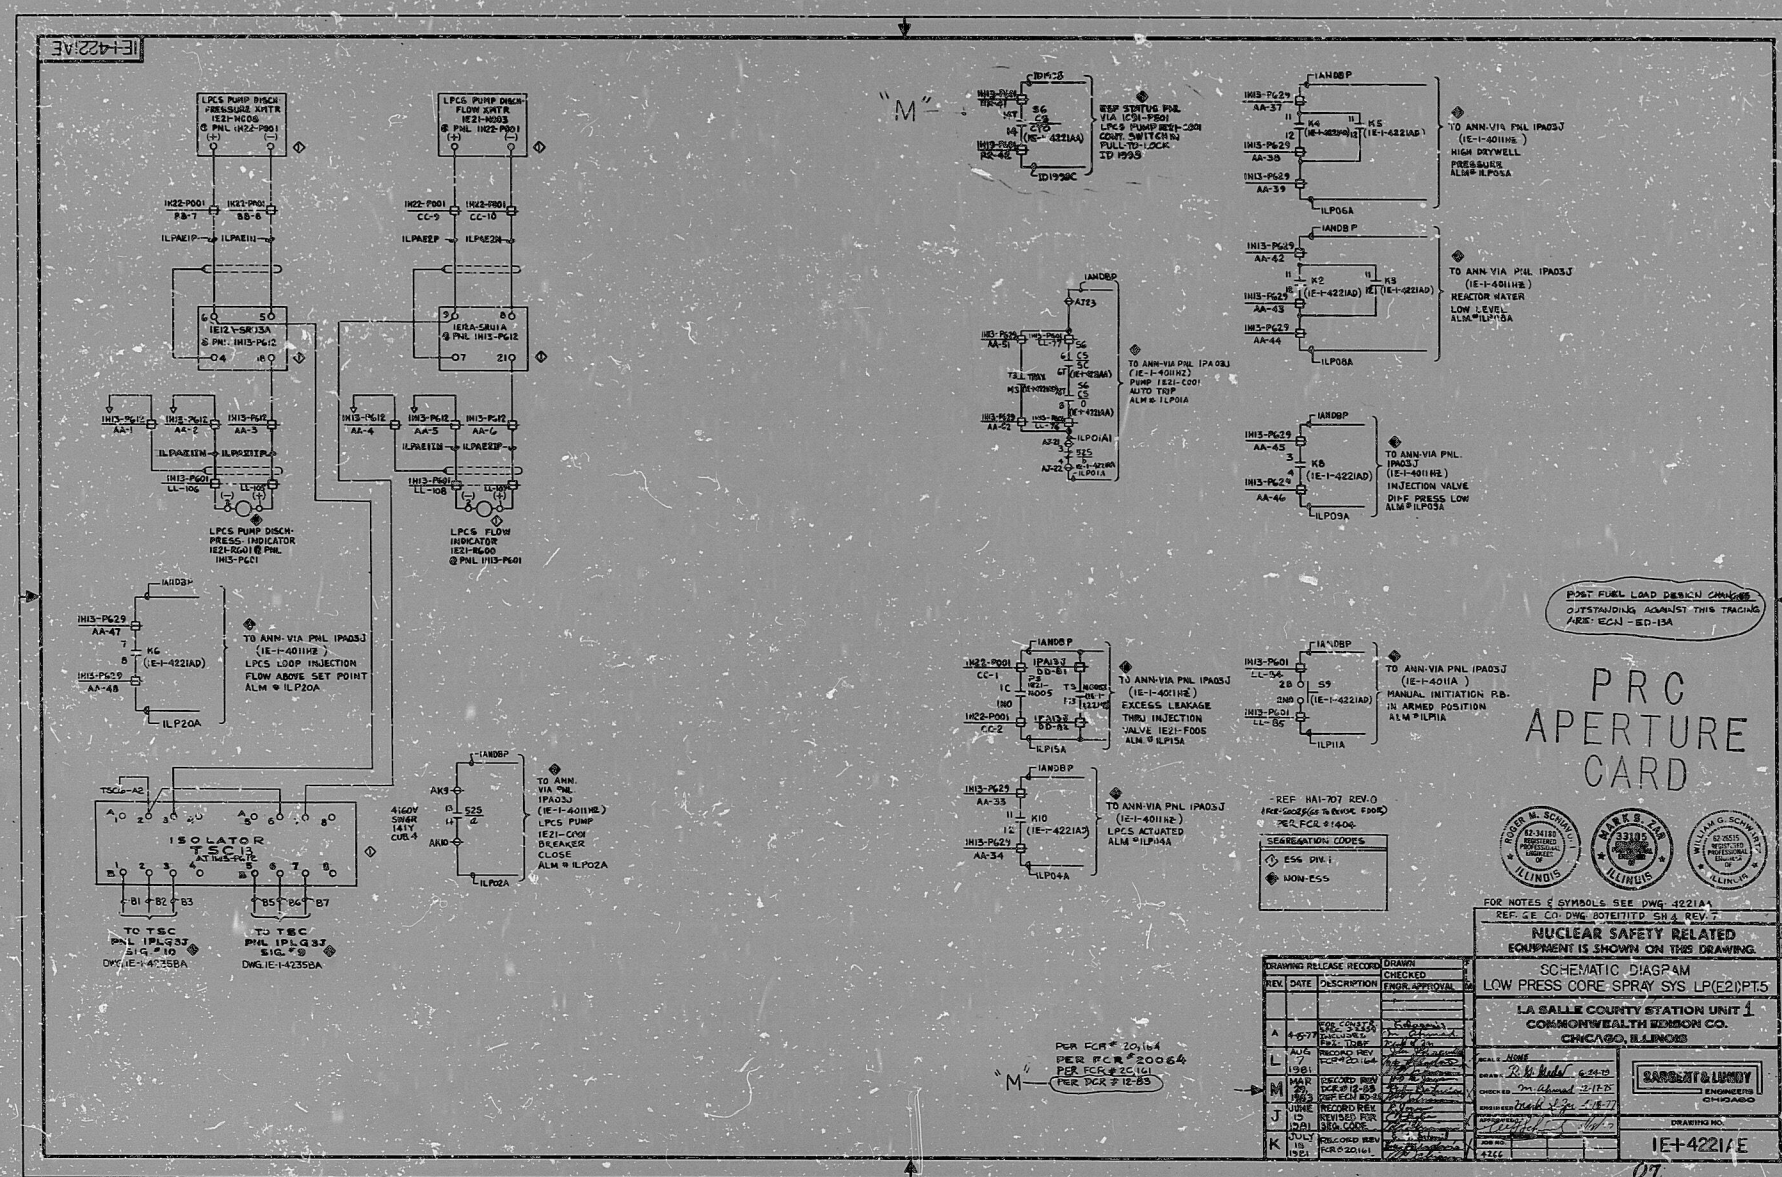

RIDS

8308250686

