


8-53

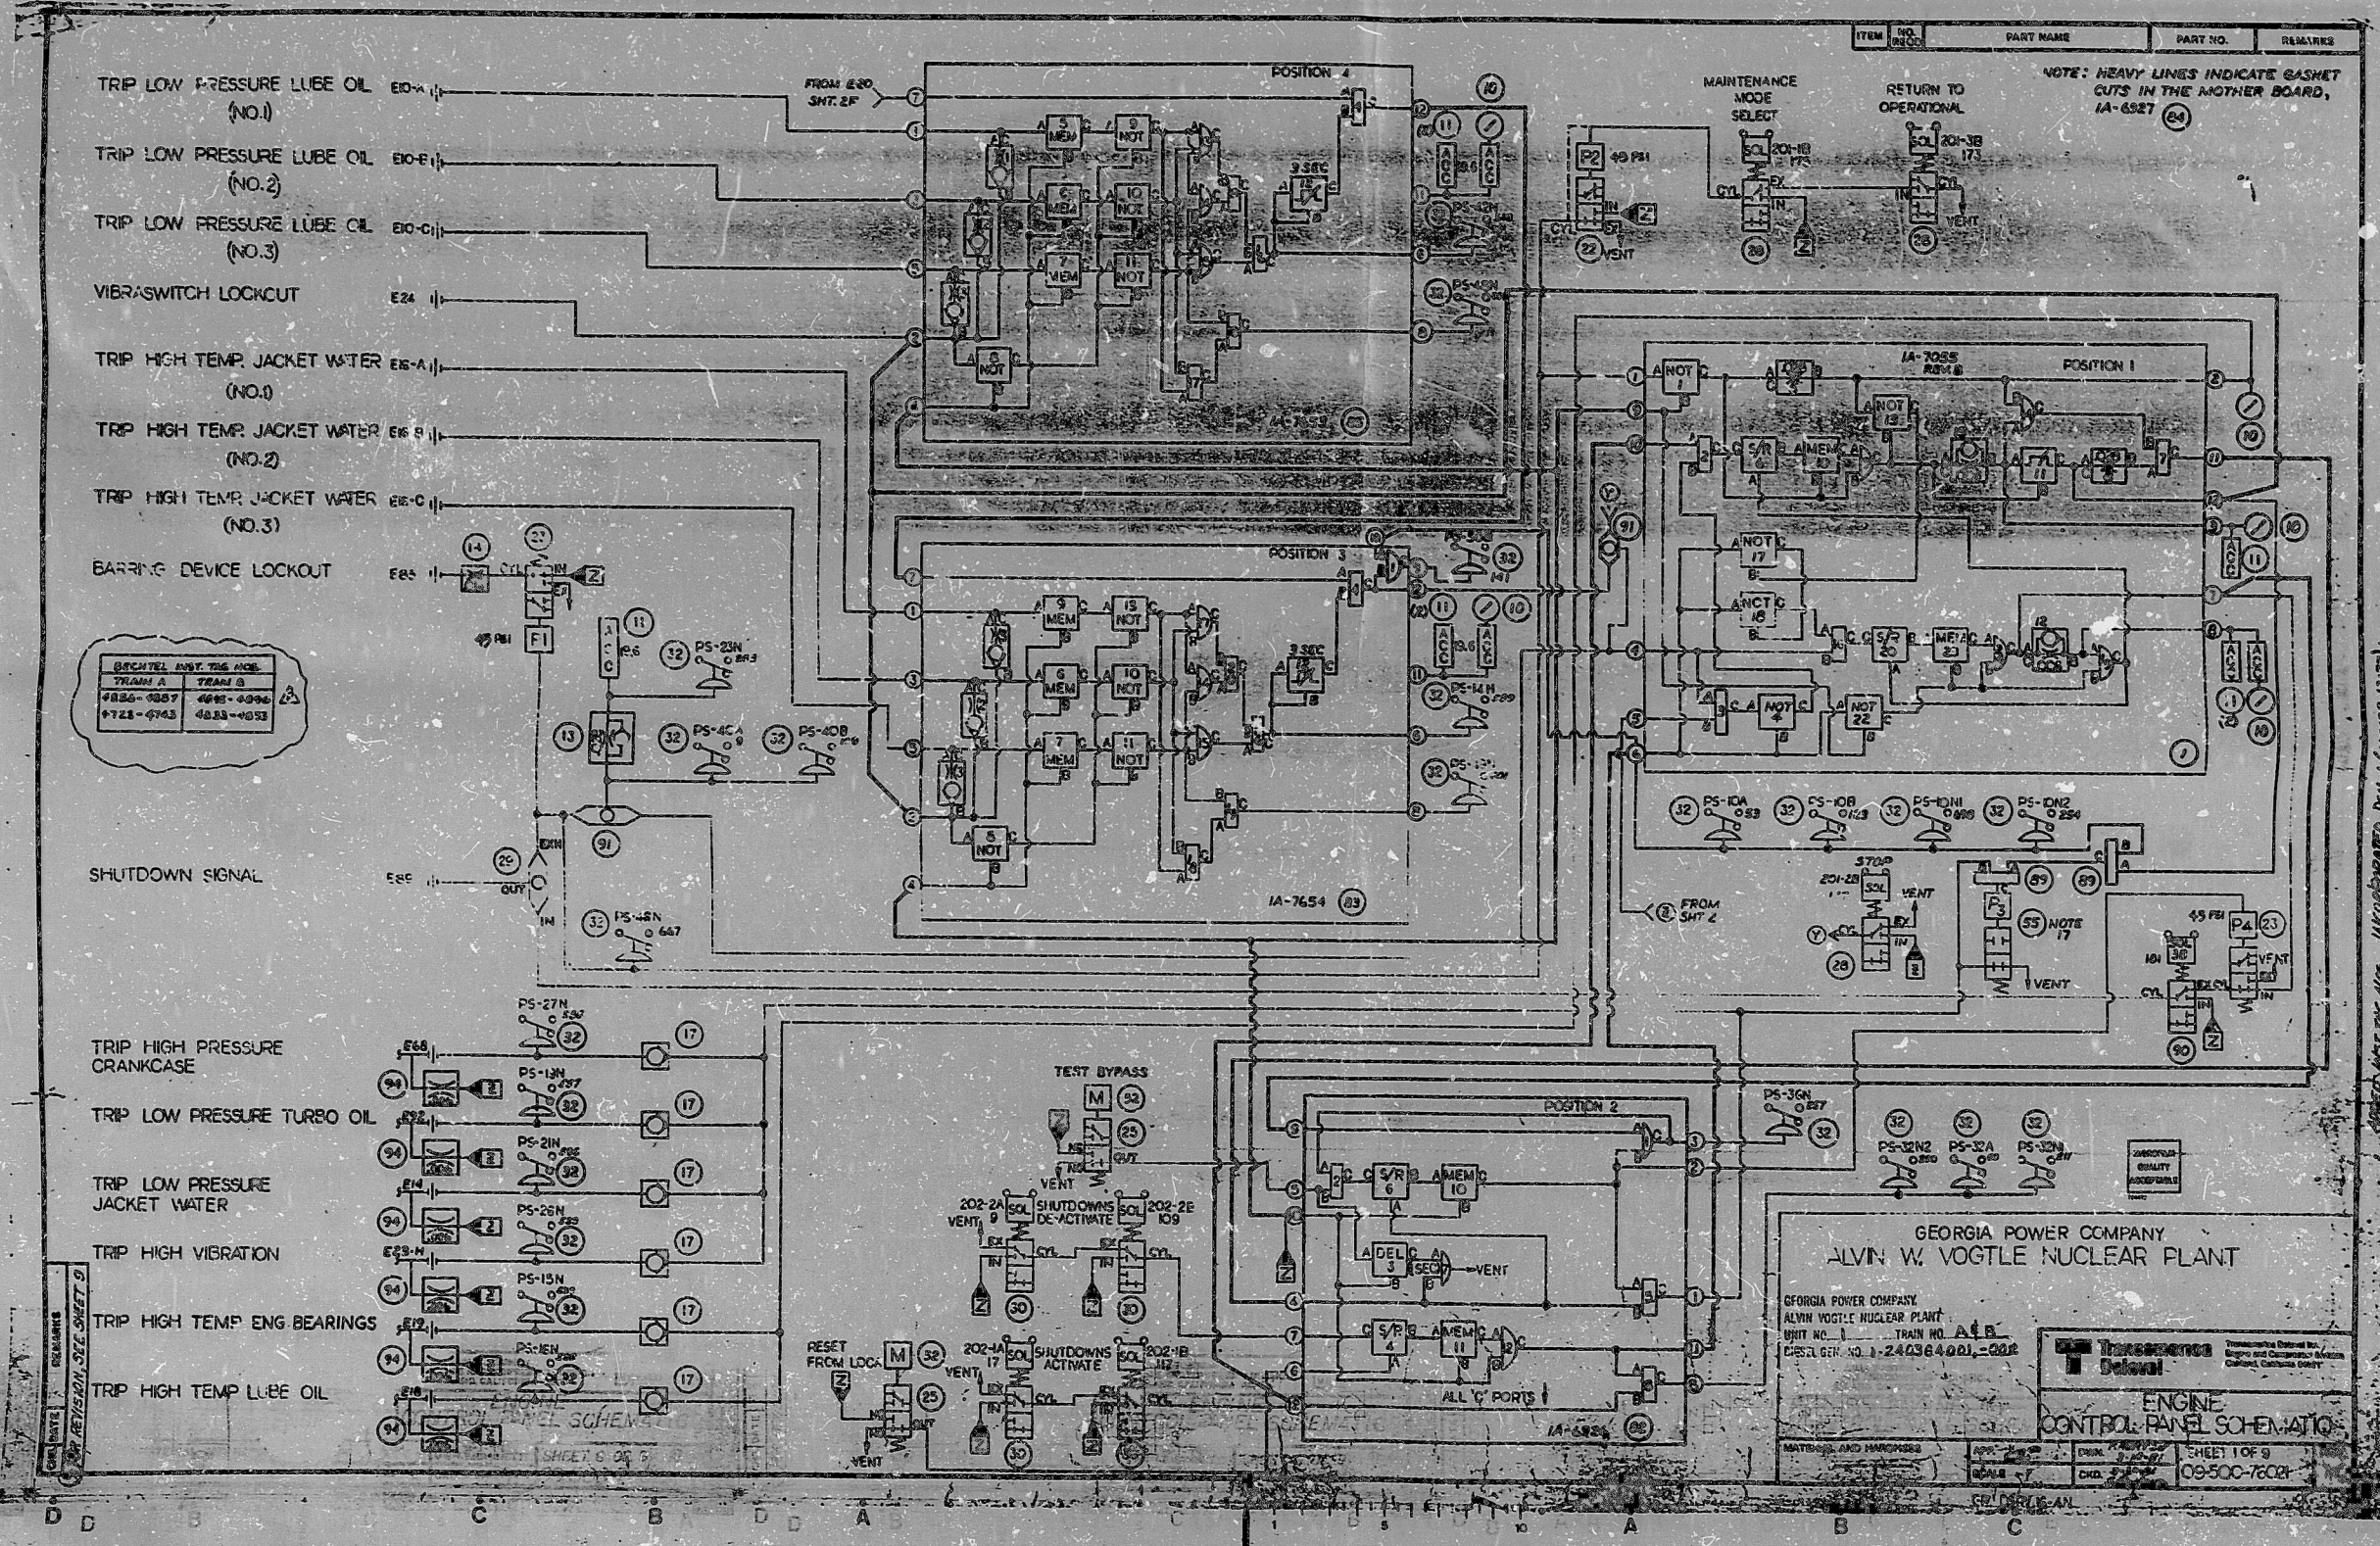



SI 2  
APERTURE  
CARD

9202200310

PDR

9202200310

