N-NORMAL ILLUMINANCE
NE-NORMAL EMERGENCY ILLUMINANCE
B-BATTERY EMERGENCY UNIT (8HRS)

NOTES

1. MOUNTING HEIGHT OF LIGHTING FIXTURES TO BE 8'-0 IN AREAS WITH FALSE CEILING AND 12'-0 IN ALL OTHER AREAS UNLESS OTHERWISE NOTED.
2. ALL SWITCHES DESIGNATED AS 4 WAY SWITCHES SHALL BE BIM*MIS-5940, 3 WAY SWITCHES BIM*MIS-5940 AND 2 WAY SWITCHES BIM*MIS-5940.
3. ALL RECEPTACLES BIM*MIS-1368 UNLESS OTHERWISE NOTED.
4. FOR SYMBOLS, GENERAL NOTES AND MOUNTING DETAILS SEE DWG'S 2998-G-397.
5. FOR REFERENCE DWGS SEE DWG'S 2998-G-397 SH 1.
6. FOR CONDUIT AND WIRING SEE DWGS FSG 2998-E-012 SH 1 & 2 FSG 2998-E-013 SH 1.

PLAN EL 19.50

DETAIL A (1:8)

DETAIL B @ EL 31'5 (1:8)
MOUNT FIXTURES 8'-0 ABOVE PLATE

POOR ORIGINAL

PRC APERTURE CARD

THIS DOCUMENT IS THE PROPERTY OF EBASCO SERVICES INCORPORATED. ITS USE IS EXPRESSLY RESTRICTED BY THE TERMS OF THE CONTRACT, DATED AS OF SEP 1, 1972 BETWEEN EBASCO SERVICES INCORPORATED AND FLORIDA POWER & LIGHT COMPANY.

NO.	DATE	REVISION	BY	CHK.	APPROVED
3	10-1-73	GENERAL REVISION-NOT CIRCLED FOR CLARITY	LRJ	RP	VC
2	9-1-72	REVISED TB-TO AGREE WITH CA CIRCS FROM COL RAM-RAA TO ZRAE-ZRAN (H-8) FIX. LOCATION (F-6,H-6), ADDED ROOM L-8 NOTE PNL NO (F-8, F12, TYPE U-1).	LRJ	RP	VC
1	6-1-72	REVISED LTG TO AGREE WITH CA CIRCS FROM COL RAH-RAL TO ZRAJ-ZRAE (J-6), NOTES (H-18), CRCD CKT NOS (D-6), (K,L-12), (E,F,K,L-9, 10, E, F, K-8), LOCATION OF LIGHTS (J-18), ADDED CKT LIGHTING (H-9-8), SWITCHES (H-9), RECEPT. (D-12, E-12), CA CIRCS (C-H, E-12, F, G, E-13).	LRJ	RP	VC

FLORIDA POWER & LIGHT COMPANY
ST LUCIE PLANT
1983-000 SITE (@ EXTENSION - UNIT NO. 2

REACTOR AUXILIARY BUILDING
LIGHTING - SH. 2

EBASCO SERVICES INCORPORATED

SCALE 1/8"=1'-0" | DATE 5-17-74
DSN. E.M.P.
DWG. NO. 2998-G-391 SH 2

8205200143

RIDS

8205200142

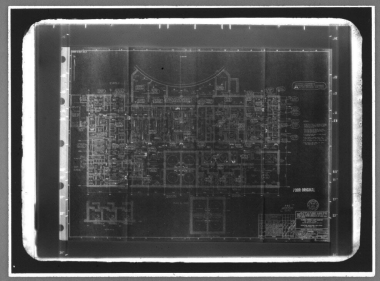

M*M 5824 — FILMSORT*, Brand Aperture & Camera Cards and DUPLICARD*, Brand Copy Cards — Product of 3M Company, St. Paul, Minn.