




RIDS

8308260318

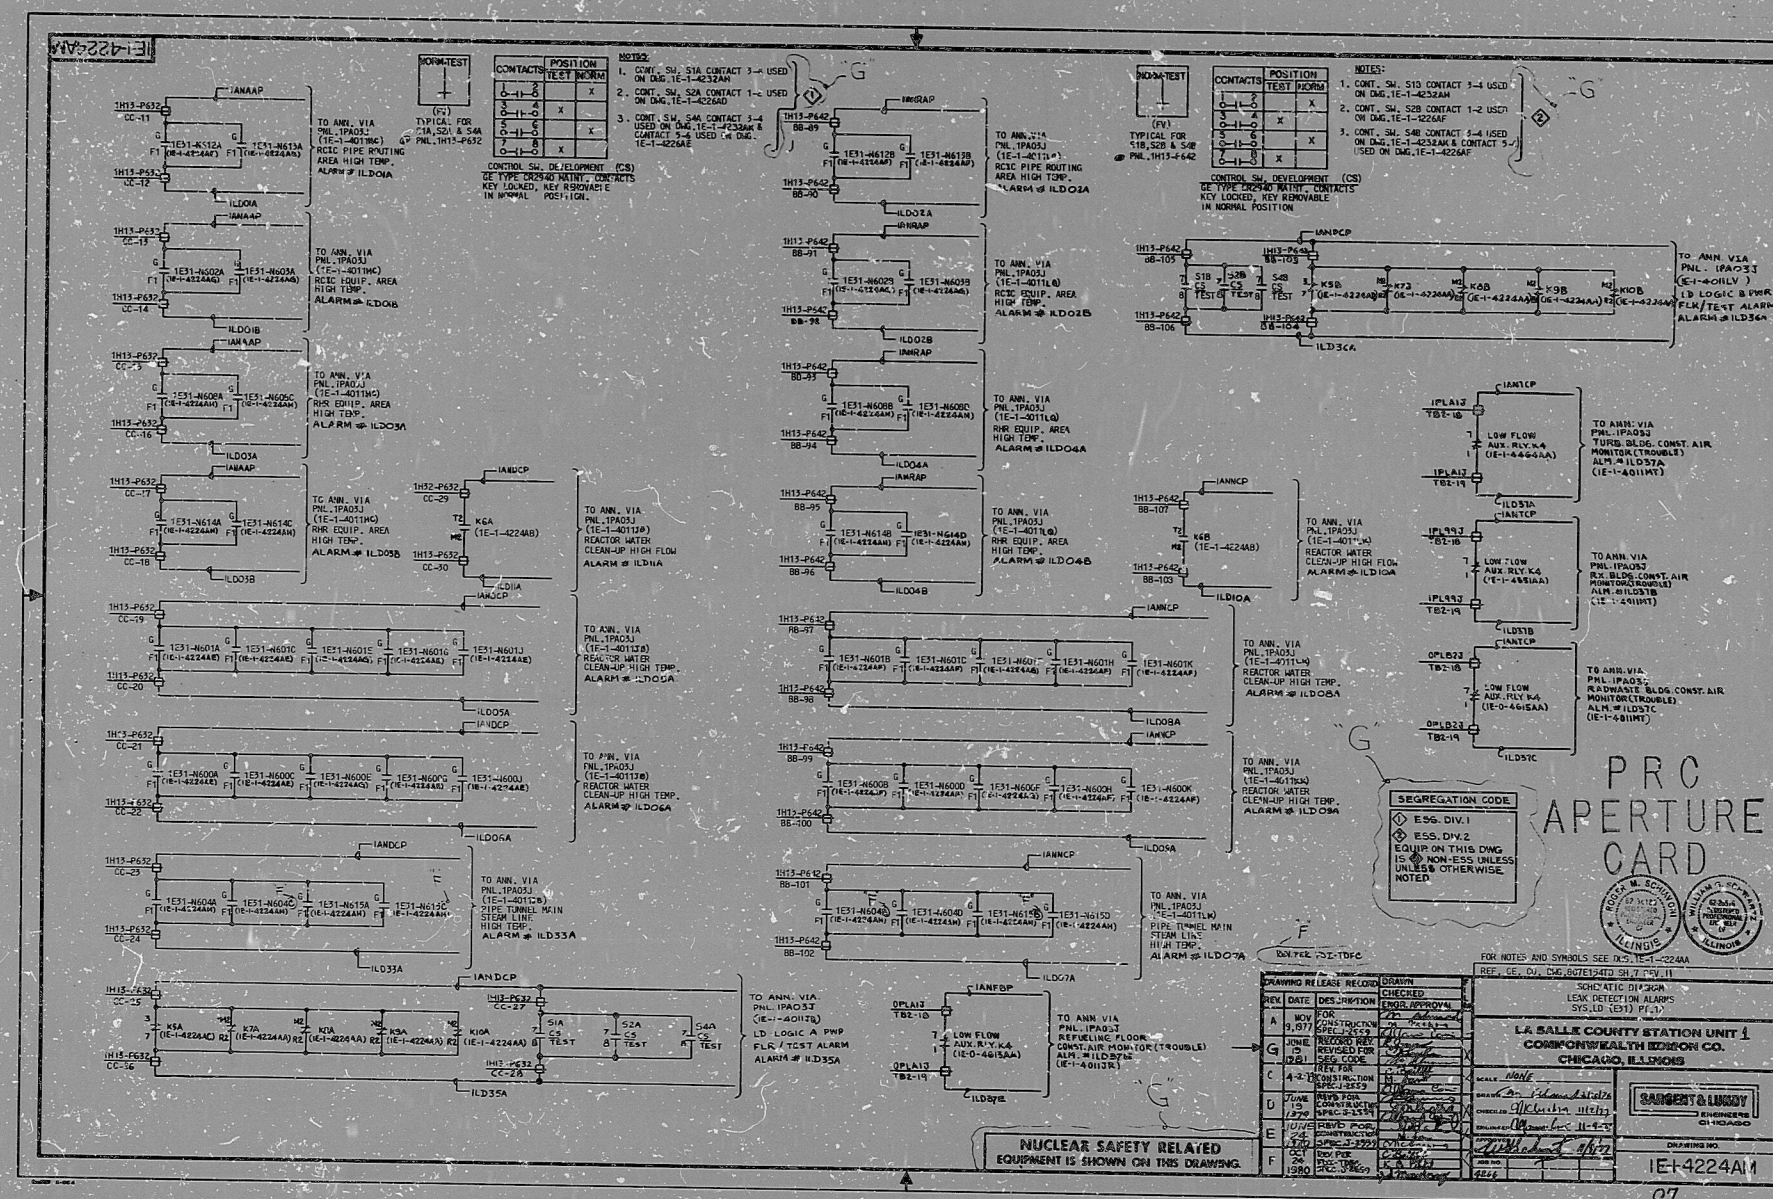