SYSTEM #1
UNDERFLOOR

CONTROL ROOM

SMOKE DETECTORS (TYPICAL)

PIPE APPROX 6" BELOW RAISED FL.

SYSTEM #1
UNDERFLOOR NOZZLE LAYOUT

SPRAY NOZZLE (TYP.)

SMOKE DETECTORS (TYPICAL)

PIPE APPROX. 14'-8" ABOVE FLOOR

CONTROL ROOM

HALON SUPPLY

PIPE APPROX. 15'-8" ABOVE FLOOR

SMOKE DETECTORS (TYPICAL)

HALON SUPPLY

MANUAL ACTUATORS — CO2 BOTTLES (TYP.)

CONTROL CABINET

NITR. BOTTLE

HALON 1301 BOTTLE (TYP.)

(INITIAL) (EXTENDED)

SYSTEM #2
AREA: B-C, 4-5

SYSTEM #2

SYSTEM #3

PILOT HEAD

CONTROL CABINET

NITR. BOTTLE

DIP TUBE (TYP.)

(INITIAL) (EXTENDED)

SYSTEM #3
(AREA: A-C, 5-5.9)

ABANDONED IN PLACE NOT USED

BATTERY CHARGER

POWER FAILURE RELAY

120 VAC.

24 V.D.C.

D12

C193

D10

HALON POWER SUPPLY

C194 SYS.#3
C463 C195 SYS.#2
C196 SYS.#1

FLOOR PLAN
ABOVE CEILING NOZZLE LAYOUT

NOTES :

1) ALL CONTROL CABINETS, HALON CYLINDERS, CO_2 BOTTLES, INSTRUMENTS, NOZZLES AND BATTERIES SUPPLIED BY CARDOX DIVISION OF CHEMTRON CORP. PER SPEC. M-79.

2) PIPING IS SCHEDULE 40 BLACK OR GALVANIZED STEEL PIPE, ASTM A-53, WITH 300 LB. IRON OR FORGED STEEL FITTINGS, INSTALLED BY GRINNELL CORP.

3) HALON SPRAY NOZZLES ARE (31) 1/4" RADIAL W/.073 DRILL DIAM., (32) 1/4" RADIAL W/.067, (33) 1/4" ORIFICE CODE 1.3, (34) 1/2" RADIAL W/.228, (35) 1/2" RADIAL W/.250, (36) 3/4" RADIAL W/.266, (37) 3/4" RADIAL W/.250, (38) 3/4" RADIAL W/.246, (39) 1/4" ORIFICE CODE 1.8, (40) 1/2" RADIAL W/.272.

4) REFERENCE ELECTRICAL DRWG. E-421, E-582 SH22 E471-3,7,8 AND 12.

PRC APERTURE CARD

NO.	DATE	REVISIONS	BY	CHK'D	MECH. ENG'R	PROJ. ENG'R	QUAL. ENG'R
2	11/1/76	AS BUILT ISSUED TO APPL	JS				
1	7/15/76	AS BUILT PER DCN 6586 & 2866	JS				

SCALE: 1/4"=1'-0" | DESIGNED: J. GRILL | DRAWN: N. SEELA

BECHTEL CORPORATION
SAN FRANCISCO

ARKANSAS POWER & LIGHT COMPANY
ARKANSAS NUCLEAR ONE
UNIT 1

PIPING & INSTRUMENT DIAGRAM
HALON FIRE SYSTEM

8206110273

JOB NO. 6600-1 | DRAWING NO. M-219 | SH. 2 OF 3 | REV. 2

RIDS

8206110273

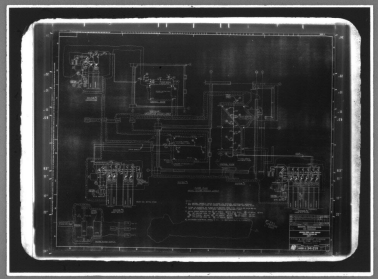

M•M 5824 FILMSORT® Brand Aperture & Camera Cards and DUPLICARD® Brand Copy Cards — Product of 3M Company, St. Paul, Minn.